IREDELL COUNTY HEALTH DEPARTMENT

Statesville Office (704) 878-5305 Mooresville Office (704) 660-3625 PERMIT # 210524

IMPROVEMENT PERMIT / AUTHORIZATION TO CONSTRUCT / OPERATION PERMIT / EXISTING SYSTEM

PIN # 4616-80-9046

APPLICANT: RAY SHORT APPLICANT ADDRESS: PO BOX 3792 MOORESVILLE 28117

SITE ADDRESS: 410 & 2 BARBER LOOP PHONE: 704-578-4951 ALT. PHONE:

SITE DIRECTIONS: BSR, CHUCKWOOD, TL BARBER, ON R

SUBDIVISION: WATERTREE LANDING SECTION: 3 LOT # 50 LOT AREA: .88 AC DESIGN FLOW: 480 L.T.A.R.: .35 (.25R)

Septic Tank	1000 (gal)	STB	825	Date	8-18-15	☒ New System ☐ Repair ☐ Expansion	System Type: I II III (IV) V VI	☒ Residence	No. Bedrooms 4
Pump Tank	1000 (gal)	PT	502	Date	8-11-15	System Description:	LP PANEL BLOCK	☐ Business	No. Persons
Pump Make	ZOELLER	Model	N152	Serial #		Repair System Description:	SAME	☐ Other	No. Employees
# Nitrification Fields	1	# Lines	4	Linear Ft:	229'	Maintenance Agreement Required:	☒ YES ☐ NO	☐ Slab	☒ Crawl Space
Trench Width	24"	Max. Trench Bottom Depth	36"	Gravel Depth			☐ GRAVITY ☒ PRESSURE	☐ Basement w/plumbing	☐ Basement w/o plumbing

Water Supply: ☒ Private ☐ Public ☐ Community

Comments / Conditions: SET 3' PH, CHECKED LINES, TANKS.

INITIAL SITE SKETCH

SEE PLAN FROM THE OAKS GROUP

AS BUILT SKETCH

Permit can be suspended or revoked if any false information is supplied toward securing the permit / any unauthorized changes are made to the site / any unauthorized changes are made in the installation of the system. **CONTACT A LOCATOR SERVICE PRIOR TO ANY EXCAVATION**


☐ **IMPROVEMENT PERMIT** *with plat valid without expiration.* ☒ **IMPROVEMENT PERMIT** *with site plan valid for 60 mos.* ☐ **AUTHORIZATION TO CONSTRUCT** *valid for period equal to IMPROVEMENT PERMIT--not to exceed 60 mo.*

Owner / Applicant Signature: Kathleen Saunders Date: 8/25/15 Installed by: Rowan Septic

IMPROVEMENT PERMIT by: APPROVED AUG 19 2015 Date: OPERATION PERMIT by: Maria Dobson RS Date: ?/2015

AUTHORIZATION TO CONSTRUCT by: APPROVED AUG 19 2015 Date: Existing System Inspected by: Date:

Health Dept. Copy - WHITE Applicant (Final Approval) - YELLOW Applicant (Conditional Approval) - PINK

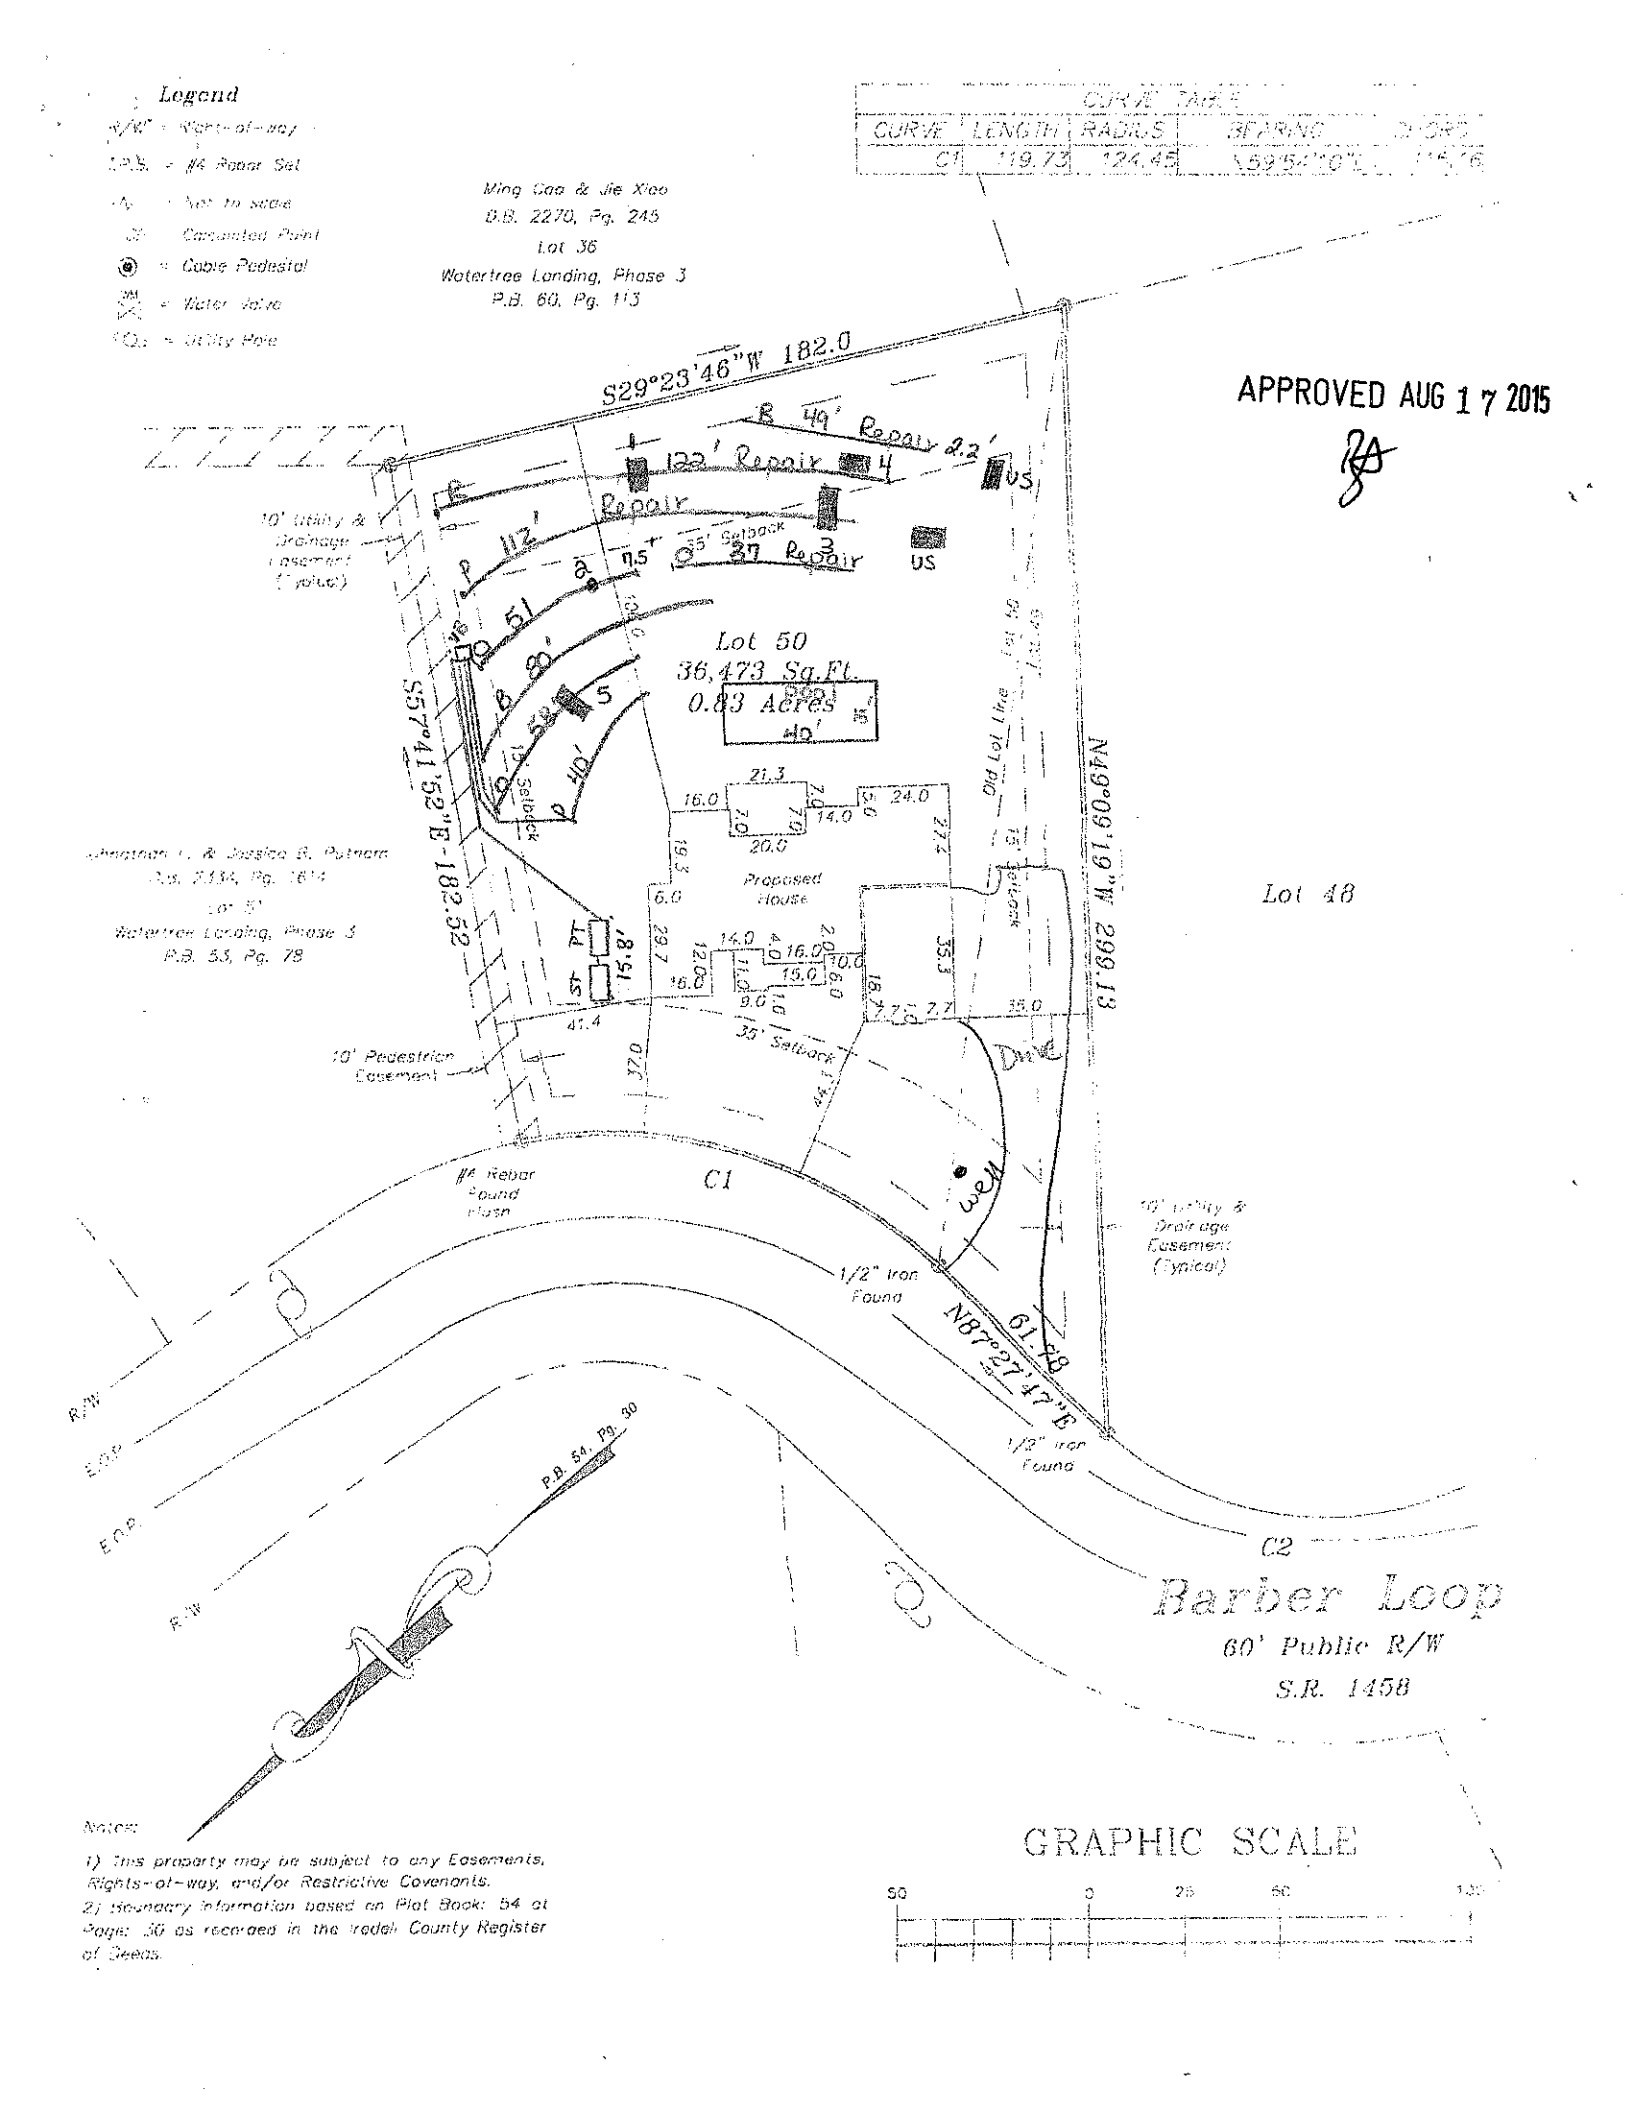

Notes:

1) This property may be subject to any Easements, Rights-of-way, and/or Restrictive Covenants.
2) Hereinary information based on Plat Book: 54 at Page: 30 as recorded in the Iredell County Register of Deeds.