4616900386

IREDELL COUNTY HEALTH DEPARTMENT

STATESVILLE 704-878-5305 MOORESVILLE 704-664-5281

IMPROVEMENT PERMIT / AUTHORIZATION TO CONSTRUCT / OPERATION PERMIT / EXISTING SYSTEM INSPECTION

PERMIT # 147150 PIN # 4616111524.052 DATE 2-6-2009

OWNER or APPLICANT Mid Atlantic Custom Bld PHONE: Business 828 478-2761 Home:

OWNER or APPLICANT ADDRESS P.O. Box 3792 Mooresville, NC 28117

LOCATION / DIRECTIONS Brawley School Rd TR Chuckwood TL Barber loop on Rt.

SUBDIVISION Watertree Landing BLOCK / SECTION LOT # 52 LOT AREA 30,935 sf DESIGN FLOW 480 gpd L.T.A.R. 3

Septic Tank 1000 Gallons: STB 794 Date 2/9/09

Pump Tank Gallons: P T Date

Pump Make Model Serial #

Nitrification Field No Fields 1 No Lines 6 Linear Feet 420 ft.

Trench Width 36" Max. Trench Bottom Depth 36" Gravel Depth N/A

☒ New System ☐ Repair ☐ Expansion System Type I II III IV V VI

System Description: Gravity - 25% Reduction

Repair System Description: Pump - Panel Blk

Maintenance Agreement Required ☐ YES ☒ NO

☒ GRAVITY ☐ PRESSURE


☒ Residence No. Bedrooms 4 ☐ Business No. Persons ☐ Other No. Employees ☐ Slab ☐ Crawl Space ☐ Basement w/plumbing ☐ Basement w/o plumbing

Water Supply: ☒ Private ☐ Public ☐ Community

Comments / Conditions

Scale 1:40

INITIAL SITE SKETCH

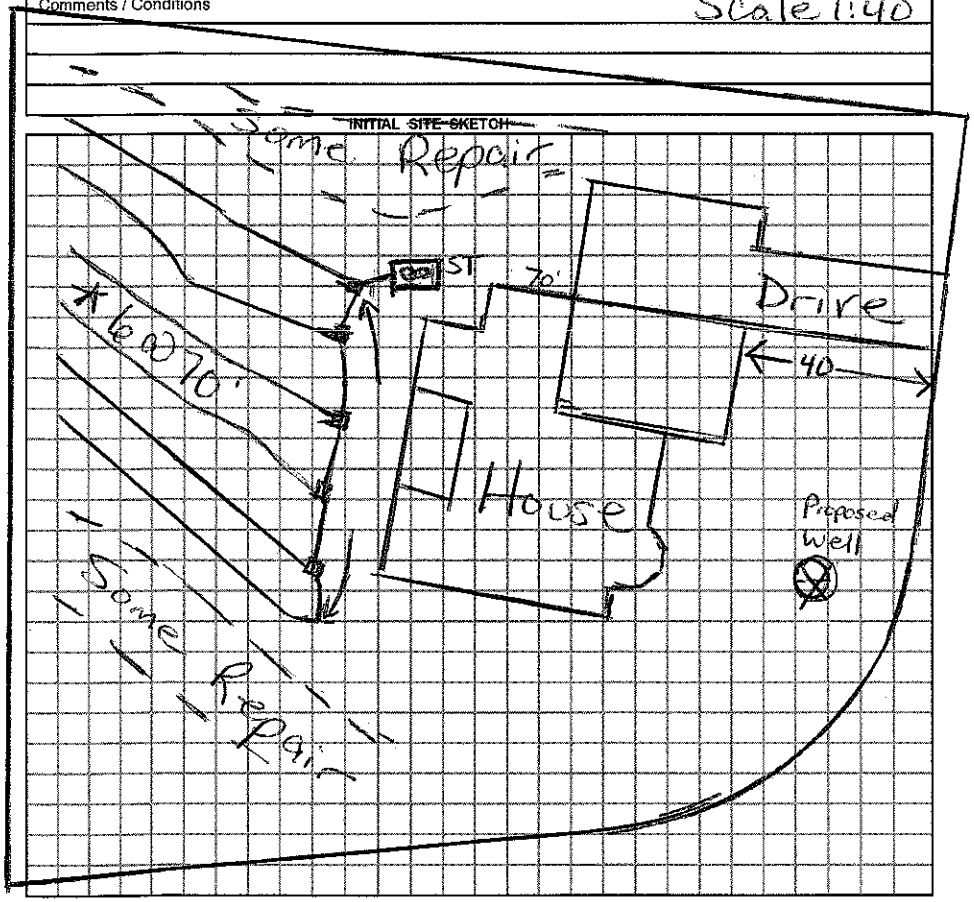

Comments / Conditions

☒ Per proposed plan 6 lines 70ft ea. See Attached "Revised" plan by Rollins Soil & Env. Services

AS BUILT SKETCH

lines connected and to end, no dips observed.

Permit can be suspended or revoked if any false information is supplied toward securing the permit / any unauthorized changes are made to the site / any unauthorized changes are made in the installation of the system.

☐ *IMPROVEMENT PERMIT w / plat valid without expiration.* ☐ *IMPROVEMENT PERMIT w / site plan valid for 60 mos.* ☐ *AUTHORIZATION TO CONSTRUCT valid for period equal to IMPROVEMENT PERMIT-not to exceed 60 mo.*

Owner / Applicant Signature: Date 2/10/09

Improvement Permit by: RS Date 2/6/09

Authorization to Construct by: RS Date 2/6/09

Installed by: Russell Williams

Operation Permit by: Wesley Sparks RS. Date: 9/14/09

Existing System Inspected by: Date:

YOU SHOULD CONTACT A LOCATOR SERVICE PRIOR TO ANY EXCAVATION.

WHITE COPY Environmental Health YELLOW COPY (Final) Owner / Applicant PINK COPY (Initial) Owner / Applicant