4616901588 ~~4616001588~~

IREDELL COUNTY HEALTH DEPARTMENT

STATESVILLE 704-878-5305 MOORESVILLE 704-664-5281

IMPROVEMENT PERMIT / AUTHORIZATION TO CONSTRUCT / OPERATION PERMIT / EXISTING SYSTEM INSPECTION

PERMIT# 083969 PIN# 4616901588 DATE 5-10-2000

OWNER OR CONTRACTOR Robert Auten PHONE: Business Home 663-0946

ADDRESS 493 Barber Loop

LOCATION Brawley School Rd TR Chuckwood TL Barber Loop ½ mile on right

SUBDIVISION CL&J BLOCK / SECTION 7 LOT 90 LOT AREA SITE CLASS. DESIGN FLOW 360gpd L.T.A.R.

Septic Tank: Existing Gallons; STB Date

Pump Tank: Gallons; PT Date

Pump Make: Model Serial No.

Nitrification Field: No Fields Square Feet Linear Feet

No Lines Trench Width 1ST Max Trench Bottom Depth Gravel Depth

☐ New System ☐ Repair System Type: I, II, III, IV, V, VI

System Description: Existing Gravity Conventional

Repair System Description: Pump-Innovative

Maintenance Agreement Required: ☐ Yes ☒ No

☒ House/Mod. Home No. Bedrooms 3

☐ Mobile Home No. Bathrooms

☐ Business No. Employees

☐ Other

☐ Slab ☐ Crawl Space ☒ Basement w/plumbing ☐ Basement wo/plumbing


Water Supply: ☒ Individual ☐ Public ☐ Community

Comments/Conditions: Existing Septic System appears to be Functioning Okay. No problems Noticed. Keep New home at least 5' from Septic System

Comments/Conditions: Septic System originally installed 1975.

★ Not to Scale

INITIAL SITE SKETCH

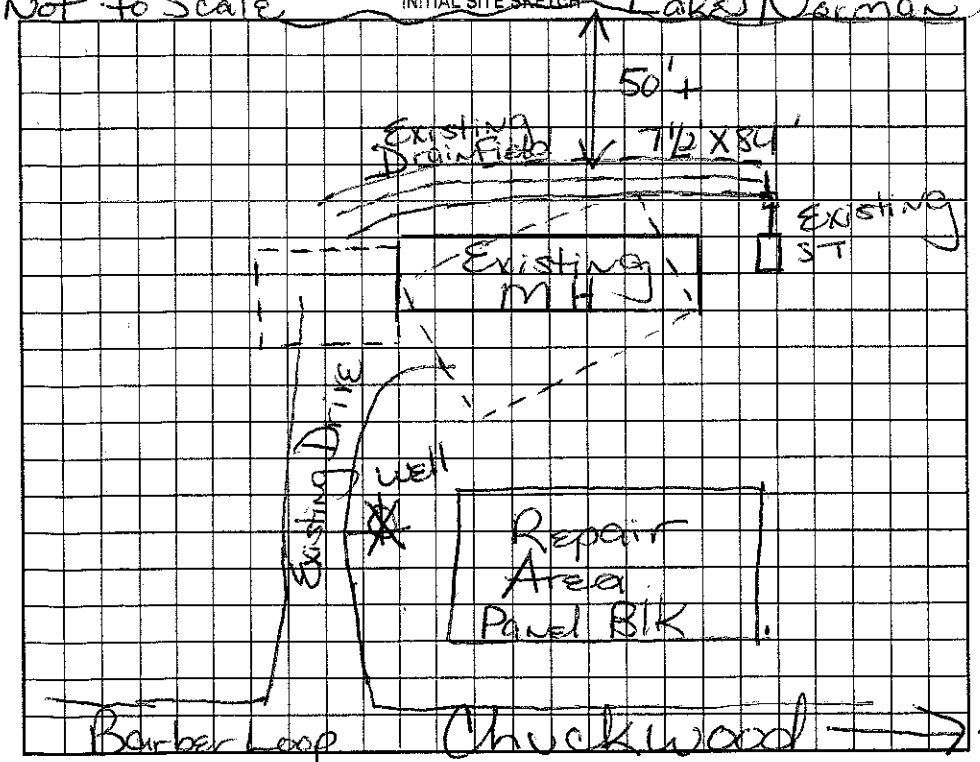

AS BUILT SKETCH

Permit can be suspended or revoked if any false information is supplied toward securing the permit/any unauthorized changes are made to the site/any unauthorized changes are made in the installation of the system. Improvement Permit with plat valid without expiration. Improvement Permit with site plan valid for sixty months. Authorization to Construct is valid for a period equal to that of Improvement Permit – not to exceed sixty months.

Signed: date Installed by:

Improvement Permit by: Marie H. Dotson R.S. date 5/10/2000 Operation Permit by: date

Authorization to Construct by: date Existing System Inspection by: Marie H. Dotson R.S. date 5/10/2000

HEALTH DEPT. COPY: WHITE OWNER COPY (FINAL): YELLOW OWNER COPY (INITIAL): PINK