4616907099

IREDELL COUNTY HEALTH DEPARTMENT

STATESVILLE 704-878-5305 MOORESVILLE 704-664-5281

IMPROVEMENT PERMIT / CERTIFICATE OF COMPLETION / OPERATION PERMIT / EXISTING SYSTEM INSPECTION

PROPERTY DESCRIPTION NO. 24217 DATE 7/19/96 TAX MAP NO. 2E-1-A-114 Watershed: ☑ Yes ☐ No

OWNER OR CONTRACTOR Harold Huffman PHONE: Business _____ Home 871-0776

ADDRESS 2421 East Broad St. Statesville NC

LOCATION Brawley School - TR Chestnutwood - TL Barber Loop - #325 Barber Loop

SUBDIVISION CLOFT BLOCK / SECTION 7 LOT 114 LOT AREA _____ SITE CLASS PS DESIGN FLOW 360gpd L.T.A.R. existing

Septic Tank: existing Gallons; STB _____ Date _____

Pump Tank: _____ Gallons; PT _____ Date _____

Pump Make: _____ Model _____ Serial No. _____

Nitrification Field: No Fields 1 Square Feet 300 Linear Feet 60

No Lines Bed Trench Width 10' Max Trench Bottom Depth ± Gravel Depth —

☑ New System ☐ Repair System Type: I, II, III, IV, V, VI

System Description: Gravity Bed

Repair System Description: _____

Maintenance Agreement Required: ☐ Yes ☑ No

☑ House/Mod. Home No. Bedrooms 3

☐ Mobile Home No. Bathrooms 2

☐ Business No. Employees _____

☐ Other _____

☐ Slab ☑ Crawl Space ☐ Basement w/plumbing ☐ Basement wo/plumbing


Water Supply: ☑ Individual ☐ Community ☐ Public

Comments:

Comments: Old Mobile Home is to be removed. Pump system may have to be installed if gravity can not be achieved

INITIAL SITE SKETCH

AS BUILT SKETCH

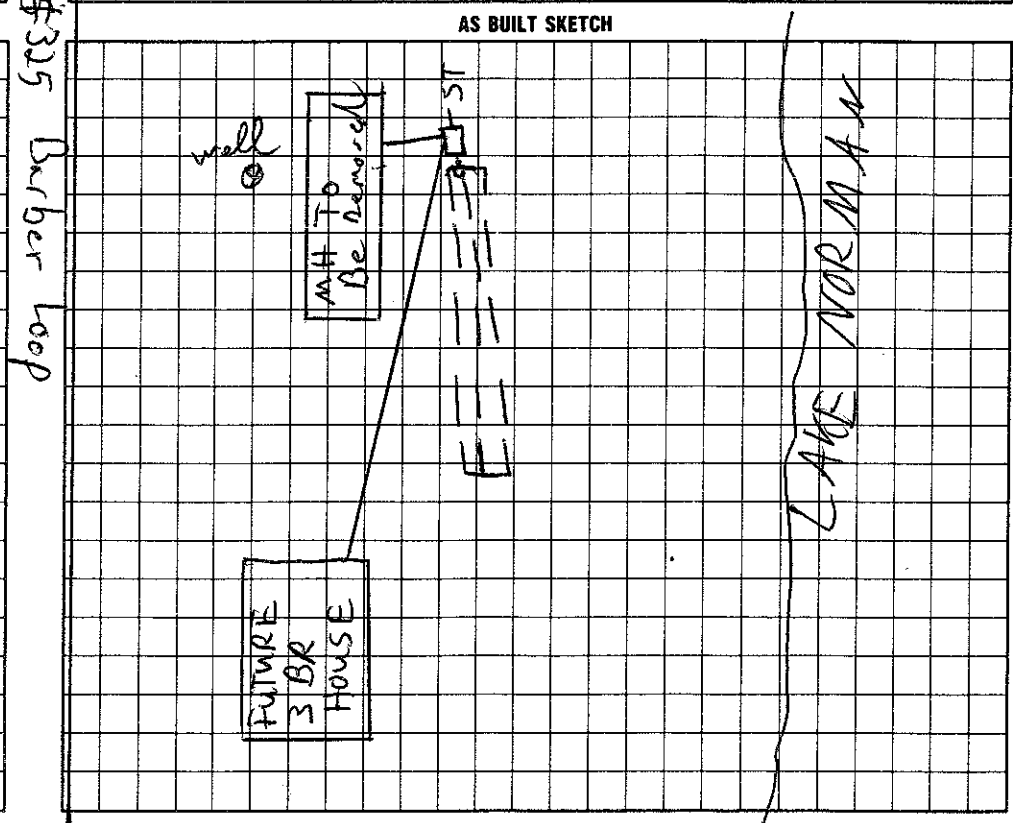

I understand that this permit can be suspended or revoked if any false information is supplied toward securing the permit/any unauthorized changes are made to the site/any unauthorized changes are made in the installation of the system.

Signed: Harold L Huffman

Improvement Permit by: _____ date _____

Existing System Inspection by: C. Bradshaw EHSI date 7/19/96

Installed by: _____

Certificate of Completion by: _____ date _____

Operation Permit by: C. Bradshaw EHSI date 7/19/96

HEALTH DEPT. COPY: WHITE INSPECTION COPY (FINAL): GREEN OWNER COPY (FINAL): YELLOW INSPECTION COPY (INITIAL): PINK OWNER COPY (INITIAL): GOLD