4616908326

IREDELL COUNTY HEALTH DEPARTMENT

STATESVILLE 704-878-5305 MOORESVILLE 704-664-5281

IMPROVEMENT PERMIT / AUTHORIZATION TO CONSTRUCT / OPERATION PERMIT / EXISTING SYSTEM INSPECTION

PERMIT # 14706 7/14706 5 PIN # ~~4616~~ 4616908395 DATE 7-19-2010

OWNER or APPLICANT Lake Luxury PHONE: Business 704 202-1266 Home:

OWNER or APPLICANT ADDRESS P.O. Box 3792 Mooresville, NC 28117

LOCATION / DIRECTIONS Brawley School Rd TR Chuckwood TL 1st Barber Lp. property on RT

SUBDIVISION Watertree Landing BLOCK / SECTION ~~31&32~~ LOT # 31&32 LOT AREA ____ DESIGN FLOW 600 L.T.A.R. .3

Septic Tank 1500 Gallons: STB ~~1428~~ Date 10-26-08

Pump Tank 1500 Gallons: PT ~~1485~~ 1485 Date 1-7-08

Pump Make Goulds Model PE5TM Serial # ____

Nitrification Field No Fields ____ No Lines 5 Linear Feet 500

Trench Width 36" Max. Trench Bottom Depth 36" Gravel Depth ~~N/A~~

☒ New System ☐ Repair ☐ Expansion System Type I II III IV V VI

System Description: Pump-PM-25% Reduction

Repair System Description: Pump-25-50% Reduction

Maintenance Agreement Required ☐ YES ☒ NO

☐ GRAVITY ☒ PRESSURE

☒ Residence No. Bedrooms 5

☐ Business No. Persons ____

☐ Other No. Employees ____

☐ Slab ☐ Crawl Space


☐ Basement w/plumbing ☐ Basement w/o plumbing

Water Supply: ☒ Private ☐ Public ☐ Community


Comments / Conditions Lots 31&32 combined for 1 lot
Tanks & lines installed 6/29/10 for 4 Bedroom.
Walk thru of house 7/9/10 Found 5 Bedrooms

Comments / Conditions Upgrade Septic to 5 Bedrooms
Change tanks to 1500gal & add 100 ft of Drainfield for 2-50ft lines with Flow Divider. Must keep Drainline

INITIAL SITE SKETCH

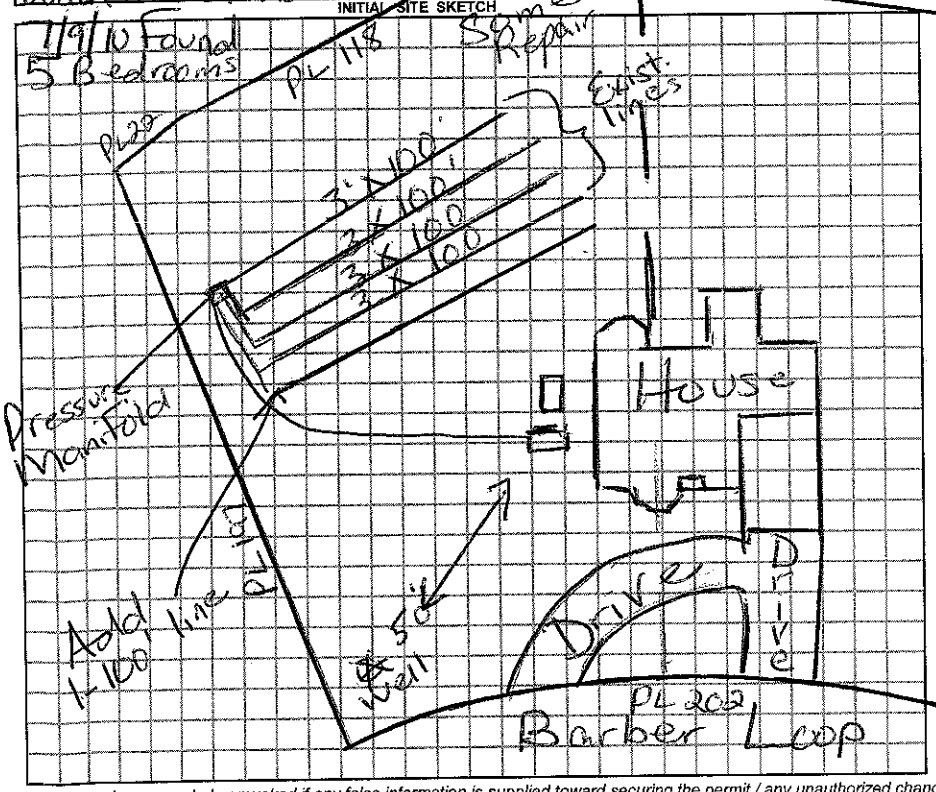

AS BUILT SKETCH

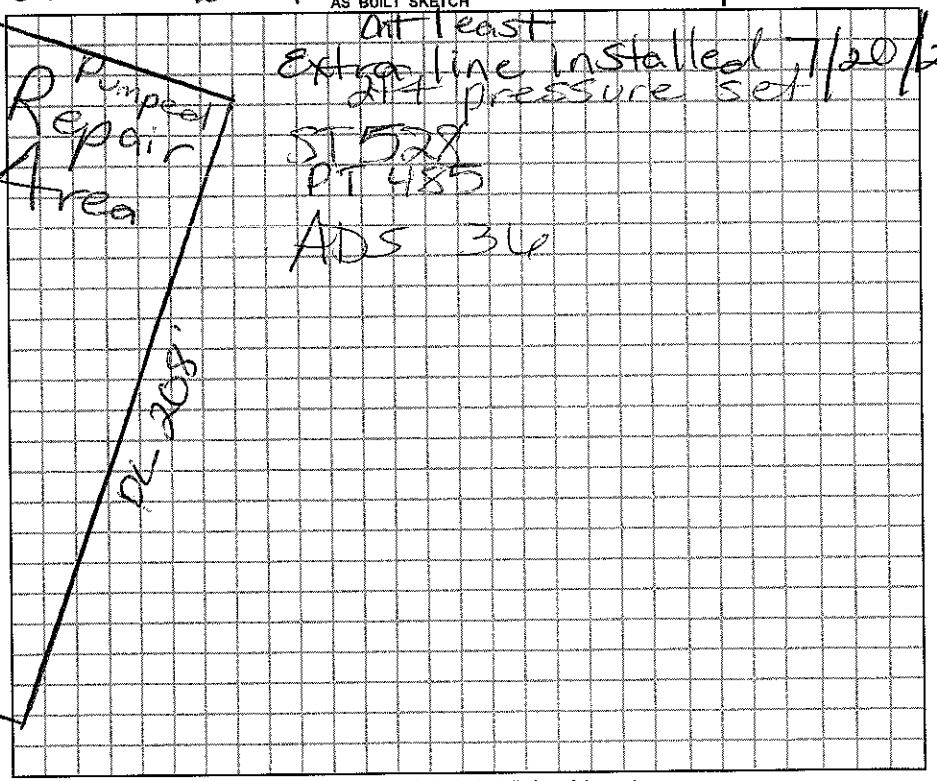

Permit can be suspended or revoked if any false information is supplied toward securing the permit / any unauthorized changes are made to the site / any unauthorized changes are made in the installation of the system.

☐ IMPROVEMENT PERMIT w / plat valid without expiration ☐ IMPROVEMENT PERMIT w / site plan valid for 60 mos. ☐ AUTHORIZATION TO CONSTRUCT valid for period equal to IMPROVEMENT PERMIT-not to exceed 60 mo.

Owner / Applicant Signature: X ____ Date 7/20/10

Improvement Permit by: ____ RS Date 7/19/2010

Authorization to Construct by: ____ RS Date 7/19/2010

Installed by: Gunter

Operation Permit by: ____ Date: 7/21/2010

Existing System Inspected by: ____ Date: ____

YOU SHOULD CONTACT A LOCATOR SERVICE PRIOR TO ANY EXCAVATION.

WHITE COPY Environmental Health YELLOW COPY (Final) Owner / Applicant PINK COPY (Initial) Owner / Applicant