IREDELL COUNTY HEALTH DEPARTMENT

Statesville Office (704) 878-5305 Mooresville Office (704) 660-3625 PERMIT # 1762116

IMPROVEMENT PERMIT / AUTHORIZATION TO CONSTRUCT / OPERATION PERMIT / EXISTING SYSTEM

PIN # 4616-90-9297

APPLICANT: LAKE LUXURY HOMES APPLICANT ADDRESS: Po Box 3792 MOORESVILLE 28117

SITE ADDRESS: 326 BARBER LOOP PHONE: 704-516-2344 ALT. PHONE:

SITE DIRECTIONS: BSR, CHUCKWOOD, 1ST BARBER LOOP, ON R


SUBDIVISION: WATERTREE LANDING SECTION: LOT # 82 LOT AREA: .68 AC DESIGN FLOW: 480 L.T.A.R.: .3

Septic Tank	1000 (gal)	STB	825	Date	8-22-13	☒ New System	☐ Repair	☐ Expansion	System Type: I II ☒ III-B IV V VI	☒ Residence	No. Bedrooms 4
Pump Tank	1000 (gal)	PT	302	Date	4-11-13	System Description:			PM - 75% RED.	☐ Business	No. Persons
Pump Make		Model		Serial #		Repair System Description:			PANEL BLOCK	☐ Other	No. Employees
# Nitrification Fields	1	# Lines	4@100'	Linear Ft:	400	Maintenance Agreement Required:		☐ YES	☒ NO	☐ Slab	☒ Crawl Space
Trench Width	36"	Max. Trench Bottom Depth	* 24"	Gravel Depth	—			☐ GRAVITY	☒ PRESSURE	☐ Basement w/plumbing	☐ Basement w/o plumbing

Water Supply: ☒ Private ☐ Public ☐ Community

Comments / Conditions:

INITIAL SITE SKETCH

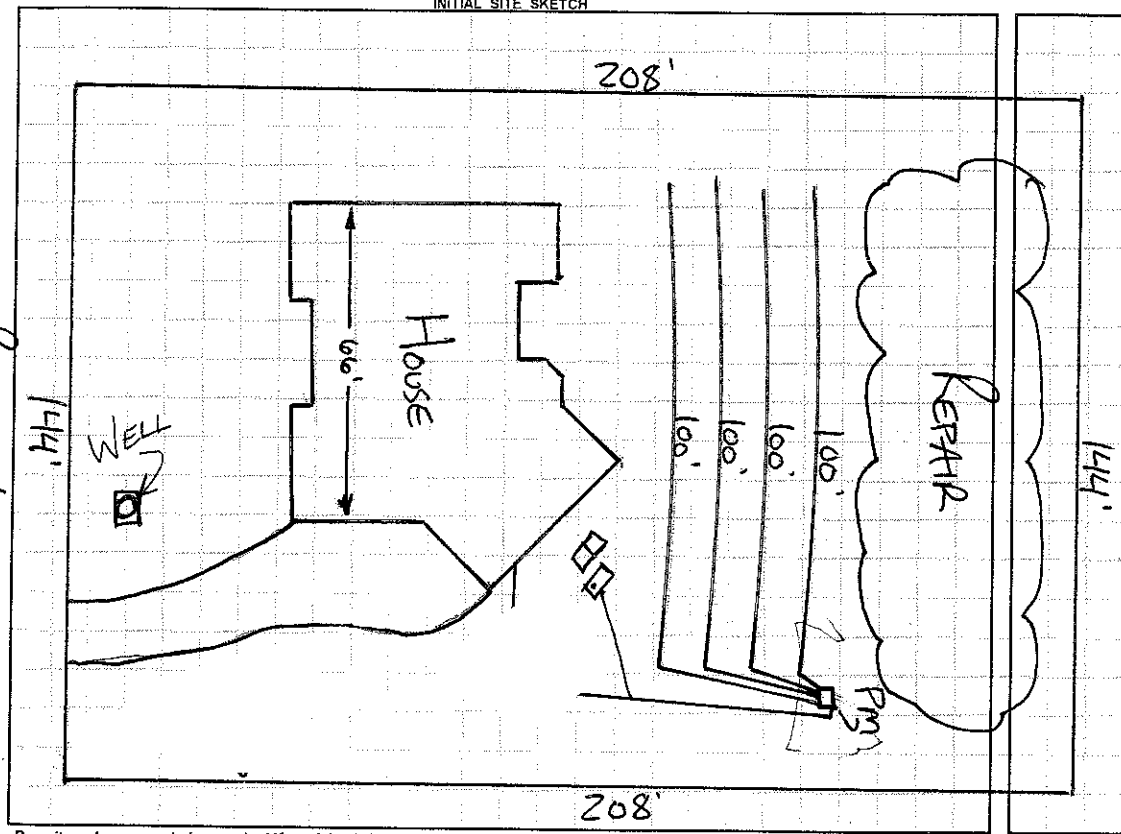

AS BUILT SKETCH

1"=40'

CHECKED TANKS & LINES SET 2' PH 10-9-13 BA

CHECKED BREAKERS BA 12-4-13

Permit can be suspended or revoked if any false information is supplied toward securing the permit / any unauthorized changes are made to the site / any unauthorized changes are made in the installation of the system. **CONTACT A LOCATOR SERVICE PRIOR TO ANY EXCAVATION**

☐ **IMPROVEMENT PERMIT** *with plat valid without expiration.* ☒ **IMPROVEMENT PERMIT** *with site plan valid for 60 mos.* ☒ **AUTHORIZATION TO CONSTRUCT** *valid for period equal to IMPROVEMENT PERMIT--not to exceed 60 mo.*

Owner / Applicant Signature: Date: 3-27-13 Installed by: ROWAN SEPTIC

IMPROVEMENT PERMIT by: Date: 3-27-13 OPERATION PERMIT by: Date: 12-4-13

AUTHORIZATION TO CONSTRUCT by: Date: 3-27-13 Existing System Inspected by: Date:

Health Dept. Copy - WHITE Applicant (Final Approval) - YELLOW Applicant (Conditional Approval) - PINK