IREDELL COUNTY HEALTH DEPARTMENT

Statesville Office (704) 878-5305 Mooresville Office (704) 660-3625 PERMIT # 203882

IMPROVEMENT PERMIT / AUTHORIZATION TO CONSTRUCT / OPERATION PERMIT / EXISTING SYSTEM

PIN # 4616-91-3192

APPLICANT: TERESA MCMASTER APPLICANT ADDRESS: 129 LANDOVER LN.

SITE ADDRESS: SAME PHONE: 941-704-4159 ALT. PHONE:

SITE DIRECTIONS: BSR, TR CHUCKWOOD, TL BARBER LOOP, TR LANDOVER, ON L

SUBDIVISION: CLET SECTION: 7 LOT # 85 LOT AREA: .8AC DESIGN FLOW: 600 L.T.A.R.: .3

Septic Tank 1500 (gal) STB Date
Pump Tank (gal) PT Date
Pump Make Model Serial #
Nitrification Fields 1 # Lines 3C45' Linear Ft: 135'
Trench Width 24" Max. Trench Bottom Depth 36" Gravel Depth —

☐ New System ☐ Repair ☒ Expansion System Type: I II (III) IV V VI
System Description: PANEL BLOCK
Repair System Description: PANEL BLOCK
Maintenance Agreement Required: ☐ YES ☒ NO
☒ GRAVITY ☐ PRESSURE


☒ Residence No. Bedrooms 5
☐ Business No. Persons
☐ Other No. Employees
☐ Slab ☐ Crawl Space
☒ Basement w/plumbing ☐ Basement w/o plumbing

Water Supply: ☐ Private ☐ Public ☐ Community


Comments / Conditions: IF GRAVITY FLOW CAN BE ACHIEVED W/ EXISTING TANK, IT CAN BE USED INSTEAD OF INSTALLING A NEW ONE.

EXISTING TANKS USED

INITIAL SITE SKETCH

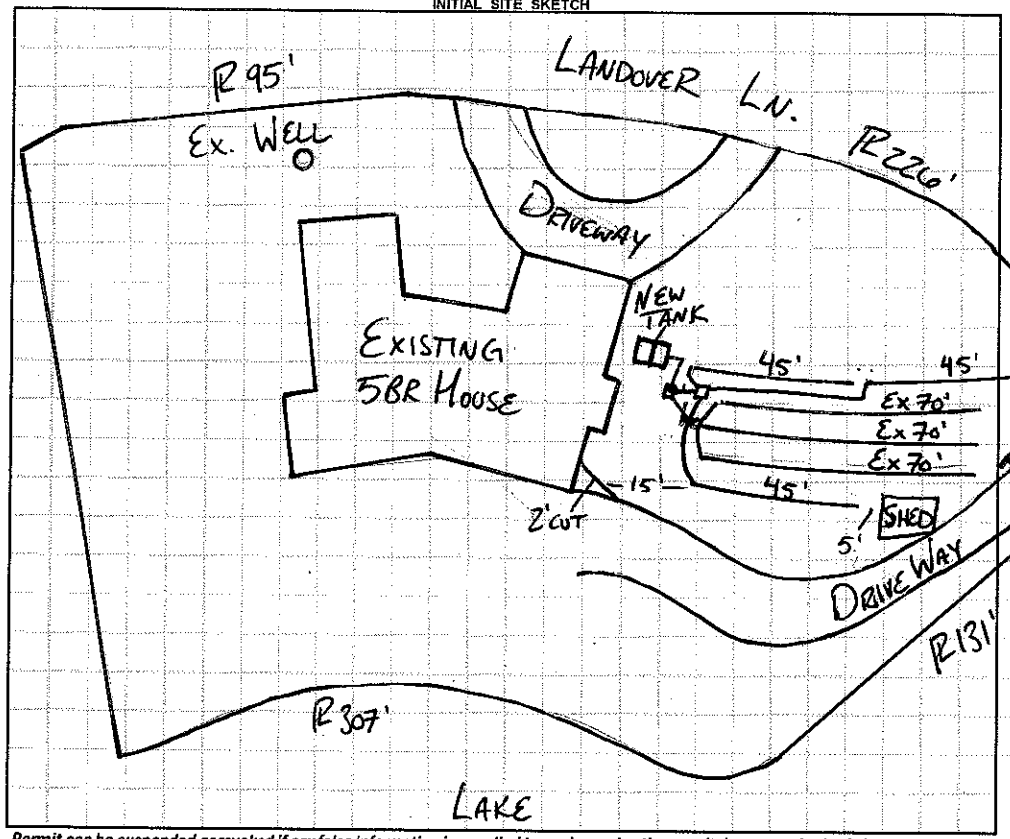

AS BUILT SKETCH

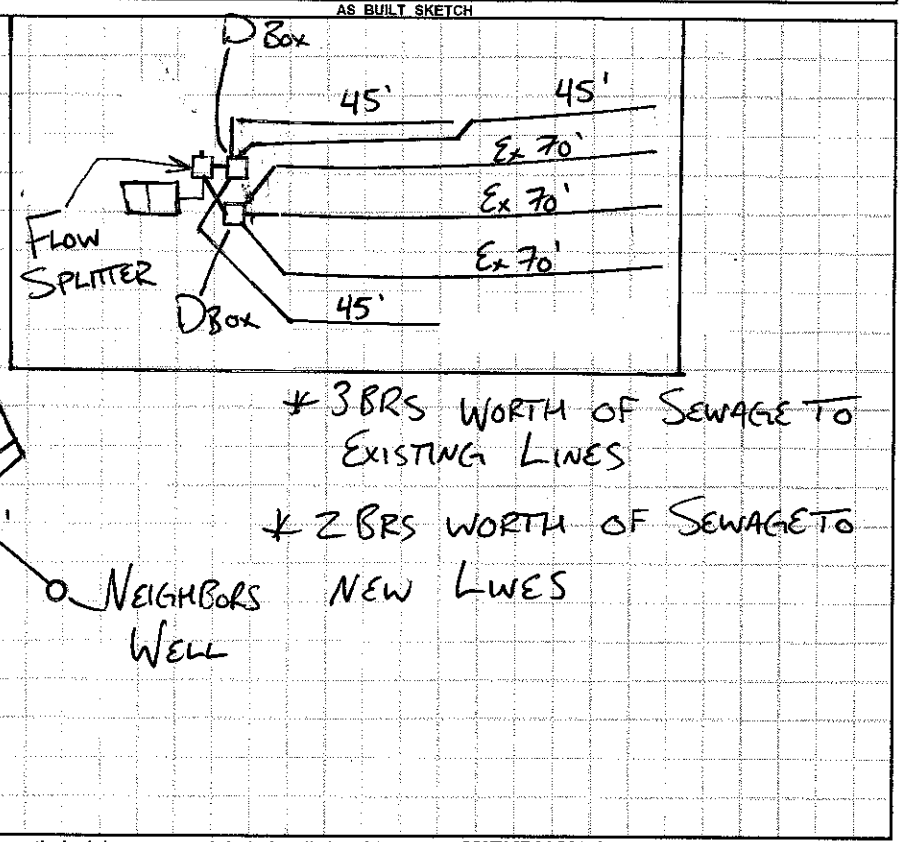

Permit can be suspended or revoked if any false information is supplied toward securing the permit / any unauthorized changes are made to the site / any unauthorized changes are made in the installation of the system. **CONTACT A LOCATOR SERVICE PRIOR TO ANY EXCAVATION**

☐ **IMPROVEMENT PERMIT** *with plat valid without expiration.* ☐ **IMPROVEMENT PERMIT** *with site plan valid for 60 mos.* ☒ **AUTHORIZATION TO CONSTRUCT** *valid for period equal to IMPROVEMENT PERMIT--not to exceed 60 mo.*

Owner / Applicant Signature: Date:

IMPROVEMENT PERMIT by: APPROVED Date: NOV 02 2015

AUTHORIZATION TO CONSTRUCT by: APPROVED Date: NOV 02 2015

Installed by: ABERNATHY

OPERATION PERMIT by: Date: 2-19-16

Existing System Inspected by: Date:

Health Dept. Copy - WHITE Applicant (Final Approval) - YELLOW Applicant (Conditional Approval) - PINK