525.00 Paid

IREDELL COUNTY HEALTH DEPARTMENT

TESVILLE 704-878-5305 MOORESVILLE 704-664-5281

IMPROVEMENT PERMIT / AUTHORIZATION TO CONSTRUCT / OPERATION PERMIT / EXISTING SYSTEM INSPECTION

PERMIT# 113043 PIN# 4616 -91- 4229 DATE 6/26/03

OWNER OR CONTRACTOR Steve Seeberg PHONE: Business 980-722-9555 Home

ADDRESS 107 Beachview Dr. Mooresville NC 28117

LOCATION BSR, TR Chuckwood, TL Bobwhite LP, TR Landover at end on Rt. #128

SUBDIVISION CLT BLOCK / SECTION 7 LOT 83 LOT AREA 0.67 AC SITE CLASS. PS DESIGN FLOW 480 L.T.A.R. 0.5

Septic Tank: 1000 Gallons; STB 1007 Date 9/9/06
Pump Tank: 1000 Gallons; PT 274 Date 9/16/06
Pump Make: Little Giant Model 9EH Serial No.
Nitrification Field; No Fields 1 Square Feet 810 Linear Feet 270
No Lines 4 Trench Width 24" Max Trench Bottom Depth 36" Gravel Depth —

☒ New System ☐ Repair System Type: I, II, III, IV, V, VI
System Description: LP Panel Block
Repair System Description: Same
Maintenance Agreement Required: ☒ Yes ☐ No

☒ House/Mod. Home No. Bedrooms 4
☐ Mobile Home No. Bathrooms 4
☐ Business No. Employees
☐ Other


Water Supply: ☒ Individual ☐ Public ☐ Community

☐ Slab ☒ Crawl Space ☒ Basement w/plumbing ☐ Basement wo/plumbing

Comments:/Conditions:

60' to Septic System
23' to pl
50'


INITIAL SITE SKETCH

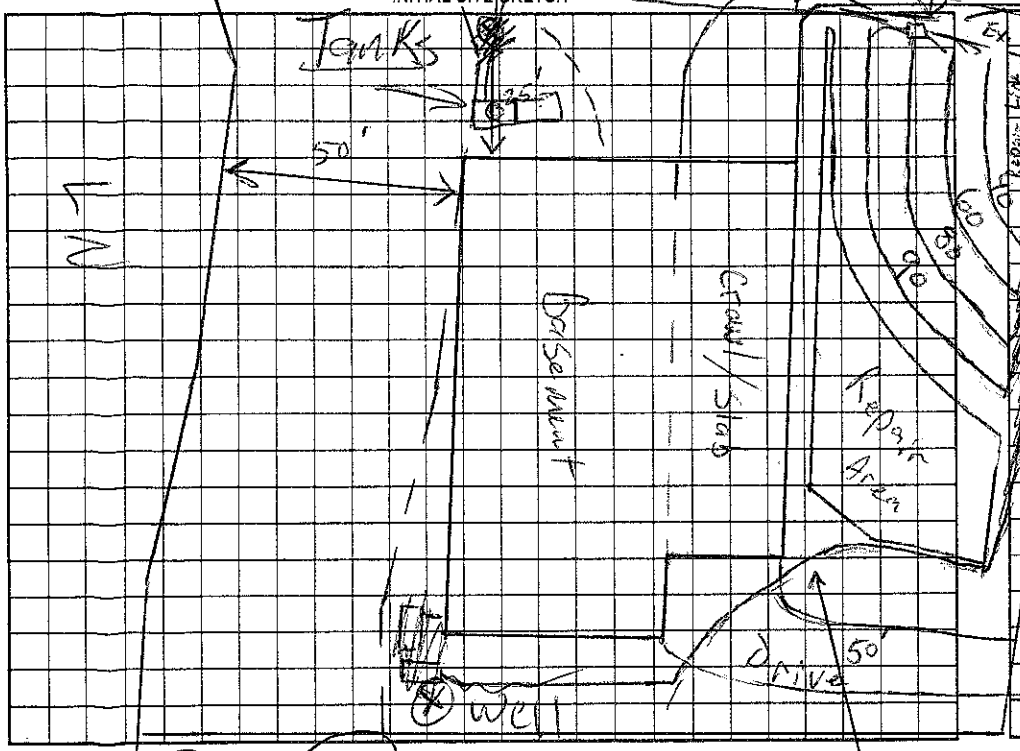

Comments:/Conditions: Partial Partial

Tanks a lines 6/29/06 GM
54 Panel 5/32" holes
Pressure, electo alarm 7/28/06

AS BUILT SKETCH

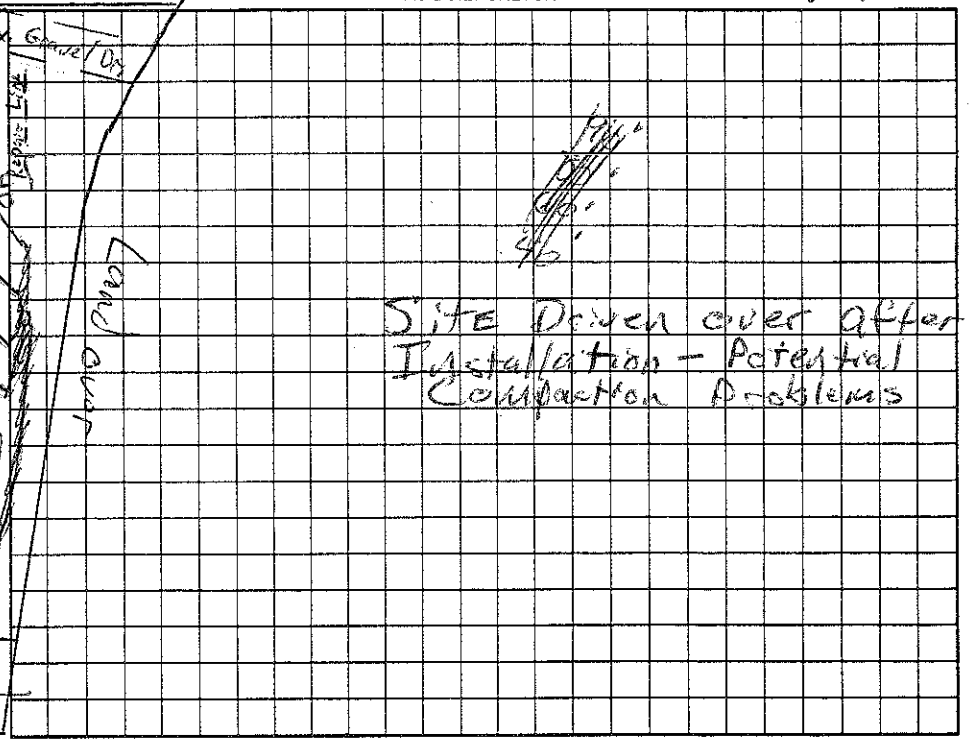

Permit can be suspended or revoked if any false information is supplied toward securing the permit/any unauthorized changes are made to the site/any unauthorized changes are made in the installation of the system. Improvement Permit with plat valid without expiration. Improvement Permit with site plan valid for sixty months. Authorization to Construct is valid for a period equal to that of Improvement Permit – not to exceed sixty months.

Signed: date 6/26/03

Improvement Permit by: RS date 6/26/03

Authorization to Construct by: RS date 6/17/04

Installed by: Abernathy date 7/28/06

Operation Permit by: RS

Existing System Inspection by: date

HEALTH DEPT. COPY: WHITE OWNER COPY (FINAL): YELLOW OWNER COPY (INITIAL): PINK