IREDELL COUNTY HEALTH DEPARTMENT

STATESVILLE 704-878-5305 MOORESVILLE 704-664-5281

IMPROVEMENT PERMIT / AUTHORIZATION TO CONSTRUCT / OPERATION PERMIT / EXISTING SYSTEM INSPECTION

PERMIT# 136158 PIN# 4679 91 5286 ~~4679 91 4229~~ 4679 91 5286 DATE 9/15/06

OWNER OR APPLICANT Tom Ogburn PHONE: Business 336 722 7564 Home

ADDRESS 3521 Buena Vista Rd. WS, NC. 27106

LOCATION 1100 TR Churchwood Tr Barbee Lp TR Landover Ln on (12) # 126

SUBDIVISION CL+T BLOCK / SECTION 7 LOT 83 LOT AREA ~1.04 SITE CLASS. PS DESIGN FLOW 480 L.T.A.R. .3

Septic Tank: 1000 Gallons; STB 312 Date 12/15/07

Pump Tank: 1000 Gallons; PT 283 Date 1/5/08

Pump Make: Goulds Model PROSTA Serial No.

Nitrification Field: No Fields 1 Square Feet 807 Linear Feet 269

No Lines 4 Trench Width 3' Max Trench Bottom Depth 3' Gravel Depth No

☐ New System ☐ Repair ☐ Expansion System Type: I II III (IV) V VI

System Description: LP - 16" PABRS

Repair System Description: SAME

Maintenance Agreement Required: ☒ Yes ☐ No

☒ House/Mod. Home ☐ Mobile Home ☐ Business ☐ Other

No. Bedrooms 4 No. Persons No. Employees


Water Supply: ☒ Individual ☐ Public ☐ Community

☐ Gravity ☒ Pressure ☐ Slab ☒ Crawl Space ☐ Basement w/plumbing ☐ Basement wo/plumbing

Comments/Conditions: 1 - Exist. well must be properly ABANDONED
2 - New Well location (3) Distribution must follow present route into lot - Very Tight


(1" = 50')

INITIAL SITE SKETCH

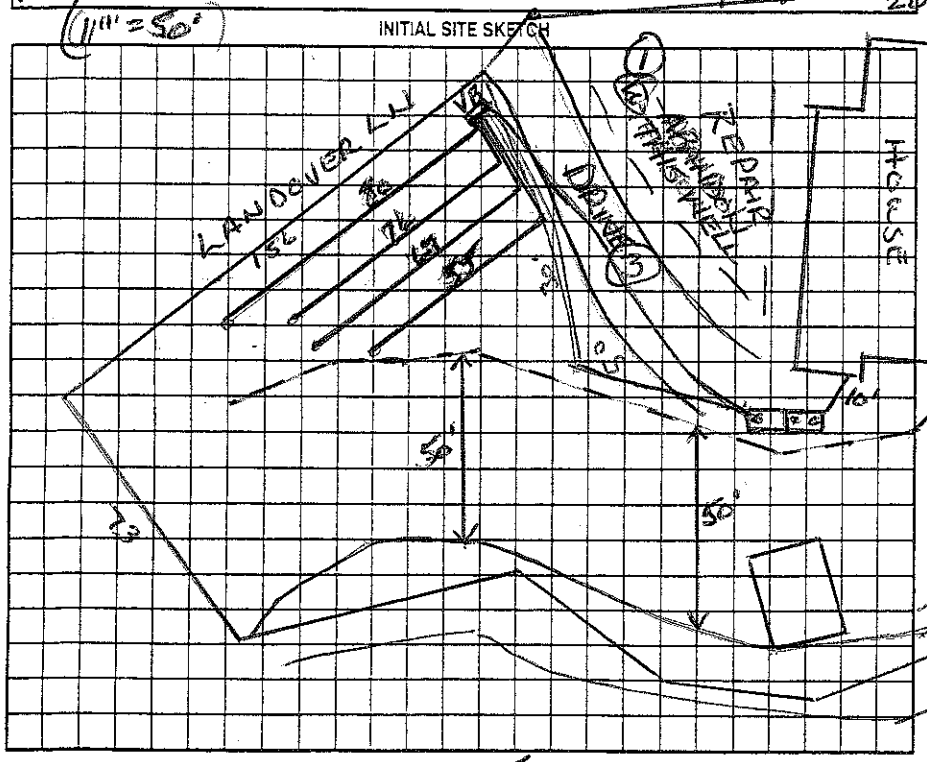

Comments/Conditions: 5 32 80 76 67 223 55 278

AS BUILT SKETCH

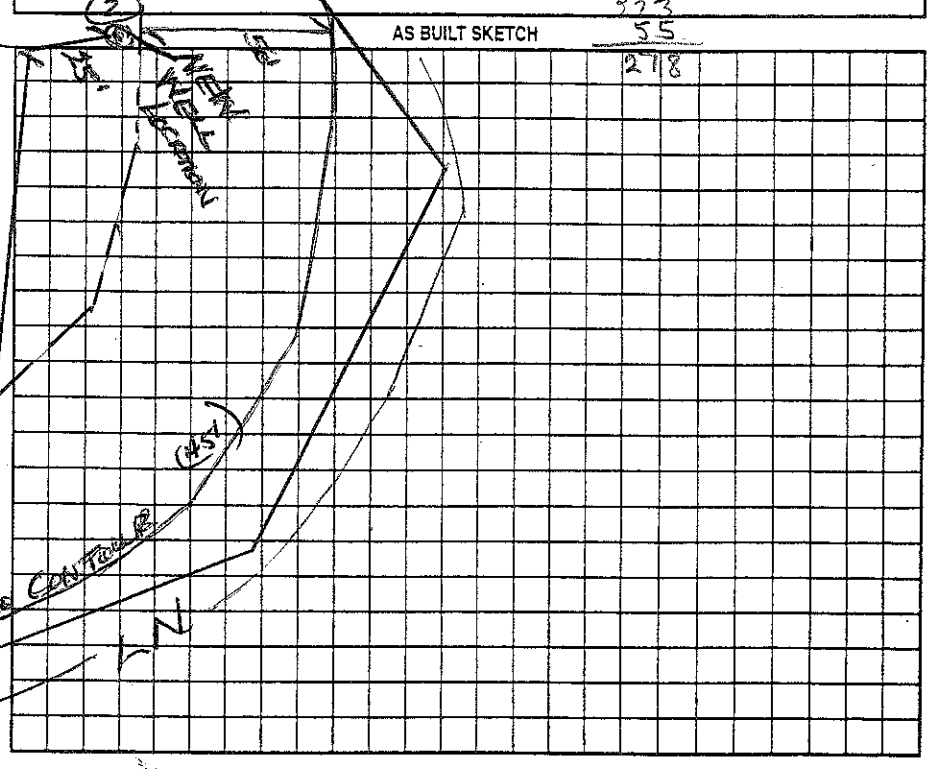

Permit can be suspended or revoked if any false information is supplied toward securing the permit/any unauthorized changes are made to the site/any unauthorized changes are made in the installation of the system. Improvement Permit with plat valid without expiration ☐ Improvement Permit with site plan valid for sixty months ☐ Authorization to Construct is valid for a period equal to that of Improvement Permit – not to exceed sixty months.

Signed: [signature] date 5-15-06 Installed by: Alternative

Improvement Permit by: Wesley Sparks R.S. date 9/15/06 Operation Permit by: Wesley Sparks R.S. date 5/8/08

Authorization to Construct by: Wesley Sparks R.S. date 9/15/06 Existing System Inspection by: date

HEALTH DEPT. COPY: WHITE OWNER COPY (FINAL): YELLOW OWNER COPY (INITIAL): PINK