IREDELL COUNTY HEALTH DEPARTMENT

STATESVILLE 704-878-5305 MOORESVILLE 704-664-5281

IMPROVEMENT PERMIT / ~~CERTIFICATE OF COMPLETION~~ / OPERATION PERMIT / EXISTING SYSTEM INSPE

Connection to Centennial — 1 — 9-30

PROPERTY DESCRIPTION NO. 22464 DATE Dec 21, '95 TAX MAP NO. part of 2LA11 4616 94 7495 Watershed:

OWNER OR CONTRACTOR ~~Concept Companies Inc~~ Jim Lupar PHONE: Business _____ Home 910-924-2539 Wk

ADDRESS ~~P.O. Box 1003 Charlotte NC~~ 4360 Falconhead W-S, NC. 27106

LOCATION Brawley Sch. Rd. TR McKendree Rd. on Right just past "Boat Landing"

SUBDIVISION McKendree Pt. BLOCK / SECTION _____ LOT 2 LOT AREA 1.98 AC SITE CLASS. Sp. 1952 DESIGN FLOW 480 gpd L.T.A.R. 1.3

Septic Tank: 1000 Gallons; STB 794 Date 3/10/97

Pump Tank: 1000 Gallons; PT 10 Date 3/[illegible]/97

Pump Make: Hydromatic Model _____ Serial No. _____

Nitrification Field: No Fields 1 Square Feet _____ Linear Feet 270 +

No Lines 3 Trench Width 24" Max Trench Bottom Depth 36" Gravel Depth N/A

☑ New System ☐ Repair System Type: I, II, III, IV, V, VI

System Description: LP panel Block

Repair System Description: LP panel Block

Maintenance Agreement Required: ☑ Yes ☐ No

☑ House/Mod. Home No. Bedrooms 4

☐ Mobile Home No. Bathrooms 4

☐ Business No. Employees _____

☐ Other _____

☐ Slab ☐ Crawl Space ☑ Basement w/plumbing ☐ Basement wo/plumbing


Water Supply: ☑ Individual ☐ Community ☐ Public

Comments:


Comments: LINES - TANKS CHECKED - ELECTRICAL CHECKED - MAINTENANCE AGREEMENT RECEIVED -

INITIAL SITE SKETCH

1" = 60'

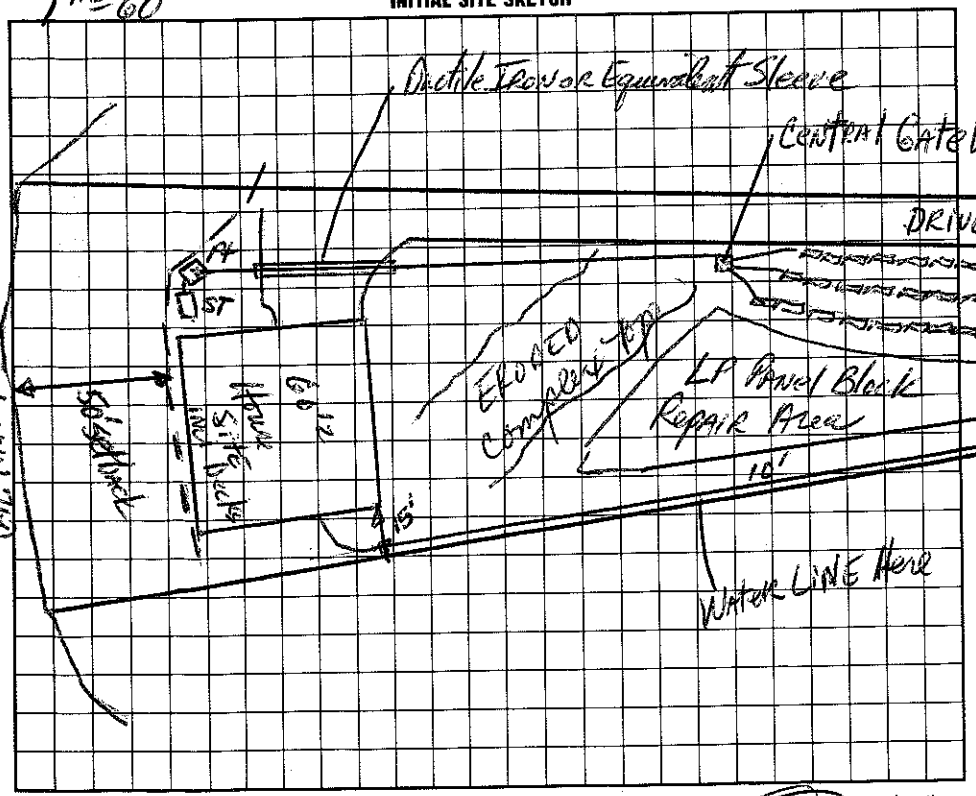

AS BUILT SKETCH

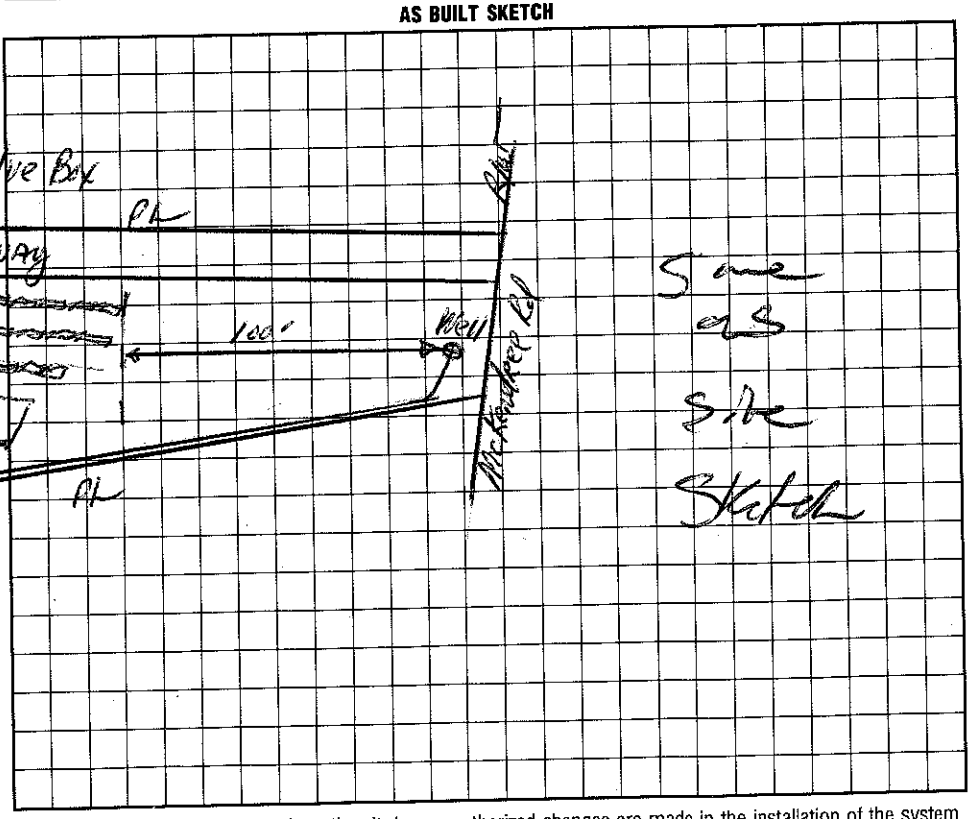

I understand that this permit can be suspended or revoked if any false information is supplied toward securing the permit/any unauthorized changes are made to the site/any unauthorized changes are made in the installation of the system.

Signed: X [signature] CHS Agent

Improvement Permit by: [signature] RS date 12-21-95

Authorization to Construct by: [signature] RS date 12/28/95

Installed by: TIM ANNONS

Certificate of Completion by: Wesley Sparks RS date 7/28/97

Operation Permit by: Wesley Sparks RS date 7/28/97

PINK COPY (INITIAL) GOLD