IREDELL COUNTY HEALTH DEPARTMENT

STATESVILLE 704-878-5305 MOORESVILLE 704-664-5281

IMPROVEMENT PERMIT / ~~CERTIFICATE OF COMPLETION~~ / OPERATION PERMIT / EXISTING SYSTEM INSP

PROPERTY DESCRIPTION NO. 22464 DATE Dec 21, '95 TAX MAP NO. Part of 2L All 4616 99 7495 Watershed:

OWNER OR CONTRACTOR Grant Engineering Inc Jim Annons PHONE: Business / Home 910-924-2539 ext

ADDRESS PO Box 1973 Charlotte NC 4300 Falcon Rd W-S, NC. 27106

LOCATION Sunday Sch Rd. TR McKendree Rd. on Right just past "Boat Landing"

SUBDIVISION McKendree Pt. BLOCK / SECTION ____ LOT 2 LOT AREA 1.98 AC SITE CLASS Bay, 1952 DESIGN FLOW 480 gpd L.T.A.R. w-3

Septic Tank: 1000 Gallons; STB 794 Date 3/10/97

Pump Tank: 1000 Gallons; PT 12 Date 3/12/97

Pump Make: HYDROMATIC Model ____ Serial No. ____

Nitrification Field: No Fields 1 Square Feet ____ Linear Feet 270 +

No Lines 3 Trench Width 24" Max Trench Bottom Depth 36" Gravel Depth N/A

☑ New System ☐ Repair System Type: I, II, III, IV, V, VI

System Description: LP panel block

Repair System Description: LP panel block

Maintenance Agreement Required: ☑ Yes ☐ No

☐ Slab ☐ Crawl Space ☑ Basement w/plumbing ☐ Basement wo/plumbing

☐ House/Mod. Home No. Bedrooms 4

☐ Mobile Home No. Bathrooms 4

☐ Business No. Employees ____

☐ Other ____


Water Supply: ☑ Individual ☐ Community ☐ Public

Comments:


Comments: LINES - TANKS CHECKED - ELECTRICAL CHECKED - MAINTENANCE AGREEMENT RECEIVED -

INITIAL SITE SKETCH

1" = 60'

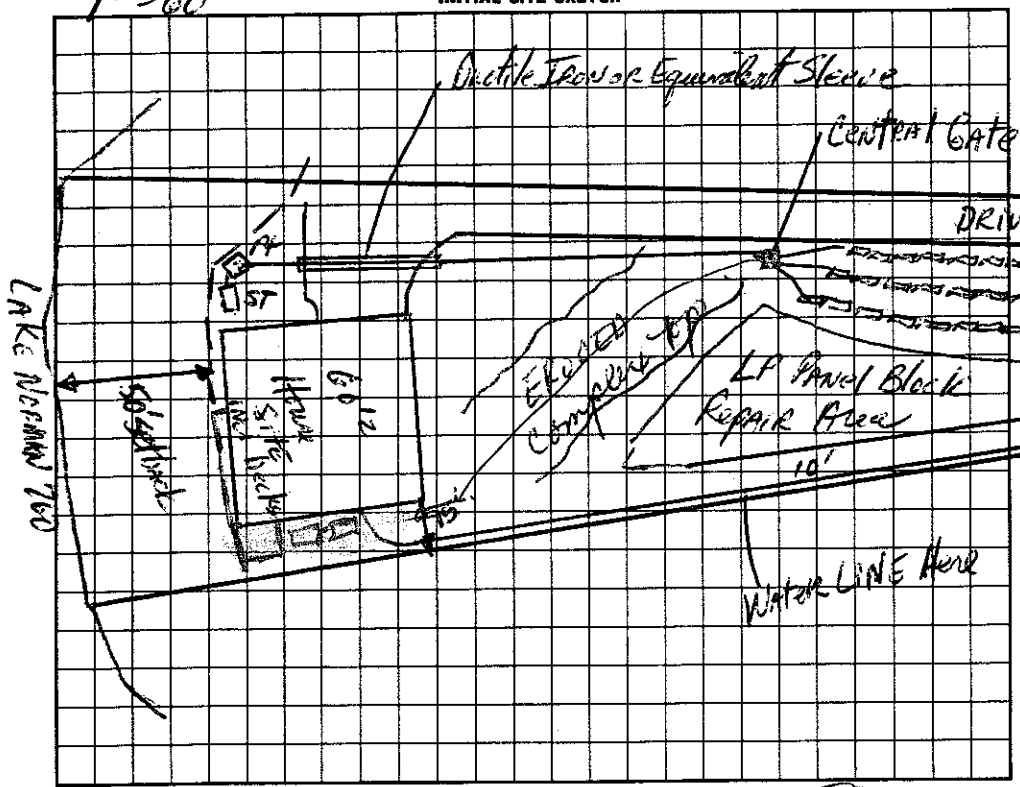

AS BUILT SKETCH

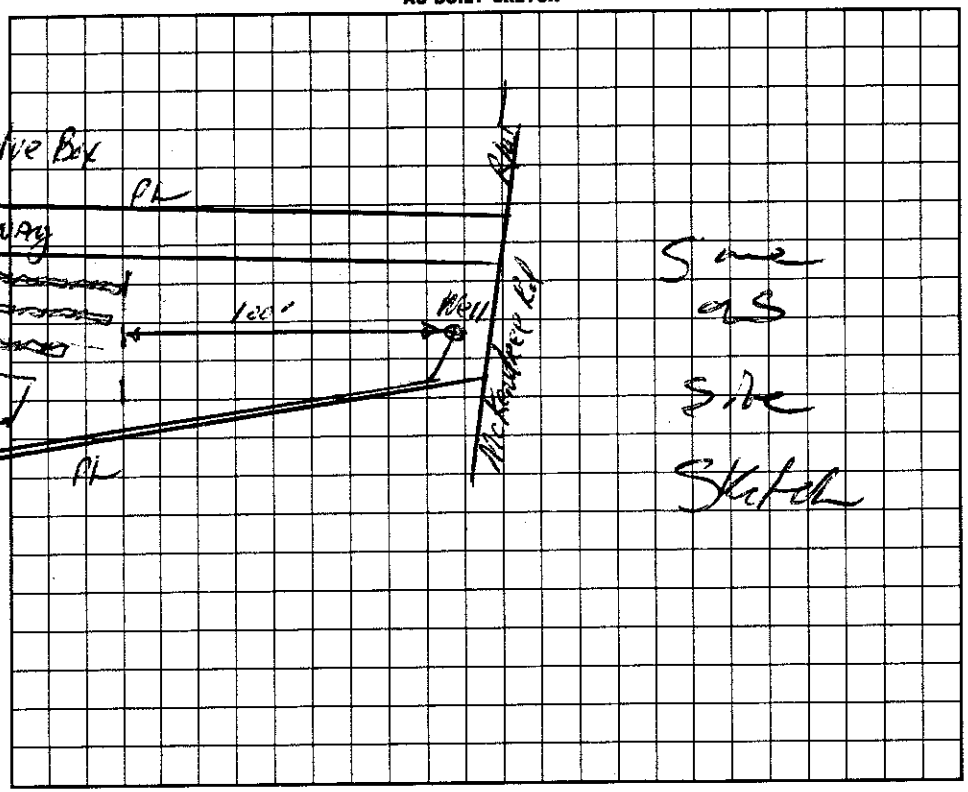

I understand that this permit can be suspended or revoked if any false information is supplied toward securing the permit/any unauthorized changes are made to the site/any unauthorized changes are made in the installation of the system.

Signed: Jim Annons, CPES Agent

Improvement Permit by: D.L. Johnson, RS date 12-21-95

Authorization of Inspection by: Wesley Sparks RS date 10/8/96

Installed by: Jim Annons

Certificate of Completion by: Wesley Sparks RS date 7/28/97

Operation Permit by: Wesley Sparks RS date 7/28/97

INITIAL - PINK OWNER COPY (INITIAL) - GOLD