IREDELL COUNTY HEALTH DEPARTMENT

STATESVILLE 704-878-5305 3700 Paid MOORESVILLE 704-664-5281

IMPROVEMENT PERMIT / AUTHORIZATION TO CONSTRUCT / OPERATION PERMIT / EXISTING SYSTEM INSPECTION

PERMIT# 086643 PIN# 4616 94 9071 DATE 9/23/02

OWNER OR CONTRACTOR Clarks W Moyer PHONE: Business 704-895-0401 Home

ADDRESS 17617 Spinnakers Reach Drive Cornelius, NC. 28031 704-799-9913

LOCATION I-00, TR McKendree Rd. go straight to 3 lot on (R)

SUBDIVISION Pine Knoll Ct. BLOCK / SECTION LOT 3 LOT AREA .62 AC SITE CLASS. PS DESIGN FLOW 480 L.T.A.R. .3

Septic Tank: 1000 Gallons; STB 312 Date 6-21-04
Pump Tank: 1000 Gallons; PT 27 Date 6-26-04
Pump Make: Goulds Model WE03128M Serial No.
Nitrification Field: No Fields 1 Square Feet 810 Linear Feet 280*
No Lines 4@70' Trench Width 2-3' Max Trench Bottom Depth 3' Gravel Depth No

[X] New System [ ] Repair System Type: I, II, III (IV) V, VI
System Description: Pressure → 16@ PPBPS
Repair System Description: SAME
Maintenance Agreement Required: [X] Yes [ ] No

[X] House/Mod. Home No. Bedrooms 4
[ ] Mobile Home No. Bathrooms 4
[ ] Business No. Employees
[ ] Other
[ ] Slab [X] Crawl Space [ ] Basement w/plumbing [ ] Basement wo/plumbing


Water Supply: [X] Individual [ ] Public [ ] Community

Comments:/Conditions: 64 Panels.


Comments:/Conditions: Drilled 3/16" hole
Checked lines 6/18/04 MD
Checked tanks 8/5/04
Maint Agreement attached

(1" = 40')

INITIAL SITE SKETCH

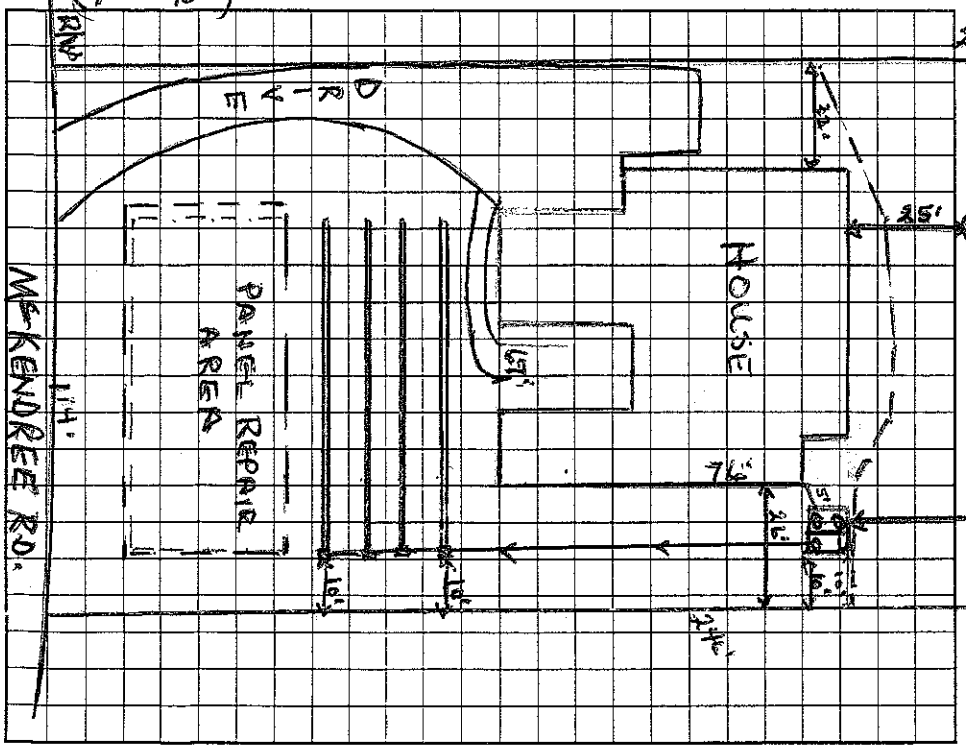

AS BUILT SKETCH

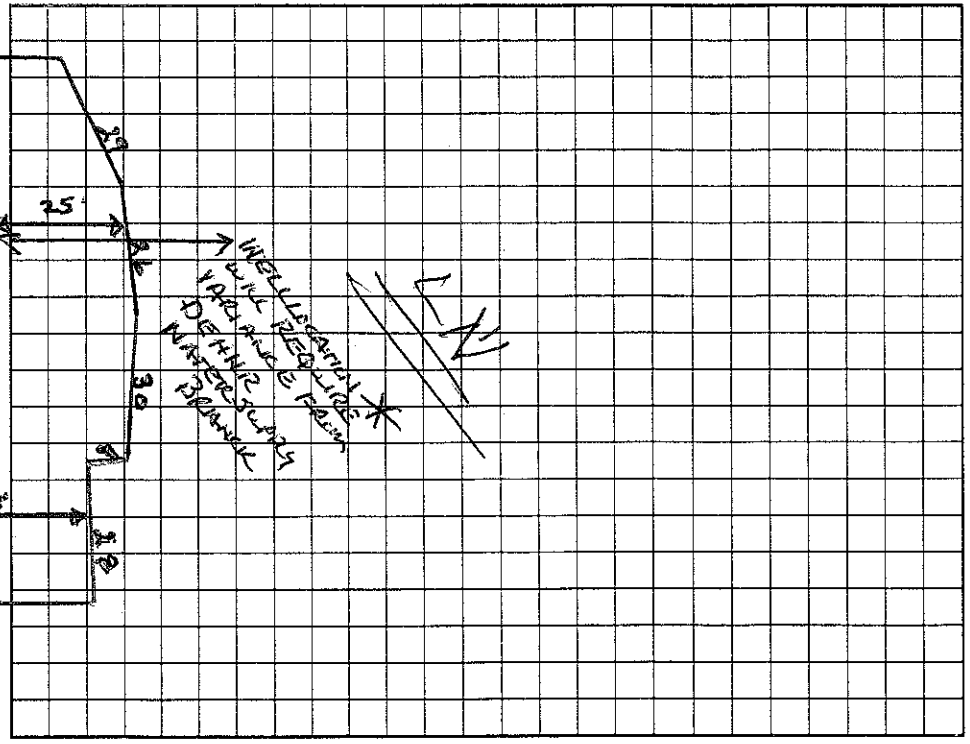

Permit can be suspended or revoked if any false information is supplied toward securing the permit/any unauthorized changes are made to the site/any unauthorized changes are made in the installation of the system. Improvement Permit with plat valid without expiration. Improvement Permit with site plan valid for sixty months. Authorization to Construct is valid for a period equal to that of Improvement Permit – not to exceed sixty months.

Signed: [signature] date 9-25-02 Installed by: R&H

Improvement Permit by: Wesley Sparks R.S. date 9/23/02 Operation Permit by: Maria H. Dotson R.S. date 8/12/04

Authorization to Construct by: Wesley Sparks R.S. date 9/23/02 Existing System Inspection by: date

HEALTH DEPT. COPY: WHITE OWNER COPY (FINAL): YELLOW OWNER COPY (INITIAL): PINK