4616 94 9152

IREDELL COUNTY HEALTH DEPARTMENT

STATESVILLE 704-878-5305 MOORESVILLE 704-664-5281

IMPROVEMENT PERMIT / CERTIFICATE OF COMPLETION / OPERATION PERMIT / EXISTING SYSTEM INSPECTION

PROPERTY DESCRIPTION NO. 14328 DATE 12/12/95 TAX MAP NO. 2F3C2 / 2LA11 Watershed: [X] Yes [ ] No

OWNER OR CONTRACTOR Ron L Smith PHONE: Business _____ Home _____

ADDRESS Fawn Lane Mooresville, NC. 28115

LOCATION Brawley Sch TR McKendree Post Hagers Cab Landing straight onto Fawn Lane to 1st house on (R)

SUBDIVISION Pine Knoll Est BLOCK / SECTION _____ LOT 2 LOT AREA 1.645 AC SITE CLASS. PS DESIGN FLOW 480 L.T.A.R. .3

Septic Tank: 1500 Gallons; STB STB 1012 Date 8/19/95
Pump Tank: 1500 Gallons; PT PT 159 Date 12/12/94
Pump Make: _____ Model _____ Serial No. _____
Nitrification Field: No Fields 1 Square Feet — Linear Feet 270 ft
No Lines 4 Trench Width 24" Max Trench Bottom Depth 36" Gravel Depth 6" SAND

[X] New System [ ] Repair System Type: I, II, III, IV, V, VI
System Description: Pres Panel
Repair System Description: Same
Maintenance Agreement Required: [X] Yes [ ] No


[X] House/Mod. Home No. Bedrooms 4
[ ] Mobile Home No. Bathrooms 4
[ ] Business No. Employees _____
[ ] Other _____
[ ] Slab [ ] Crawl Space [X] Basement w/plumbing [ ] Basement wo/plumbing

Water Supply:
[X] Individual
[ ] Community
[ ] Public


Comments: 16" Prefab. Panel Block
McKendree Point

Comments:

INITIAL SITE SKETCH

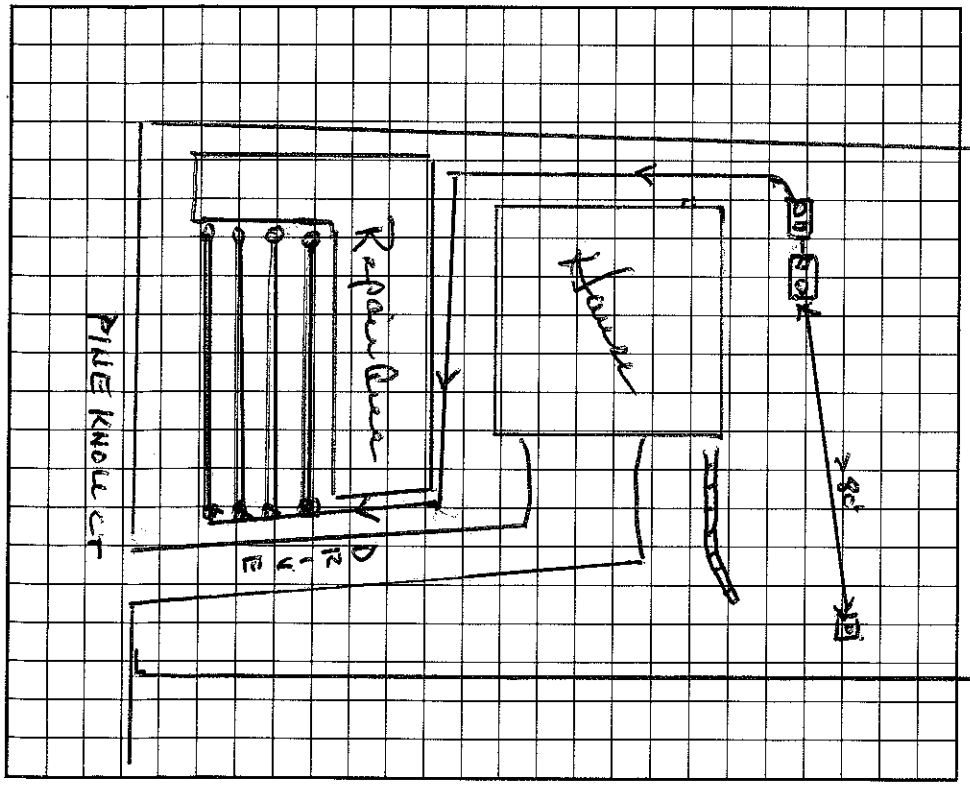

AS BUILT SKETCH

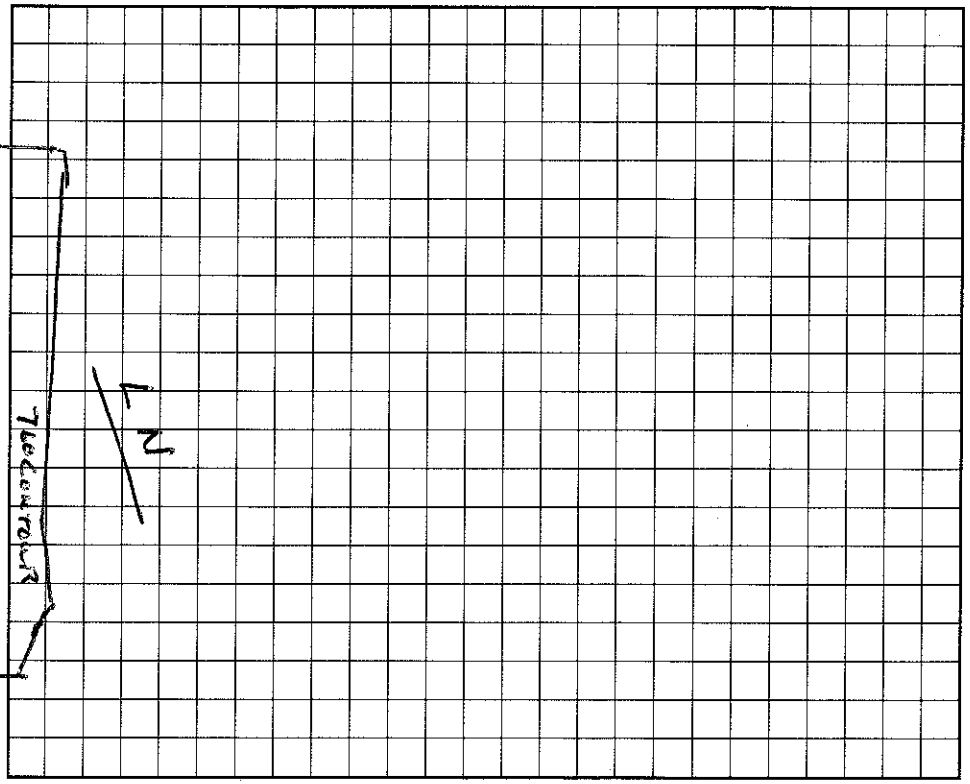

I understand that this permit can be suspended or revoked if any false information is supplied toward securing the permit/any unauthorized changes are made to the site/any unauthorized changes are made in the installation of the system.

Signed: _____

Improvement Permit by: DRH date 4/3/95

Existing System Inspection by: _____ date _____

Installed by: Ron Smith

Certificate of Completion by: Wesley Sparks RS. date 12/13/95

Operation Permit by: Wesley Sparks RS. date 12/13/95

HEALTH DEPT. COPY: WHITE INSPECTION COPY (FINAL): GREEN OWNER COPY (FINAL): YELLOW INSPECTION COPY (INITIAL): PINK OWNER COPY (INITIAL): GOLD