IREDELL COUNTY HEALTH DEPARTMENT

STATESVILLE 704-878-5305 50.00 Paid MOORESVILLE 704-664-5281

IMPROVEMENT PERMIT / AUTHORIZATION TO CONSTRUCT / OPERATION PERMIT / EXISTING SYSTEM INSPECTION

PERMIT# 22463/90826 PIN# 4616 94 9450 DATE 10/3/01

OWNER OR CONTRACTOR Richard Durlt PHONE: Business 704-663-3782 Home

ADDRESS 800 McKendree Rd. Mooresville NC 28117

LOCATION 1100 TR McKendree Rd. on (R) 3 lots past Boat Landing

SUBDIVISION McKendree Pt. BLOCK / SECTION LOT 3 LOT AREA 1.105 AC SITE CLASS. PS DESIGN FLOW 480 L.T.A.R. .3

Septic Tank: 1000 Gallons; STB 1012 Date 7/30/01
Pump Tank: 1000 Gallons; PT 17 Date 6/11/00
Pump Make: ~~MYERS~~ Model ME 50 SI Serial No. 25325D009
Nitrification Field: No Fields 1 Square Feet 540 Actual Feet 270
Trenches 3 Length 90' Trench Width 3' Max Trench Bottom Depth 3' Gravel Depth SAND.


☑ New System ☐ Repair System Type: I, II, III, IV, V, VI
System Description: LP - 16" APBPS
Repair System Description: SAME
Maintenance Agreement Required: ☒ Yes ☐ No

☒ House/Mod. Home No. Bedrooms 4
☐ Mobile Home No. Bathrooms 4
☐ Business No. Employees
☐ Other
☐ Slab ☐ Crawl Space ☒ Basement w/plumbing ☐ Basement wo/plumbing

Water Supply: ☒ Individual ☐ Public ☐ Community


Comments/Conditions:

1"=30' INITIAL SITE SKETCH

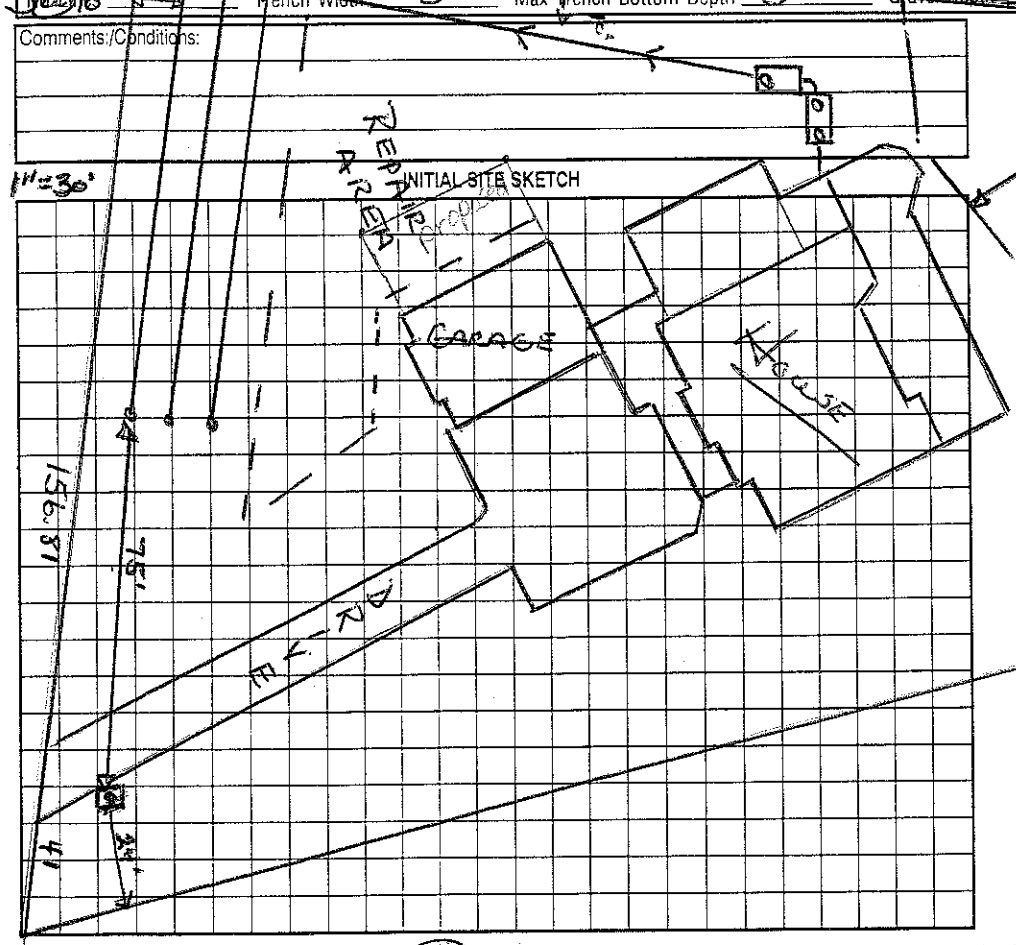

Comments/Conditions: Towing, Pinson, Deinfield

AS BUILT SKETCH

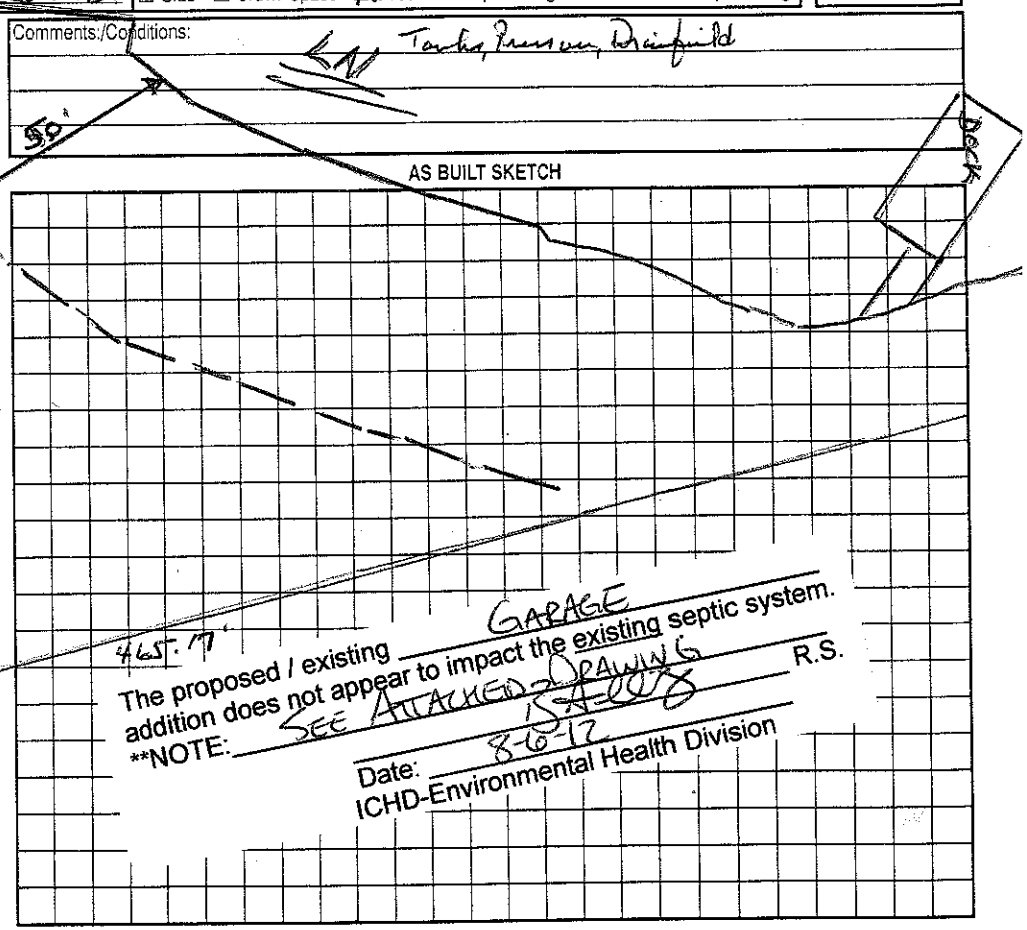

The proposed / existing GARAGE addition does not appear to impact the existing septic system.
**NOTE: SEE ATTACHED DRAWING R.S.
Date: 8-6-12
ICHD-Environmental Health Division

Permit can be suspended or revoked if any false information is supplied toward securing the permit/any unauthorized changes are made to the site/any unauthorized changes are made in the installation of the system. Improvement Permit with plat valid without expiration; Improvement Permit with site plan valid for sixty months. Authorization to Construct is valid for a period equal to that of Improvement Permit – not to exceed sixty months.

Signed: [signature] date 10/8/01
Improvement Permit by: Wesley Sparks R.S. date 10/3/01
Authorization to Construct by: Wesley Sparks R.S. date 10/3/01

Installed by: Richard Abernathy
Operation Permit by: Wesley Sparks RS date 11/13/01
Existing System Inspection by: date

HEALTH DEPT. COPY: WHITE OWNER COPY (FINAL): YELLOW OWNER COPY (INITIAL): PINK