IREDELL COUNTY HEALTH DEPARTMENT STATESVILLE 704-878-5305 MOORESVILLE 704-664-5281

IMPROVEMENT PERMIT / AUTHORIZATION TO CONSTRUCT / OPERATION PERMIT / EXISTING SYSTEM INSPECTION

PERMIT # 120482 PIN # 4616 98 6246 DATE 2/20/09

OWNER or APPLICANT Wm. J. CONWAY PHONE: Business 914-382-1970 Home:

OWNER or APPLICANT ADDRESS 736 LAKEVIEW SHORES LP. MOORESVILLE, NC. 28117

LOCATION / DIRECTIONS 736 LAKEVIEW SHORES LP. - Kenduc Rd R2 NA Lakeview Shores Lp. on (L) just past Renwick Ct.

SUBDIVISION CL + T BLOCK / SECTION 8 LOT # 233 LOT AREA 2.7AC DESIGN FLOW 480 L.T.A.R. .3

Septic Tank 1000 Gallons: STB 1007 Date 10/3/08
Pump Tank 1000 Gallons: PT 27 Date 12/19/08
Pump Make ZOELLER Model N-153B Serial #
Nitrification Field No Fields No Lines 6 Linear Feet 266
Trench Width 2' Max. Trench Bottom Depth 3' Gravel Depth NA ☐ GRAVITY ☒ PRESSURE

☒ New System ☐ Repair ☐ Expansion System Type I II (III) IV V VI
System Description: PM → 16" PPBPS
Repair System Description: SAME
Maintenance Agreement Required ☐ YES ☒ NO

☒ Residence No. Bedrooms 4
☐ Business No. Persons
☐ Other No. Employees
☐ Slab ☐ Crawl Space
☐ Basement w/plumbing ☒ Basement w/o plumbing


Water Supply
☒ Private
☐ Public
☐ Community

Comments / Conditions Basement constructed - forcing Redraw / Permit Change


Comments / Conditions

1" = 50'

INITIAL SITE SKETCH

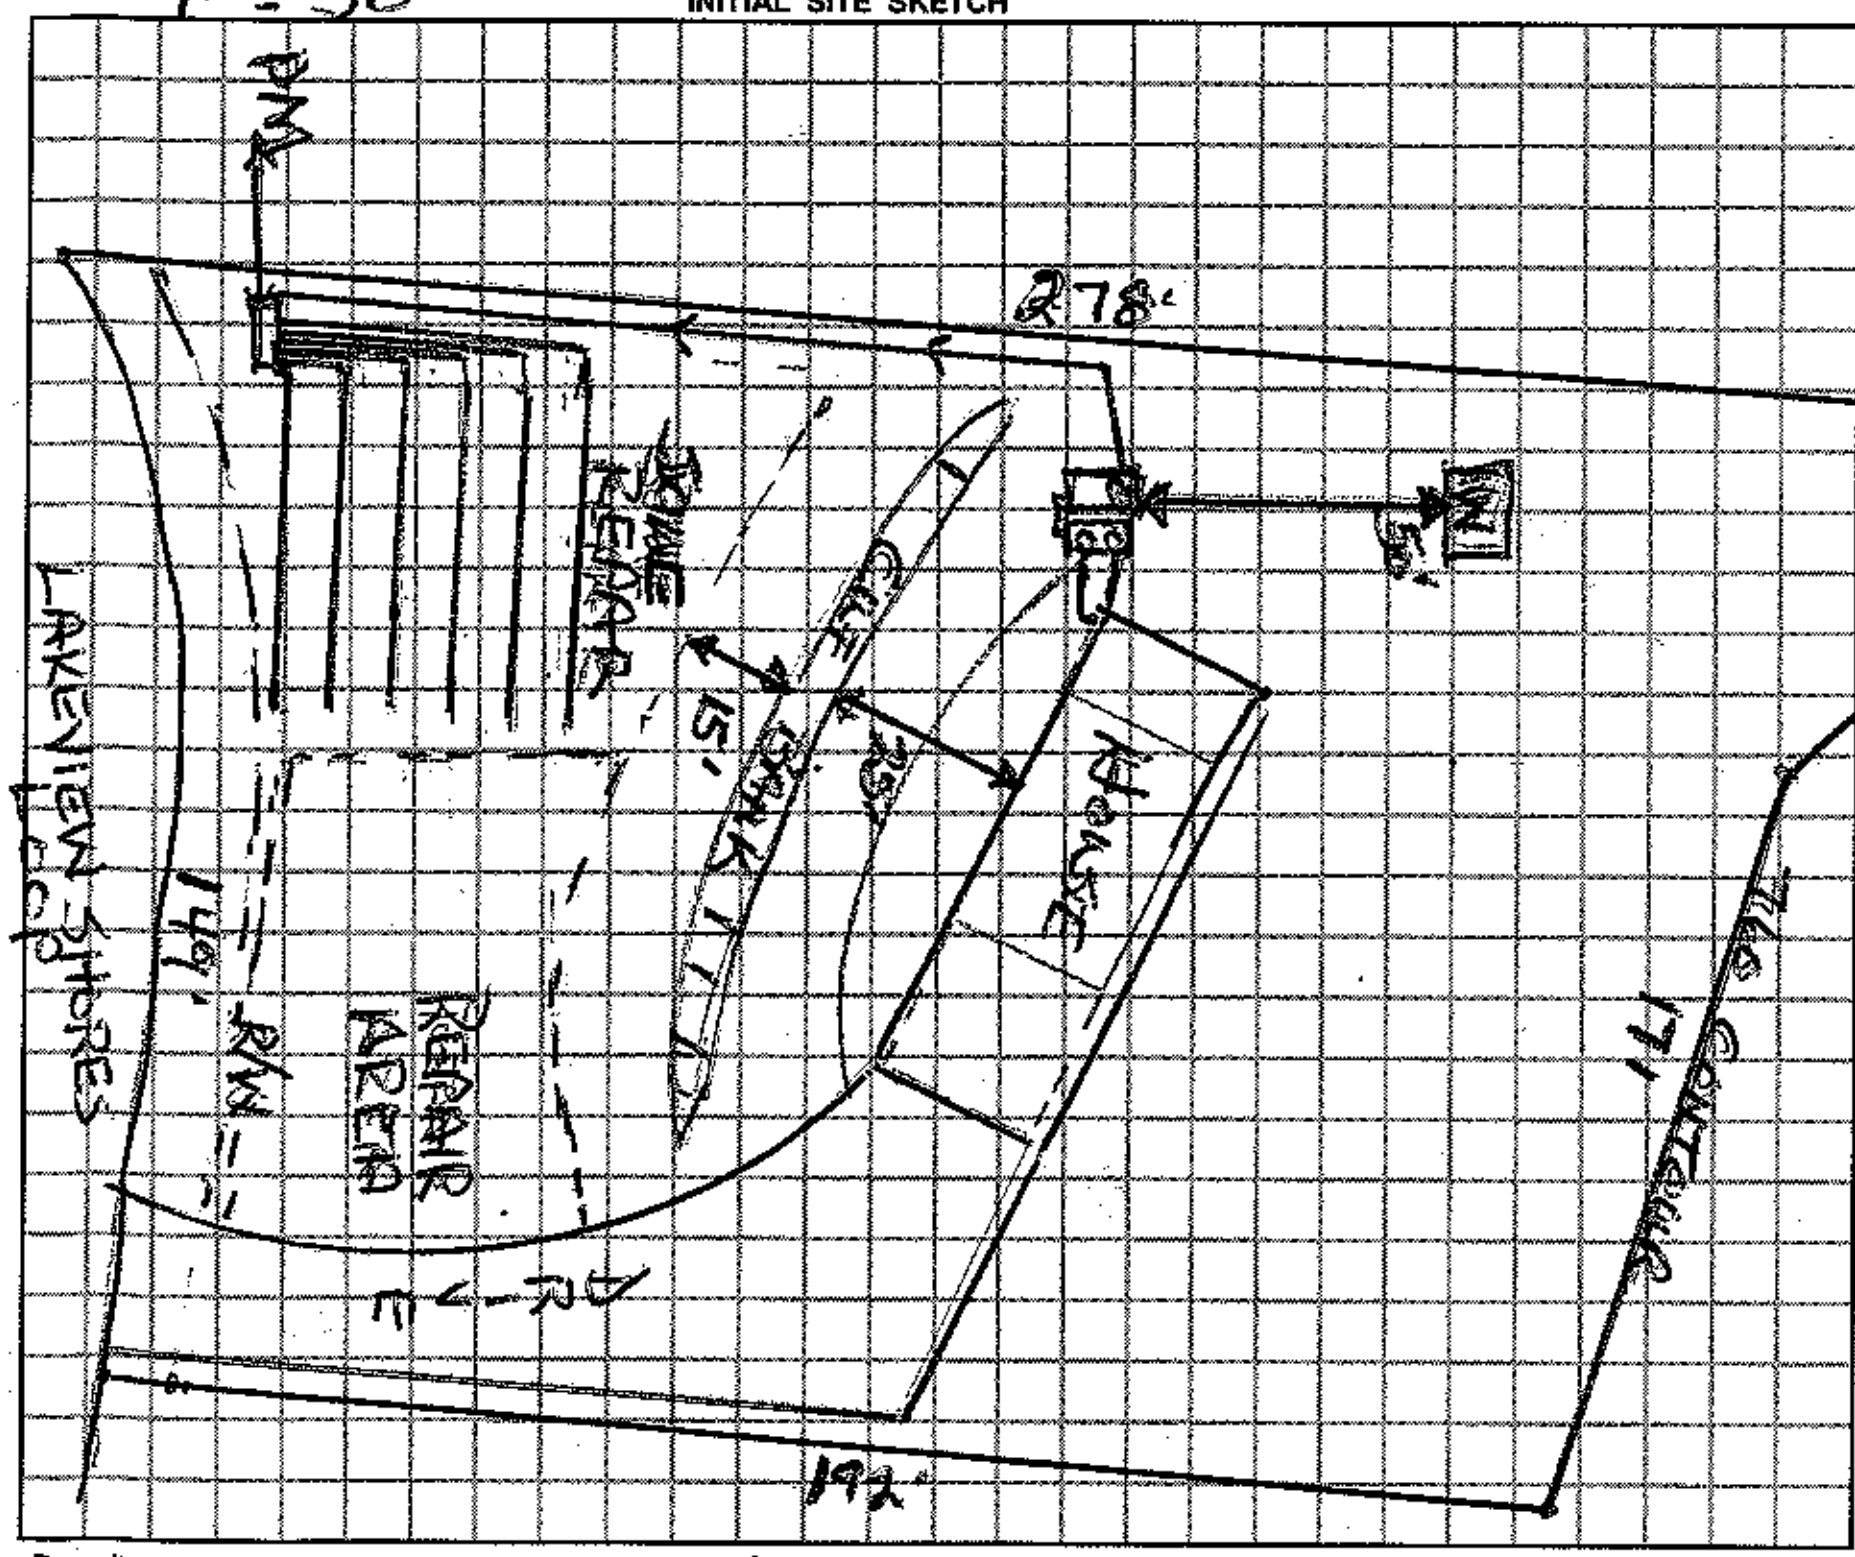

AS BUILT SKETCH

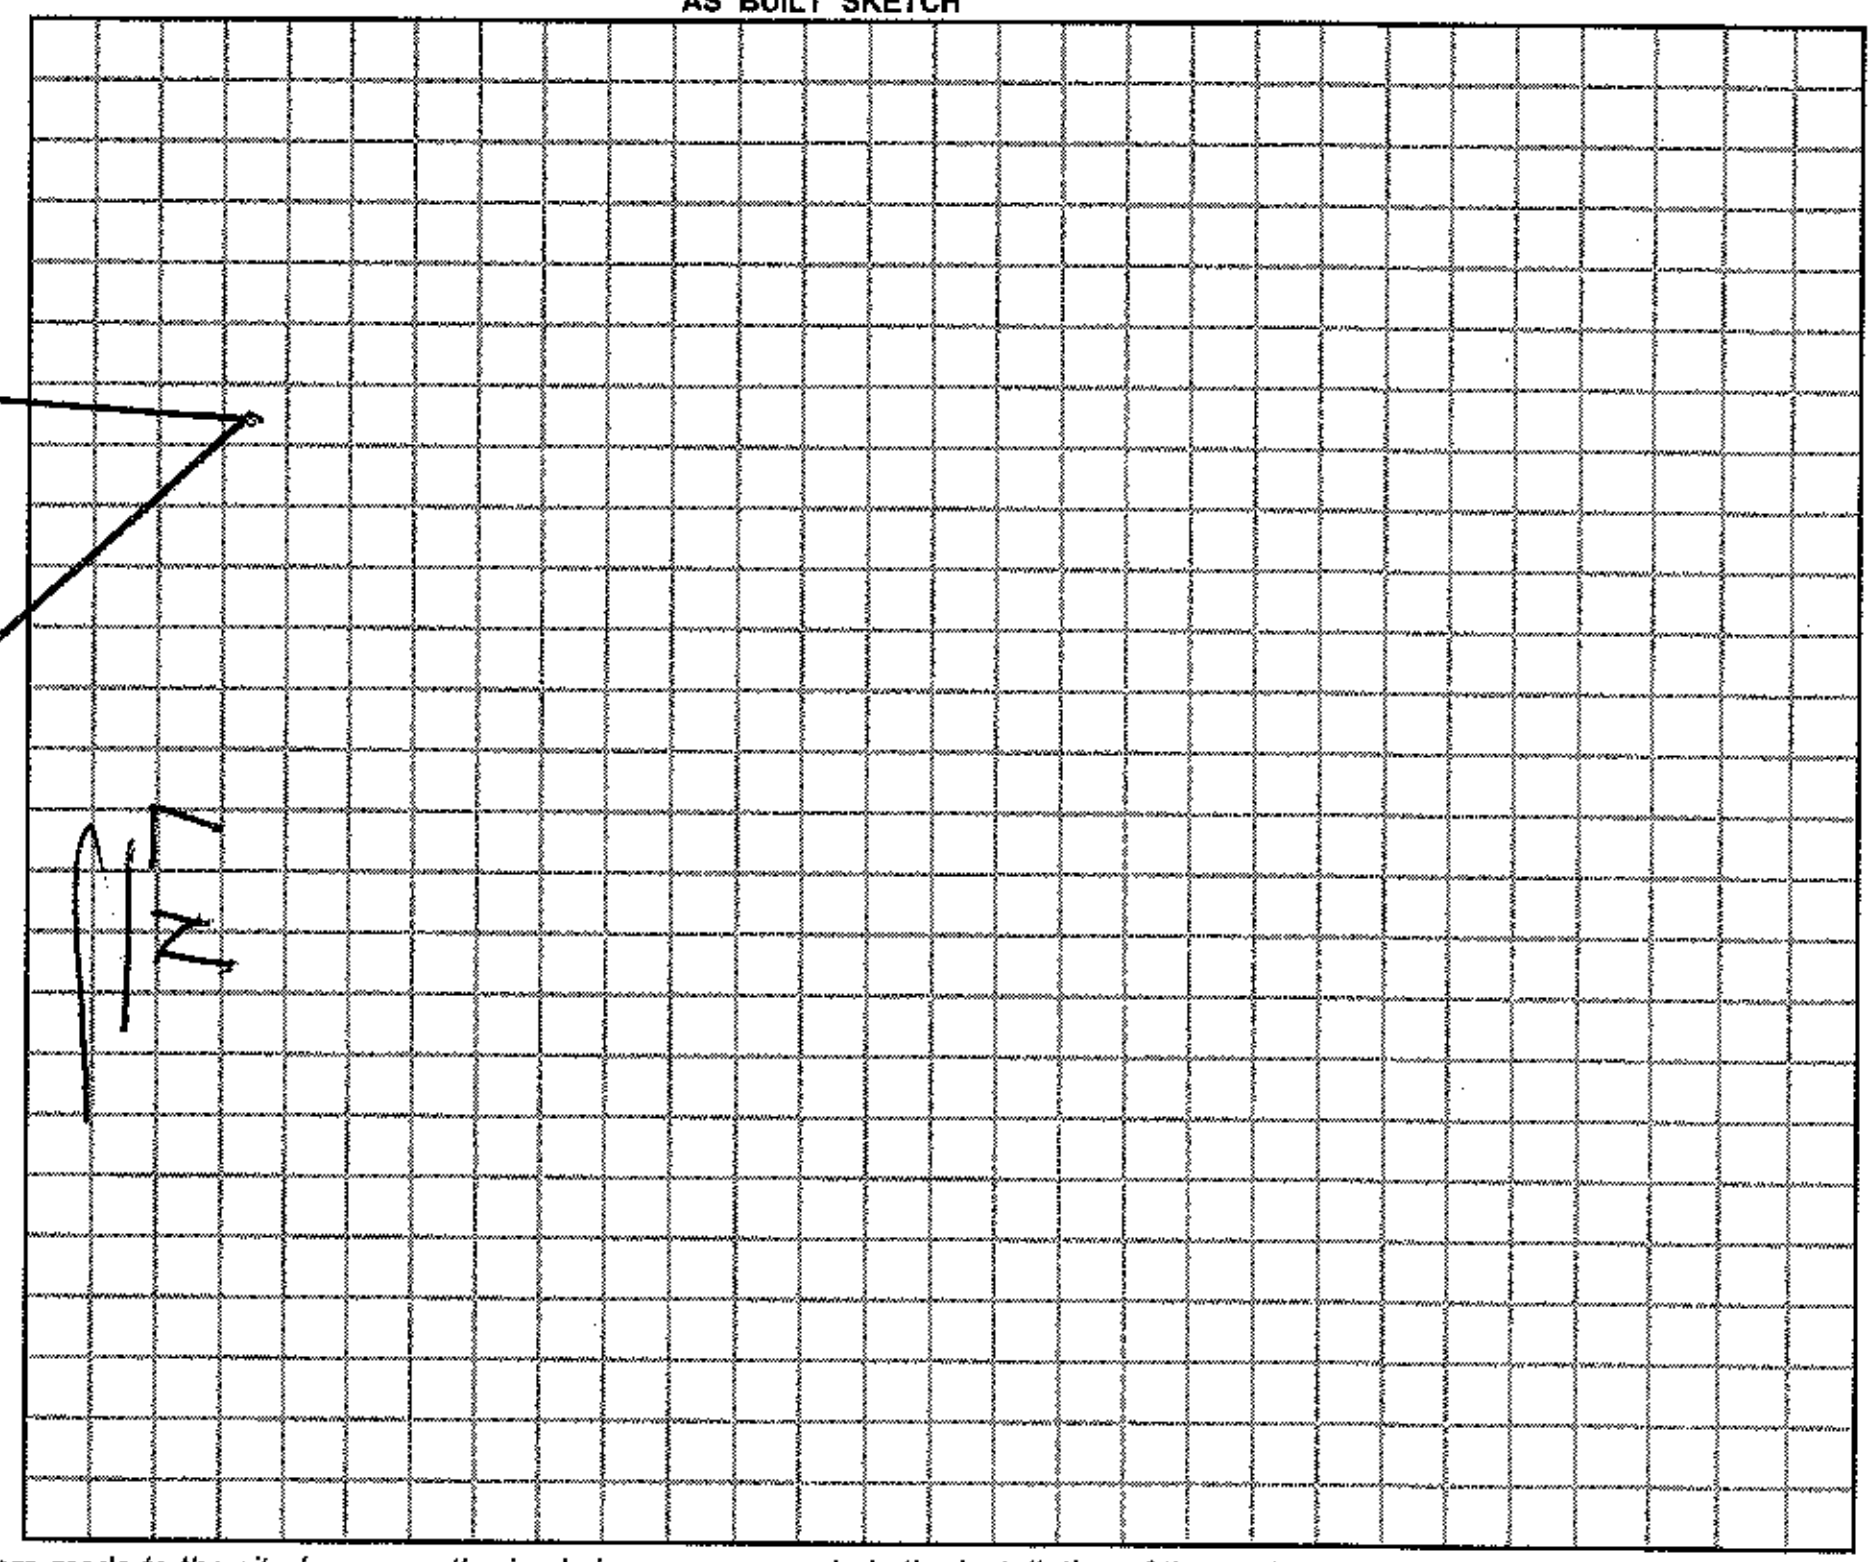

Permit can be suspended or revoked if any false information is supplied toward securing the permit / any unauthorized changes are made to the site / any unauthorized changes are made in the installation of the system.

☐ *IMPROVEMENT PERMIT w / plat valid without expiration.* ☒ *IMPROVEMENT PERMIT w / site plan valid for 60 mos.* ☒ *AUTHORIZATION TO CONSTRUCT valid for period equal to IMPROVEMENT PERMIT-not to exceed 60 mo.*

Owner / Applicant Signature: * William J. Conway Date 2/24/09 Installed by: Wayne Chantz
Improvement Permit by: Wesley Sparks RS. Date 2/20/09 Operation Permit by: Wesley Sparks RS Date: 7/29/09
Authorzation to Construct by: Wesley Sparks RS. Date 2/20/09 Existing System Inspected by: Date:

YOU SHOULD CONTACT A LOCATOR SERVICE PRIOR TO ANY EXCAVATION.

WHITE COPY Environmental Health YELLOW COPY (Final) Owner / Applicant PINK COPY (Initial) Owner / Applicant