IREDELL COUNTY HEALTH DEPARTMENT

Statesville Phone TR 3-7271 Mooresville Phone NO 3-1271

PERMIT TO INSTALL SEPTIC TANK

Permit NO. _____ Permit Date 7-May 1970

Owner L.A. Nine Jr. Address _____

Installed By Orbie Carr Honeycutt Address Mooresville


Location of Property Sect 8 Lot 242

Tank		Capacity		Length of Lines		Fixtures	
Block	( )	1000	(✓)	225'	(✓)	No. of Baths	( )
Precast	(✓)	1250	( )	250'	( )	Dishwasher	( )
		1500	( )	Other _____		Garbage Grdr.	( )
		Other _____				Other _____	

NOTIFY HEALTH DEPARTMENT AT LEAST EIGHT HOURS BEFORE TANK IS TO BE INSPECTED.

Final Inspection 7 May 1970 Approved (✓) Disapproved ( )

Remarks ~~bolt~~ well not Pour

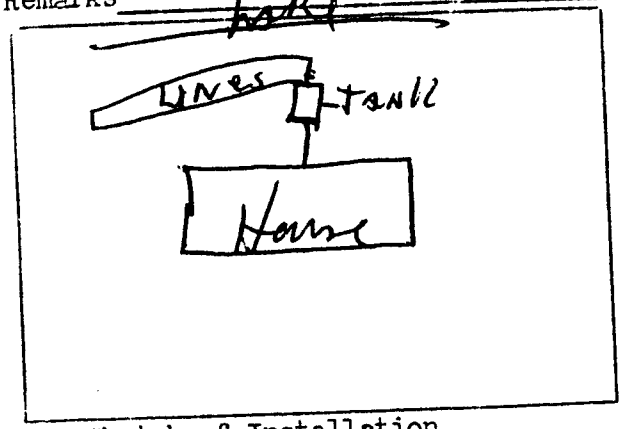

Sketch of Installation

Ray Scruggs RS

Sanitarian