4016989703

IREDELL COUNTY HEALTH DEPARTMENT

STATESVILLE 704-878-5305 MOORESVILLE 704-664-5281

IMPROVEMENT PERMIT / CERTIFICATE OF COMPLETION / OPERATION PERMIT / EXISTING SYSTEM INSPECTION

PROPERTY DESCRIPTION NO. 18496 DATE May 25, '94 TAX MAP NO. 2L3A241 Watershed: ☑ Yes ☐ No

OWNER OR CONTRACTOR Jerry Fuss PHONE: Business _____ Home _____

ADDRESS 7116 Fairhill Pl. Charlotte 28270 CN

LOCATION 1100 TR 1115 TR 1455 (Lakeview DR - 2nd entrance) .6 mile on left

SUBDIVISION Crescent LN BLOCK / SECTION 8 LOT 241 LOT AREA ~3/4Ac SITE CLASS. PS DESIGN FLOW 360 L.T.A.R. .3

Septic Tank: Existing Gallons; STB _____ Date _____

Pump Tank: _____ Gallons; PT _____ Date _____

Pump Make: _____ Model _____ Serial No. _____

Nitrification Field: No Fields 1 Square Feet 360+EX Linear Feet 120+EX

No Lines 1+EX Trench Width 36" Max Trench Bottom Depth 36"

☐ New System ☑ Repair System Type: I, II, III, IV, V, VI

System Description: gravity conventional

Repair System Description: Grant or LPP conv.

Maintenance Agreement Required: ☐ Yes ☑ No

Gravel Depth 12"

☑ House/Mod. Home No. Bedrooms 3

☐ Mobile Home No. Bathrooms 2

☐ Business No. Employees ____

☐ Other _____


☐ Slab ☑ Crawl Space ☐ Basement w/plumbing ☐ Basement wo/plumbing

Water Supply: ☑ Individual ☐ Community ☐ Public

Comments: Upgrading septic system from 2 bedroom to 3 bedroom capacity. Check tank for integrity and for "tee".

Comments:

INITIAL SITE SKETCH

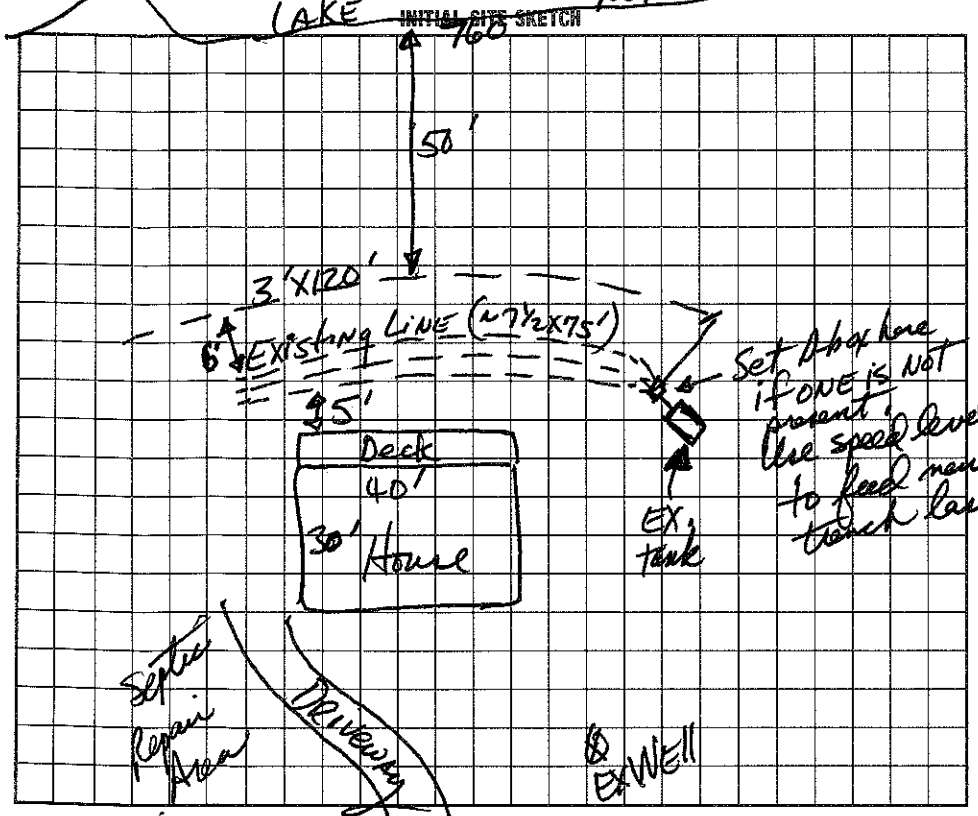

AS BUILT SKETCH

I understand that this permit can be suspended or revoked if any false information is supplied toward securing the permit/any unauthorized changes are made to the site/any unauthorized changes are made in the installation of the system. Improvement Permit is valid for 60 months from date of issuance.

LAKEVIEW DRIVE

Permit by: David R. Hinson, RS. date 5/25/94

Inspection by: _____ date _____

Installed by: Richard Alexander

Certificate of Completion by: [illegible] date 7-7-95

Operation Permit by: _____ date _____

HEALTH DEPT. COPY: WHITE INSPECTION COPY (FINAL): GREEN OWNER COPY (FINAL): YELLOW INSPECTION COPY (INITIAL): PINK OWNER COPY (INITIAL): GOLD