IREDELL COUNTY HEALTH DEPARTMENT

STATESVILLE 704-878-5305 MOORESVILLE 704-664-5281

IMPROVEMENT PERMIT / AUTHORIZATION TO CONSTRUCT / OPERATION PERMIT / EXISTING SYSTEM INSPECTION

PERMIT # 1333168 PIN # 4624 04 0928 4614-03-0928 DATE 6/9/09

OWNER or APPLICANT JOHN CAMPBELL PHONE: Business Home:

OWNER or APPLICANT ADDRESS 13016 EASTFIELD RD. HUNTERSVILLE, NC. 28078

LOCATION / DIRECTIONS 1100 TR TUSKARORA TL THUNDERHILL, AT CUL DE SAC, L OF CENTER

SUBDIVISION CL+T BLOCK / SECTION 6 LOT # 360 LOT AREA ~.76 DESIGN FLOW 480 L.T.A.R. .275

Septic Tank 1000 Gallons: STB 794 Date 10-9-09
Pump Tank 1000 Gallons: PT 283 Date 5-20-09
Pump Make GOULDS Model PESIM Serial # 1/2 HP
Nitrification Field No Fields 1 No Lines 6 Linear Feet 290
Trench Width 24" Max. Trench Bottom Depth 36" Gravel Depth NO ☐ GRAVITY ☒ PRESSURE

☒ New System ☐ Repair ☐ Expansion System Type I II III IV V VI
System Description: LP - 16" PABRS
Repair System Description: < 1983 LOT
Maintenance Agreement Required ☒ YES ☐ NO


☒ Residence No. Bedrooms 4
☐ Business No. Persons
☐ Other No. Employees
☐ Slab ☐ Crawl Space
☒ Basement w/plumbing ☐ Basement w/o plumbing

Water Supply: ☒ Private ☐ Public ☐ Community


Comments / Conditions: 50' SETBACK FROM 760' CONTOUR TO BE STAKED + FLAGGED BEFORE AC MAY BE ISSUED.

Comments / Conditions

INITIAL SITE SKETCH

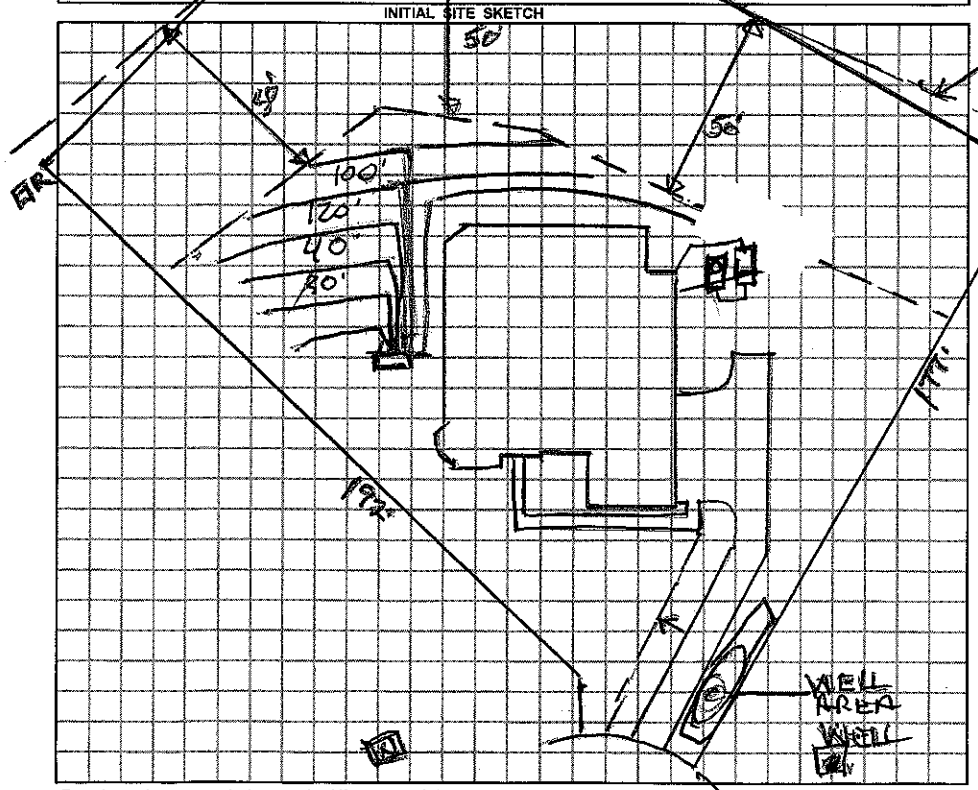

AS BUILT SKETCH

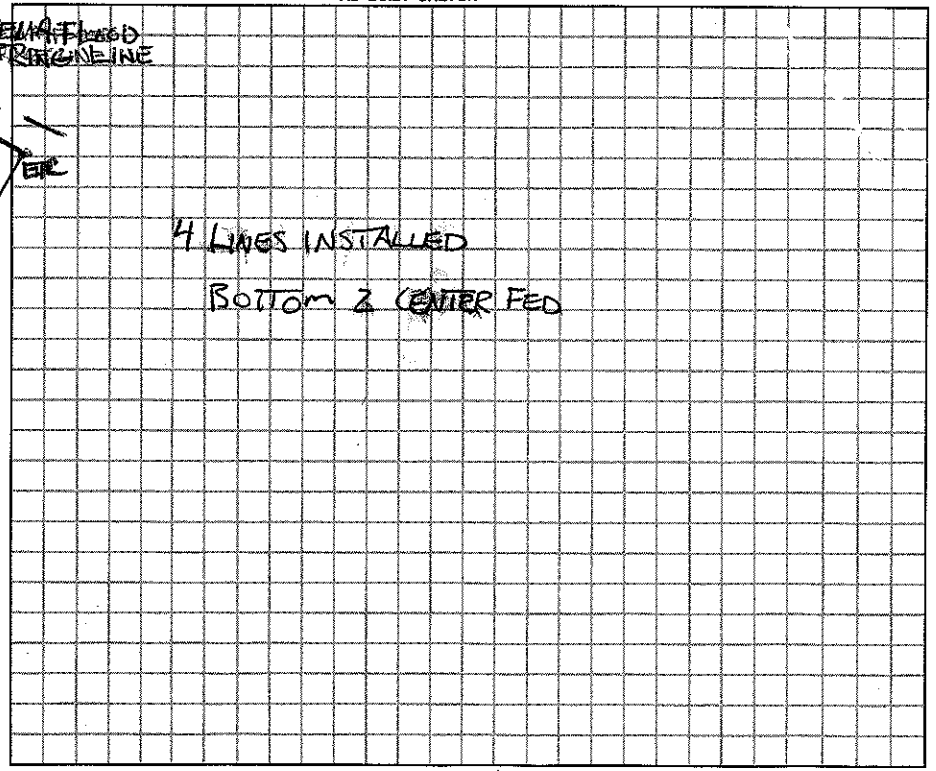

Permit can be suspended or revoked if any false information is supplied toward securing the permit / any unauthorized changes are made to the site / any unauthorized changes are made in the installation of the system.

☐ *IMPROVEMENT PERMIT w / plat valid without expiration.* ☒ *IMPROVEMENT PERMIT w / site plan valid for 60 mos.* ☒ *AUTHORIZATION TO CONSTRUCT valid for period equal to IMPROVEMENT PERMIT-not to exceed 60 mo.*

Owner / Applicant Signature: John P. Campbell Date 6-29-09

Improvement Permit by: Wesley Hankins RS Date 6/29/09

Authorization to Construct by: Wesley Hankins RS Date 6/29/09

YOU SHOULD CONTACT A LOCATOR SERVICE PRIOR TO ANY EXCAVATION.

Installed by: WATER MANAGMENT

Operation Permit by: RS Date: 2-2-10

Existing System Inspected by: Date:

WHITE COPY Environmental Health YELLOW COPY (Final) Owner / Applicant PINK COPY (Initial) Owner / Applicant