IREDELL COUNTY HEALTH DEPARTMENT

STATESVILLE 704-878-5305 MOORESVILLE 704-664-5281

~~2000~~ 11:00

IMPROVEMENT PERMIT / AUTHORIZATION TO CONSTRUCT / OPERATION PERMIT / EXISTING SYSTEM INSPECTION

PERMIT# 80918 PIN# 4624054126 DATE 6/25/99

OWNER OR CONTRACTOR RUTH WATSON PHONE: Business Home

ADDRESS TUSKAROLA DR. MOORESVILLE. NC 28117

LOCATION BRAWLEY SCHOOL - TR TUSCAROLA - ½ ON LT - ~~AT LAKE~~ ON Beaver Creek 3RD on (L)

SUBDIVISION BLOCK / SECTION LOT LOT AREA SITE CLASS. DESIGN FLOW L.T.A.R.

Septic Tank: 1000 Gallons; STB 1012 Date 11/6/99

Pump Tank: 1000 Gallons; PT Date

Pump Make: Hydromatic Model Serial No.

Nitrification Field: No Fields 1 Square Feet 400 Linear Feet 200

No Lines 7 Trench Width 24" Max Trench Bottom Depth 36" Gravel Depth N/A

☑ New System ☐ Repair System Type: I, II, III, IV, V, VI

System Description: PUMP PANEL

Repair System Description: SAME

Maintenance Agreement Required: ☐ Yes ☑ No

☑ House/Mod. Home No. Bedrooms 3

☐ Mobile Home No. Bathrooms 2

☐ Business No. Employees

☐ Other


☐ Slab ☑ Crawl Space ☐ Basement w/plumbing ☐ Basement wo/plumbing

Water Supply: ☑ Individual ☐ Public ☐ Community

Comments:/Conditions: KEEP SYSTEM 10' OFF PROPERTY LINES AND 50' FROM WELL. (6633')

Comments:/Conditions:

INITIAL SITE SKETCH NO SCALE

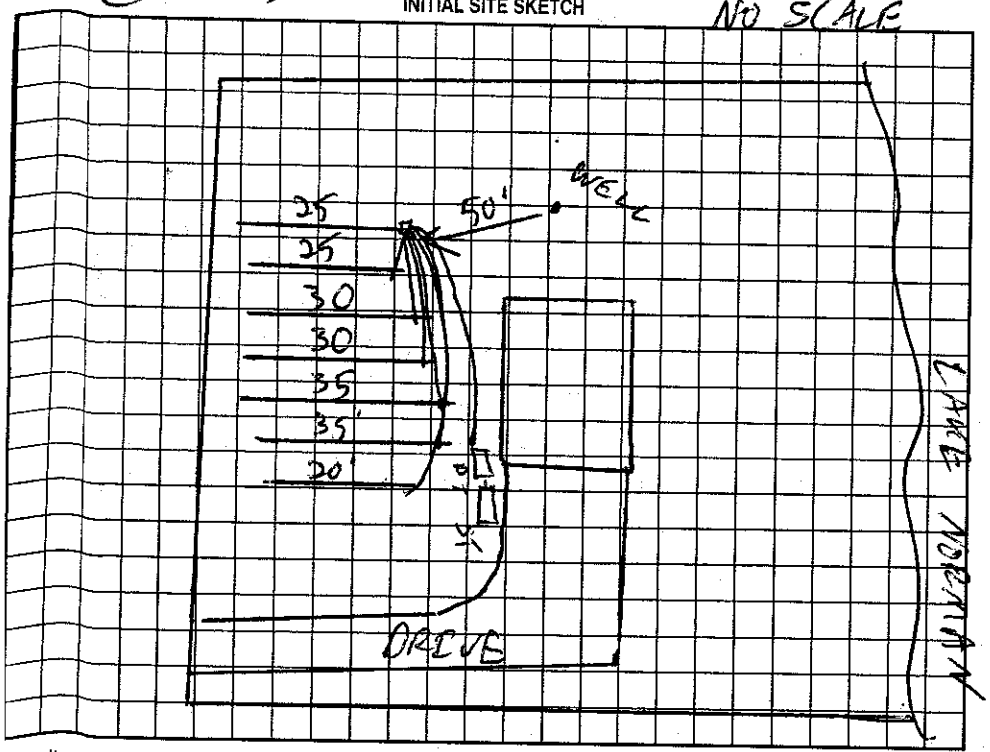

AS BUILT SKETCH

Permit can be suspended or revoked if any false information is supplied toward securing the permit/any unauthorized changes are made to the site/any unauthorized changes are made in the installation of the system. Improvement Permit with plat valid without expiration. Improvement Permit with site plan valid for sixty months. Authorization to Construct is valid for a period equal to that of Improvement Permit – not to exceed sixty months.

Signed: Chuck Willingham date Installed by: A-1 Backhoe

Improvement Permit by: C. [signature] date 6/25/99 Operation Permit by: Maina Dotson RS. date 3/15/2000

Authorization to Construct by: C. [signature] date 6/25/99 Existing System Inspection by: date

HEALTH DEPT. COPY: WHITE OWNER COPY (FINAL): YELLOW OWNER COPY (INITIAL): PINK