
Date Issued 6-1-77 Serial No. 0776 ICAR (S) Permit No. 11852

T C No 001-284-02 A

Map Date 6-4-76

# MECKLENBURG COUNTY
# DEPARTMENT OF ENVIRONMENTAL HEALTH
## INSTALLATION, CONSTUCTION, ALTERATION, AND/OR REPAIR PERMIT
### (Individual Septic Tank System with Subsurface, Soil Absorption, Effluent Discharge)

Permission is hereby given to / Install or Construct, Alter or Repair the individual septic tank wastewater treatment system with subsurface, soil absorption, effluent discharge as specified herein at the described location. This permit is granted based upon the information supplied in application ___ dated ___ and this permit shall be void and of no effect if the information provided in the application is not true or is erroneous. All work shall be completed on or before ___, after which date this permit shall be null and void

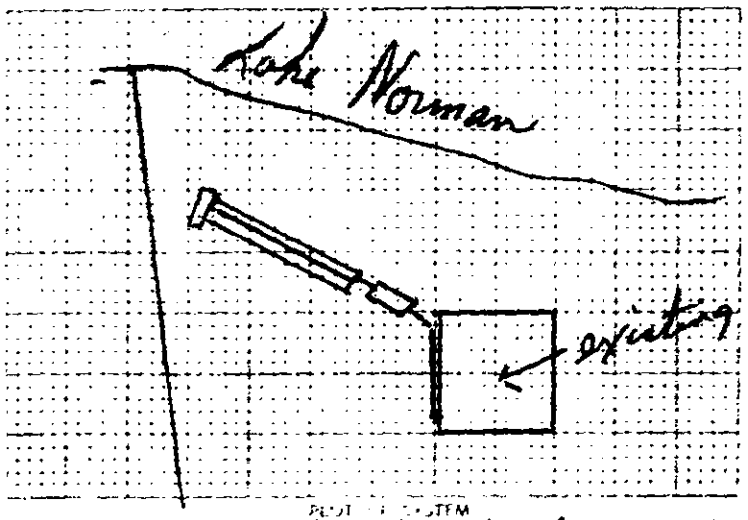


PLOT PLAN OF SYSTEM

Permeability Rate 60

Liquid Capacity of Tank 1500

Tank Construction precast

Area in square feet or Number of Lines

Total Line Length 400 L/ft

Number of Lines 5

Distance from House 10'

Distance from Property Line 10'

Distance from Well 50' +

NAME OF OWNER Whitehurst, James R.

LOCATION OF PROPERTY Fidler Green Lane

This system must meet all of the construction requirements as set forth in the Regulations of the Mecklenburg County Board of Commissioners and be in effect on the date of the granting of this permit. A certificate of approval must be issued by the Environmental Health Department before any system can be covered up or otherwise rendered inaccessible for inspection. **The issuance of this permit does not in any way guarantee that the system anticipated to be constructed will operate properly, or relieve any person** Commission now or hereafter owning, controlling or using such system from any liability resulting from the failure of the system to operate properly.

in bed 12½x80x17" stone - maintain 55' from Tidemark
each line will be added at later date.

John R. Atkisson

Division Head or Authorized Representative Environmentalist

If this permit is for the installation or construction of a new system, it must be signed by the division or a section head of the Department of Environmental Health in order to be valid. Only the signature of the Environmentalist is required where an existing system is being altered or repaired.

EHS-76 Environmental Health Department's Copy