4624062986


Date Issued 6-1-77 Serial No. 0776 ICAR(S) Permit No. 11852

T C No 001-284-02A

Map Date 6-4-76

MECKLENBURG COUNTY
DEPARTMENT OF ENVIRONMENTAL HEALTH
INSTALLATION, CONSTUCTION, ALTERATION, AND/OR REPAIR PERMIT
(Individual Septic Tank System with Subsurface, Soil Absorption, Effluent Discharge)

Permission is hereby given to / Install or Construct, Alter or Repair the individual septic tank wastewater treatment system & the subsurface, soil absorption, effluent discharge as specified herein at the described location. This permit is granted based upon the information supplied in application ... dated ... and this permit shall be void and of no effect if the information provided in the application is in any material respect false or incorrect. All work shall be completed on or before ..., after which date this permit shall be null and void

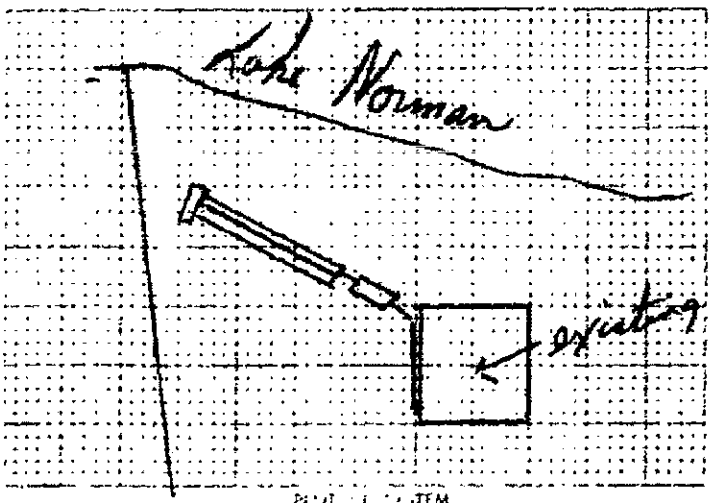

PLOT PLAN OF SYSTEM

Permeability Rate 60

Liquid Capacity of Tank 1500 g

Tank Construction precast

Absorption Area or Number of Lines

Total Line Length 400 L/Ft

Number of Lines 5

Distance from House 10'

Distance from Property Line 10'

Distance from Well 50' +

NAME OF OWNER Whitehurst, Jame R.

LOCATION OF PROPERTY Fidler Green Lane

The ... feet of the construction requirements as set forth in the Regulations of the Mecklenburg County Board of Commissioners and in effect on the date of the granting of this permit. A certificate of approval will be issued by the Environmental Health Division before the system can be covered up or otherwise placed in operation. **The issuance of this permit does not in any way guarantee that the system anticipated to be constructed will operate properly, or relieve any person now or hereafter owning, controlling or using such system from any liability resulting from the failure of the system to operate properly.**

in bed 12½ x 80 x 17" stone - maintain 55' from Branch
wash line will be added at later date.

John R Atkisson
Person Approving Permit — Environmentalist

If this permit is for the installation or construction of a new system, it must be signed by the division or a section head of the Department of Environmental Health in order to be valid. Only the signature of the Environmentalist is required where an existing system is being altered or repaired.

EHD-74 — Environmental Health Department's Copy

The proposed / existing PORCH / DECK addition does not appear to impact the existing septic system.
**NOTE: MUST BE MIN 5' FROM SEPTIC R.S.

Date: APPROVED JUN 11 2014
ICHD-Environmental Health Division

SEE INSTRUCTIONS ON BACK

Date Received 6-1-77

ICARIS Application No. 1852

T C No 00L-281-32M


Map Date 6-4-76

MECKLENBURG COUNTY
DEPARTMENT OF ENVIRONMENTAL HEALTH

Application for an
Installation, Construction, Alteration, and/or Repair Permit
Individual Septic Tank System with Subsurface, Soil Absorption, Effluent Discharge

This application, as indicated hereinafter hereto, applies to the Mecklenburg County Department of Environmental Health for a permit to

1 ✓ Install a Conventional System Alter or Repair an individual septic tank wastewater treatment system with a subsurface soil absorption effluent discharge

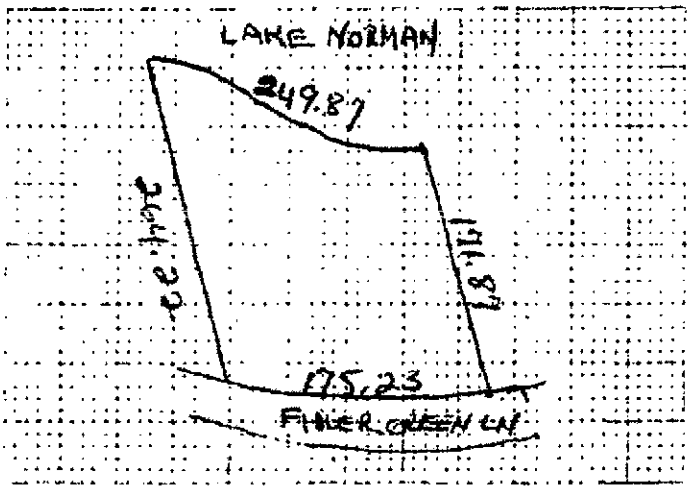

3. PLOT PLAN (ACCURATELY DIMENSIONED)

Mobile Home ✓ No.
Residence ✓ No.
4. No. of Bedrooms 2
5. Water Co. Map No.
Emergency
6. Within Mobile Yes
Garbage Disposal Yes
8. Other Yes
9. Water Supply
Air Conditioning Cond.
Swimming Pool
Swimming Pool Supply
Fencing Screen
Is the nearest building ... feet
Is public sewer Yes ✓ No
Is any part of the system within 200 feet of any public sewer Yes ✓ No
11. FHA Case No.
12. VA Case No.

13. NAME OF OWNER WHITEHURST (Last) JAMES (First) RENARD (Middle)

14. ADDRESS OF OWNER 3025 AIRLIE ST. CHARLOTTE, NC 28205

15. PHONE NO. Home 536-7689 Office 568-4251 EXT 390

16. LOCATION OF SYSTEM FIDLER GREEN LANE (Street or County Road)

17. SUBDIVISION LAKE NORMAN Lot No 220 Block No. 6

Map Book No. Page No.

18. DEED REFERENCE — DEED BOOK AT PAGE

19. HAS A SOIL INVESTIGATION BEEN RUN? YES NO DATE RUN 2/3/77 → 6/6

20. PTR NUMBER (See Instructions) 1852

The undersigned person hereby agrees that he has read the foregoing application and that the contents of same are true. It is understood that any permit applied for herein shall be void and of no effect if any of the above facts are not true.

5-31-77
DATE OF APPLICATION

James R. Whitehurst
OWNER

1 EHS 5 76

Environmental Health Department's Copy