Paid 550.00

IREDELL COUNTY HEALTH DEPARTMENT

STATESVILLE 704-878-5305 MOORESVILLE 704-664-5281

IMPROVEMENT PERMIT / AUTHORIZATION TO CONSTRUCT / OPERATION PERMIT / EXISTING SYSTEM INSPECTIO

PERMIT# 139452 PIN# 4624 06 3072 DATE 12/8/06

OWNER OR APPLICANT Kenneth Beaver Homes, Inc PHONE: Business 704-662-6400 Home

ADDRESS PO Box 3398 Mooresville, NC. 28117

LOCATION 1100 Tr Tuckaseegee TR Binns Rd. property on (R) Corner

SUBDIVISION BALMORAL PARK BLOCK / SECTION LOT 1 LOT AREA 1.701 SITE CLASS AC DESIGN FLOW 480 L.T.A.R. .3

Septic Tank: 1000 Gallons: STB Date

Pump Tank: 1000 Gallons: PT Date

Pump Make: Model Serial No.

Nitrification Field: No Fields 1 Square Feet 580 Linear Feet 890

No Lines 5 Trench Width 2' Max Trench Bottom Depth 3'

[X] New System [ ] Repair [ ] Expansion System Type: I II III (IV) V VI

System Description: LP - 16" PABPS

Repair System Description: SAME TYPE

Maintenance Agreement Required: [X] Yes [ ] No

[X] House/Mod. Home No. Bedrooms 4

[ ] Mobile Home No. Persons

[ ] Business No. Employees

[ ] Other

Water Supply: [X] Individual [ ] Public [ ] Community


Gravel Depth No [ ] Gravity [X] Pressure [ ] Slab [X] Crawl Space [ ] Basement w/plumbing [ ] Basement wo/plumbing

Comments:/Conditions:


Comments:/Conditions:

1" = 50'

INITIAL SITE SKETCH

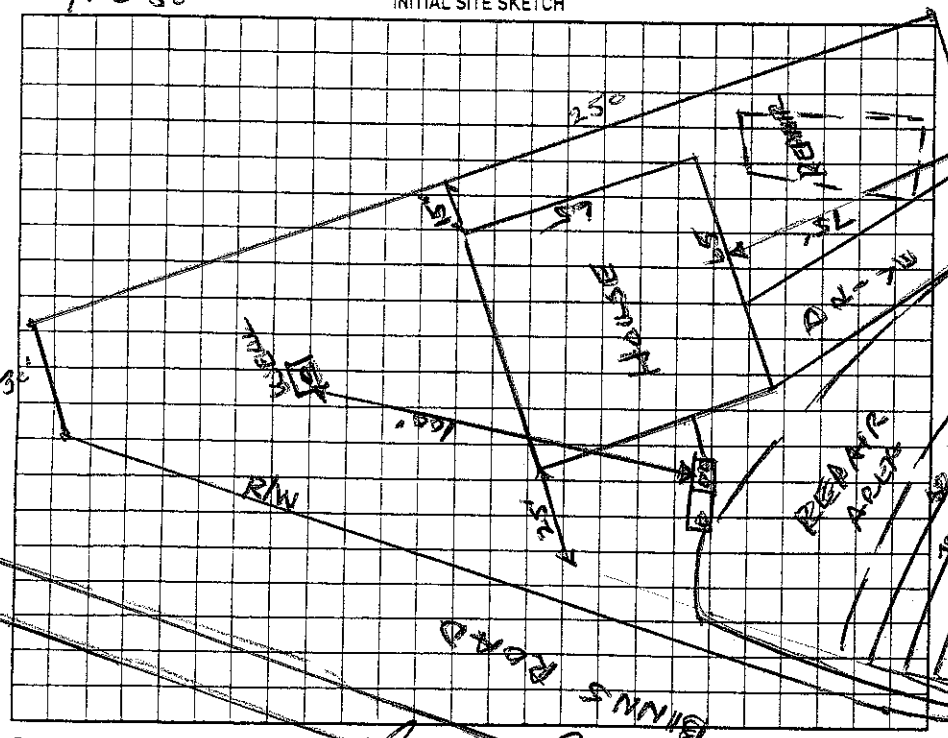

AS BUILT SKETCH

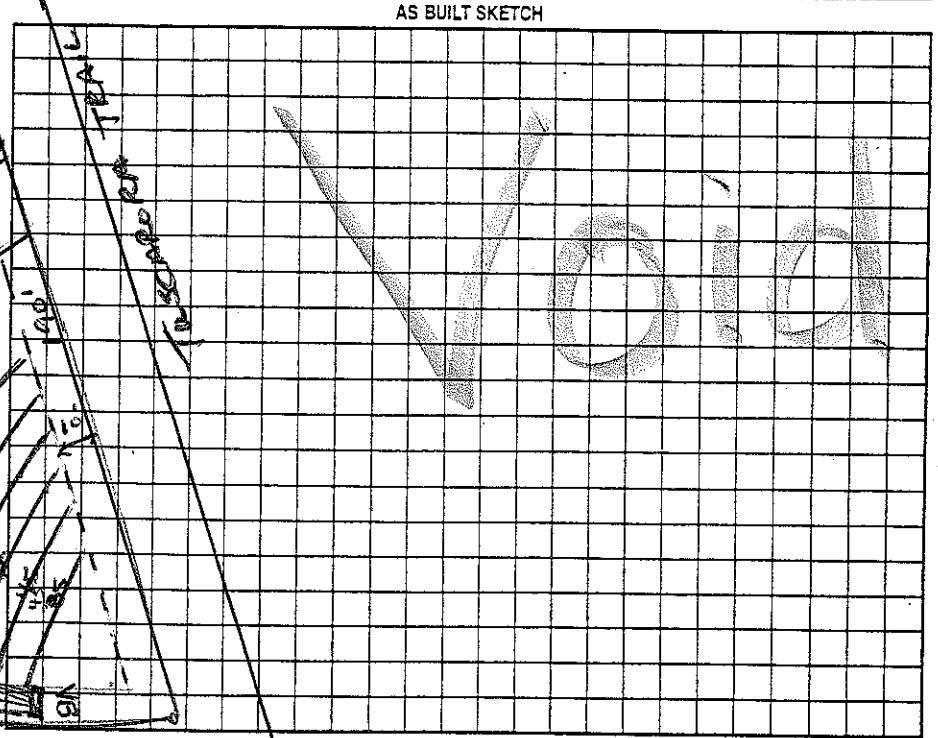

Permit can be suspended or revoked if any false information is supplied toward securing the permit/any unauthorized changes are made to the site/any unauthorized changes are made in the installation of the system. Improvement Permit with plat valid without expiration ☐ Improvement Permit with site plan valid for sixty months ☐ Authorization to Construct is valid for a period equal to that of Improvement Permit – not to exceed sixty months.

Signed: [signature] date 12-12-06 Installed by:

Improvement Permit by: Wesley Sparks RS date 12/8/06 Operation Permit by: date

Authorization to Construct by: Wesley Sparks RS date 12/8/06 Existing System Inspection by: date

HEALTH DEPT. COPY: WHITE OWNER COPY (FINAL): YELLOW OWNER COPY (INITIAL): PINK