IREDELL COUNTY HEALTH DEPARTMENT

Statesville Office (704) 878-5205 ~~Mooresville Office (704) 660-3625~~ PERMIT # 174645

IMPROVEMENT PERMIT / AUTHORIZATION TO CONSTRUCT / OPERATION PERMIT / EXISTING SYSTEM

PIN # 4624-06-4059

APPLICANT: JASON SLAGLE APPLICANT ADDRESS: 840 EDMINSTON RD MT. ULLA

SITE ADDRESS: 248 TUSK TR PHONE: 704-400-6472 ALT. PHONE:

SITE DIRECTIONS: BSR, TUSK TR., ON R

SUBDIVISION: BALMORAL PARK SECTION: LOT # 2 LOT AREA: .1698 AC DESIGN FLOW: 480 L.T.A.R.: .3

Septic Tank 1000 (gal) STB 32 Date 10-8-12

Pump Tank (gal) PT Date

Pump Make Model Serial #

Nitrification Fields 1 # Lines 5 Linear Ft: 400'

Trench Width 36" Max. Trench Bottom Depth 40" Gravel Depth —

[X] New System [ ] Repair [ ] Expansion System Type: I II (III) IV V VI

System Description: 25% REDUCTION

Repair System Description: LP- PANEL BLOCK

Maintenance Agreement Required: [ ] YES [X] NO

[X] GRAVITY [ ] PRESSURE

[X] Residence No. Bedrooms 4

[ ] Business No. Persons

[ ] Other No. Employees

[X] Slab [ ] Crawl Space

[ ] Basement w/plumbing [ ] Basement w/o plumbing

Water Supply: [X] Private [ ] Public [ ] Community

Comments / Conditions:

INITIAL SITE SKETCH

SEE APPROVED PLAN BY CAROLINA SOIL & SEPTIC CONSULTING

AS BUILT SKETCH


Permit can be suspended or revoked if any false information is supplied toward securing the permit / any unauthorized changes are made to the site / any unauthorized changes are made in the installation of the system. **CONTACT A LOCATOR SERVICE PRIOR TO ANY EXCAVAT**

[X] **IMPROVEMENT PERMIT** *with plan valid without expiration.* [ ] **IMPROVEMENT PERMIT** *with site plan valid for 60 mos.* [X] **AUTHORIZATION TO CONSTRUCT** *valid for period equal to IMPROVEMENT PERMIT--not to exceed 60*

Owner / Applicant Signature: Date: 12-20-12 Installed by: ORBISON

IMPROVEMENT PERMIT by: Date: 12-19-12 OPERATION PERMIT by: Date: 12-28-1

AUTHORIZATION TO CONSTRUCT by: Date: 12-19-12 Existing System Inspected by: Date:

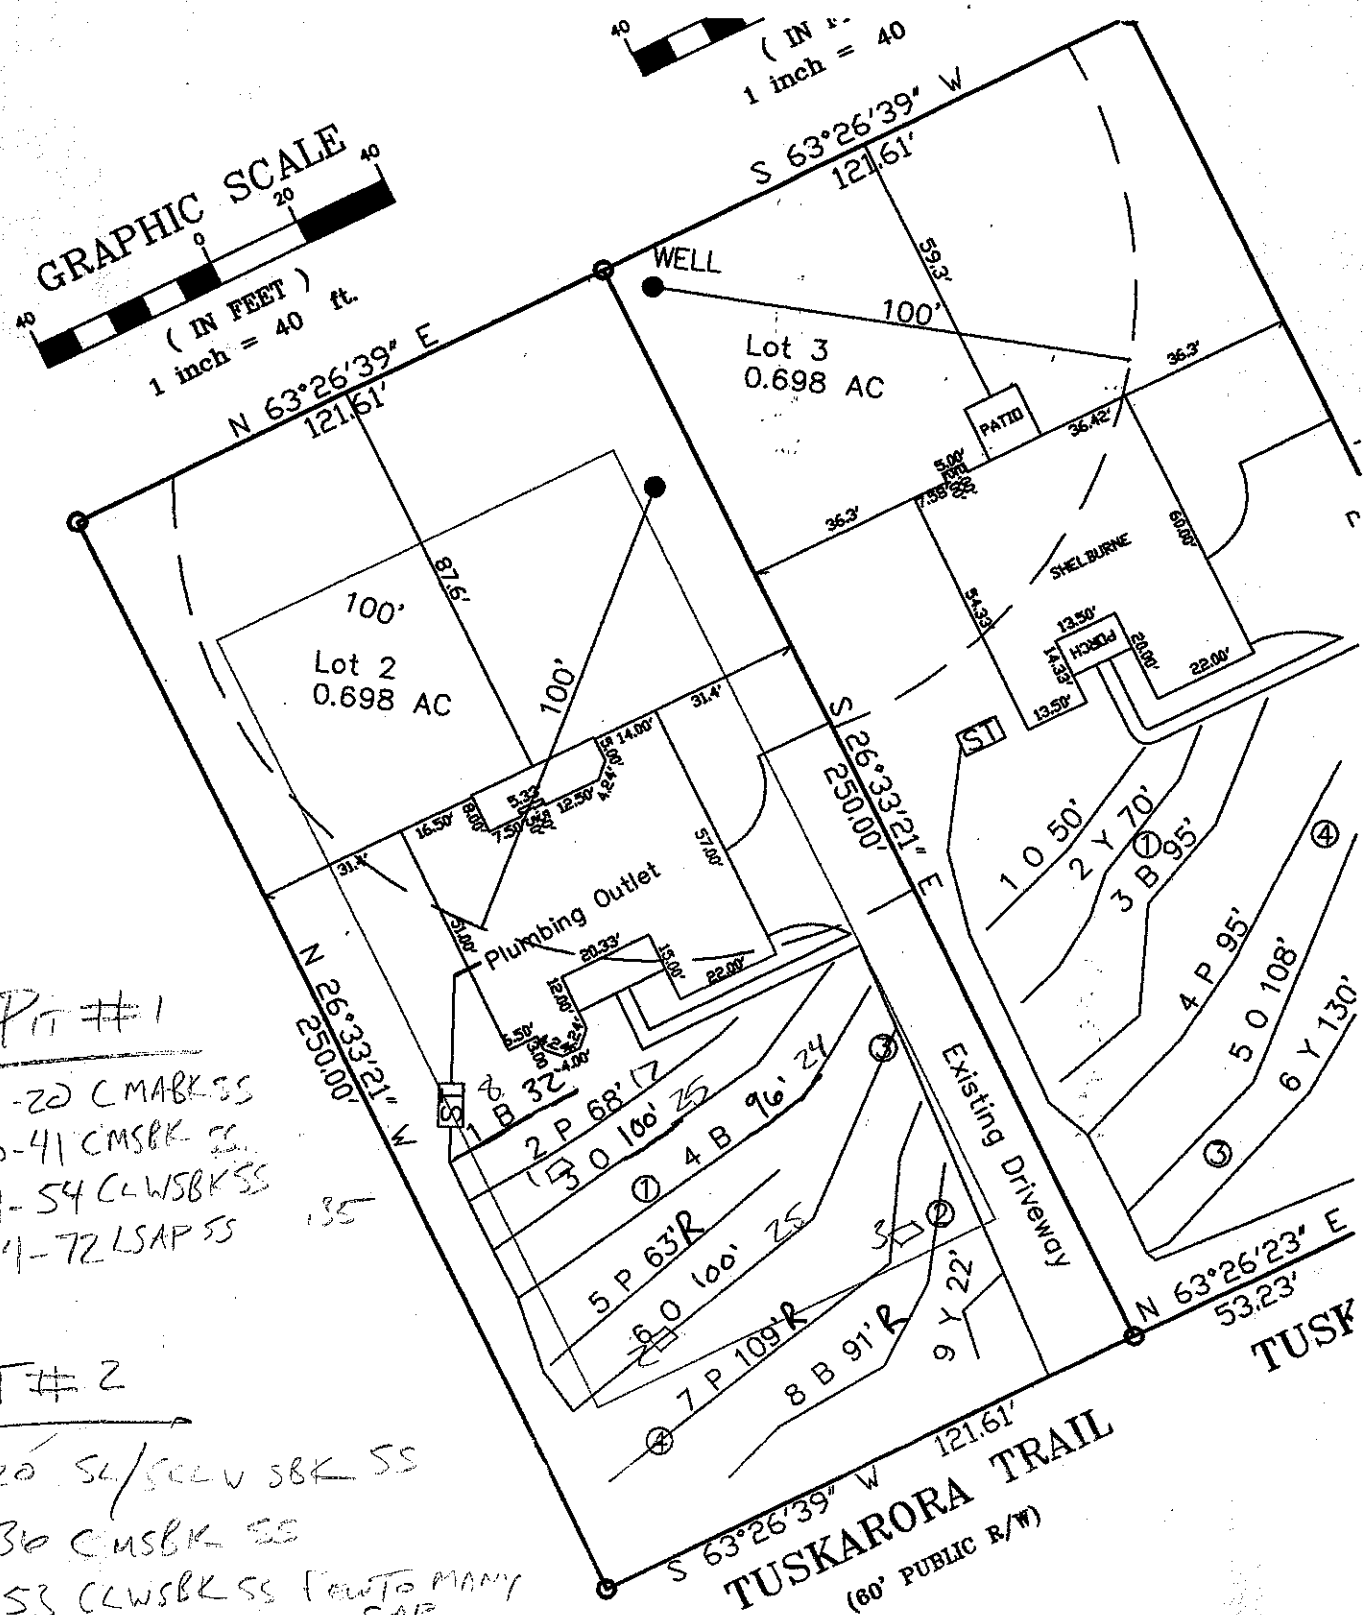

PIT #1

0-20 CMABK SS
20-41 CMSBK SS
41-54 CLWSBK SS
54-72 LSAP SS

.35

PIT #2

0-20 SL/CLWSBK SS
20-36 CMSBK SS
36-53 CLWSBK SS (UP TO MANY SAP)
53-73 LSAP W/ CINC SS

.35

PIT #3

0-21 CMABK SS
21-41 CLWSBK SS

.35