IREDELL COUNTY ...LTH DEPARTMENT

STATESVILLE 704-878-5305 MOORESVILLE 704-664-5281

IMPROVEMENT PERMIT / AUTHORIZATION TO CONSTRUCT / OPERATION PERMIT / EXISTING SYSTEM INSPECTION

Quick 4 2:00

PERMIT# 140098 PIN# 4624067118.000

OWNER OR APPLICANT Kennell Bealer Homes Inc PHONE: Business 704 662-6400 Home DATE 12/20/07

ADDRESS PO Box 3398 Mooresville NC 28117

LOCATION Brawley School Rd. TR Tuskarora Corner of Balmoral Dr.

SUBDIVISION Balmoral Park BLOCK / SECTION LOT 4 LOT AREA ±.699 SITE CLASS. PS DESIGN FLOW L.T.A.R. ±25

Septic Tank: 1000 Gallons: STB 312 Date 10-7-07

Pump Tank: Gallons: PT Date

Pump Make: Model Serial No.

Nitrification Field: No. Fields 1 Square Feet 1080 Linear Feet 360'

No. Lines 4@90' Trench Width 36" Max Trench Bottom Depth ~~36~~ 24" Gravel Depth N/A

☑ New System ☐ Repair ☐ Expansion System Type: I II III IV V VI

System Description: Gravity 25% Reduction

Repair System Description: LPP PBPS

Maintenance Agreement Required: ☐ Yes ☑ No

☑ House/Mod. Home No. Bedrooms 3

☐ Mobile Home No. Persons

☐ Business No. Employees

☐ Other


Water Supply: ☑ Individual ☐ Public ☐ Community

☐ Gravity ☑ Pressure ☐ Slab ☑ Crawl Space ☐ Basement w/plumbing ☐ Basement wo/plumbing


Comments:/Conditions: * Keep system 24" max depth
Use D box with flow levelers for equal distribution
Keep well 100' min from septic system 50' min from proposed Repair area.

Comments:/Conditions: 12/21/07 House plans essentially same as IP showing 3 Bedrooms A.C.
2 lines @ 88Ft 2 lines @ 92 Ft

INITIAL SITE SKETCH 250'

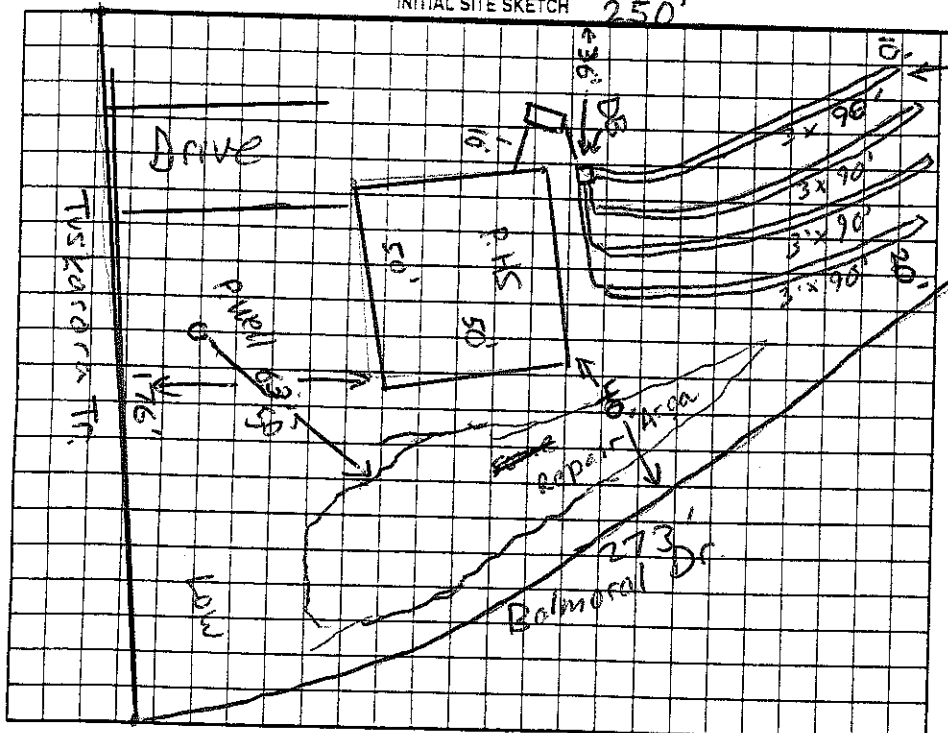

AS BUILT SKETCH

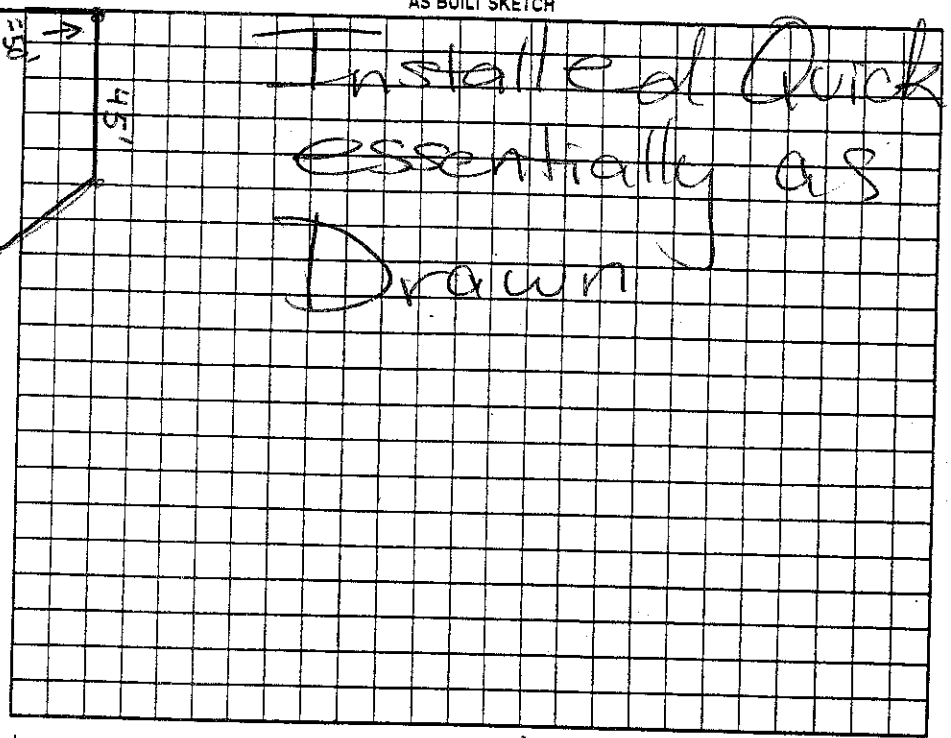

Permit can be suspended or revoked if any false information is supplied toward securing the permit/any unauthorized changes are made to the site/any unauthorized changes are made in the installation of the system. Improvement Permit with plat valid without expiration ☐ Improvement Permit with site plan valid for sixty months ☑ Authorization to Construct is valid for a period equal to that of Improvement Permit – not to exceed sixty months.

Signed: [signature] date 12/21/07

Improvement Permit by: Anthony Coley Jr date 12/20/07

Authorization to Construct by: Anthony Coley Jr date 12/21/07

Installed by: R&H

Operation Permit by: [signature] date 5/22/08

Existing System Inspection by: date

HEALTH DEPT. COPY: WHITE OWNER COPY (FINAL): YELLOW OWNER COPY (INITIAL): PINK