ICHD - ENVIRONMENTAL HEALTH DIVISION

Statesville Office (704) 878-5305 | Mooresville Office (704) 660-3625 | PERMIT # OSWP 2023-38807

SEPTIC: IMPROVEMENT PERMIT / AUTHORIZATION TO CONSTRUCT / OPERATION PERMIT / EXISTING SYSTEM

PIN # 4624 -- 06 -- 8328

APPLICANT/OWNER: Douglas Jones | APPLICANT ADDRESS: 108 Balmoral Dr. Mooresville 28117

SITE ADDRESS: 108 Balmoral Dr., Mooresville 28117 | PHONE: | ALT. PHONE

SITE DIRECTIONS: Brawley School - (R) Tuskarura Tr. - (R) Balmoral - Lot on (R) | SAP CONTROLLED: ☐ YES ☐ NO

SUBDIVISION: C.L.&T. | SECTION: 10 | LOT # 215 | LOT AREA: 0.73 | DESIGN FLOW: | L.T.A.R.: Ex.

Septic Tank 1000 (gal) STB 760 Date 9/16/23
Pump Tank (gal) PT Date
Pump Make Model Serial #
Nitrification Fields Ex # Lines Ex Linear Ft Ex
Trench Width Ex Trench Bottom Depth(Low side) Ex Gravel Depth Ex


☐ New System ☑ Repair ☐ Expansion System Type: (II) III IV V VI
System Description:
Repair System Description: Tank Replacement
Maintenance Agreement Required: ~~YES~~ ~~NO~~
☑ GRAVITY ☐ PRESSURE

☑ Residence ☐ Business ☐ Other ☐ Slab ☐ Basement w/plumbing
No. Bedrooms 2 No. Persons 4 No. Employees
☑ Crawl Space ☐ Basement w/o plumbing

Water Supply: ☑ Private ☐ Public ☐ Community

Comments / Conditions: Replace distribution as needed. Owner to turn off irrigation, divert all drainage away from system, & check for water leaks inside house.

INITIAL SITE SKETCH

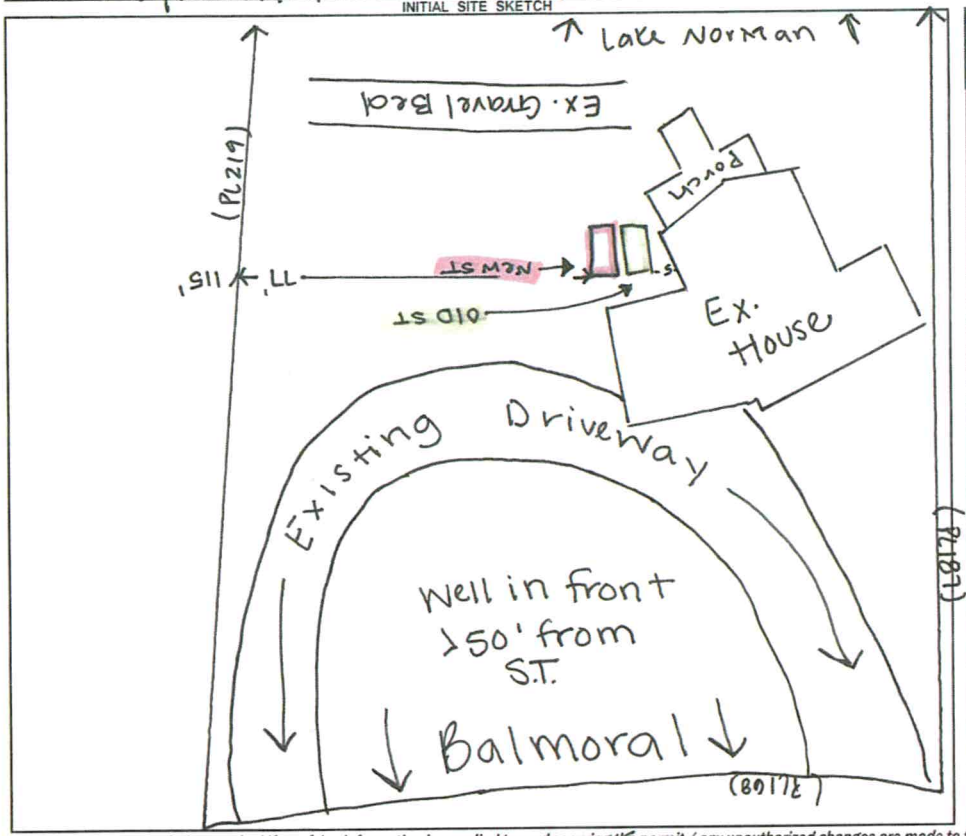

AS BUILT SKETCH

FOR SEPTIC FINAL INSPECTION CALL: 704-664-3703 between 8am-9am the day the inspection is needed. Be sure to speak with an inspector to confirm your time.

★ Replace distribution as needed

1"=40'

Installed as Drawn

Permit can be suspended or revoked if any false information is supplied toward securing the permit / any unauthorized changes are made to the site / any unauthorized changes are made in the installation of the system. CONTACT A LOCATOR SERVICE PRIOR TO ANY EXCAVATION

☐ IMPROVEMENT PERMIT *with plat valid without expiration.* ☑ IMPROVEMENT PERMIT *with site plan valid for 60 mos.* ☑ AUTHORIZATION TO CONSTRUCT *valid for period equal to IMPROVEMENT PERMIT--not to exceed 60 mo.*

Owner / Applicant Signature: online Date: —

IMPROVEMENT PERMIT by: Sydney Holland Date: 10/18/23

AUTHORIZATION TO CONSTRUCT by: Sydney Holland Date: 10/18/23

Installed by: Abernathy

OPERATION PERMIT by: Cory Wirt Date: 11/3/23

Existing System Inspected by: Date:

FOR SEPTIC FINAL INSPECTION: CALL 704-664-3703 between 8am-9am the day the inspection is needed.