IREDELL COUNTY HEALTH DEPARTMENT

STATESVILLE 704-878-5305 MOORESVILLE 704-664-5281

IMPROVEMENT PERMIT / AUTHORIZATION TO CONSTRUCT / OPERATION PERMIT / EXISTING SYSTEM INSPECTION

PERMIT# 133456 PIN# 4624070322 DATE 2-1-06

OWNER OR APPLICANT ABJ Construction, Inc. / James Jolly PHONE: Business 704-664-4353 Home

ADDRESS 1184 Brawley School Rd Mooresville 28115

LOCATION Brawley School Rd TR Tuscarora TR Balmoral on right near end 172 Balmoral Dr.

SUBDIVISION Neck Neek BLOCK / SECTION LOT 223 LOT AREA .9 Ac SITE CLASS. PS DESIGN FLOW 120gpd L.T.A.R. .3gpd/ft²

Septic Tank: existing Gallons: STB Date

Pump Tank: existing Gallons: PT Date

Pump Make: Model Serial No.

Nitrification Field: No Fields 1 Square Feet Linear Feet 70

No Lines 2@35' Trench Width 24" Max Trench Bottom Depth 36" Gravel Depth NA ☐ Gravity ☒ Pressure

☐ New System ☐ Repair ☒ Expansion System Type: I II III IV V VI

System Description: LP PPBPS

Repair System Description: LP PPBPS

Maintenance Agreement Required: ☒ Yes ☐ No

☒ House/Mod. Home No. Bedrooms 1

☐ Mobile Home No. Persons

☐ Business No. Employees

☐ Other

Water Supply: ☒ Individual ☐ Public ☐ Community

☐ Slab ☐ Crawl Space ☑ Basement w/plumbing ☐ Basement wo/plumbing

Comments:/Conditions:

Install lines 6 & 7 as per design of Rollans S&E services plan


Comments:/Conditions:

Lines Checked 4-13-06 JM
Pressure checked 4-24-06 JM
all 4 lines checked for pressure.

INITIAL SITE SKETCH

Refer to site sketch
Rollans Soil & Environmental
Services

AS BUILT SKETCH

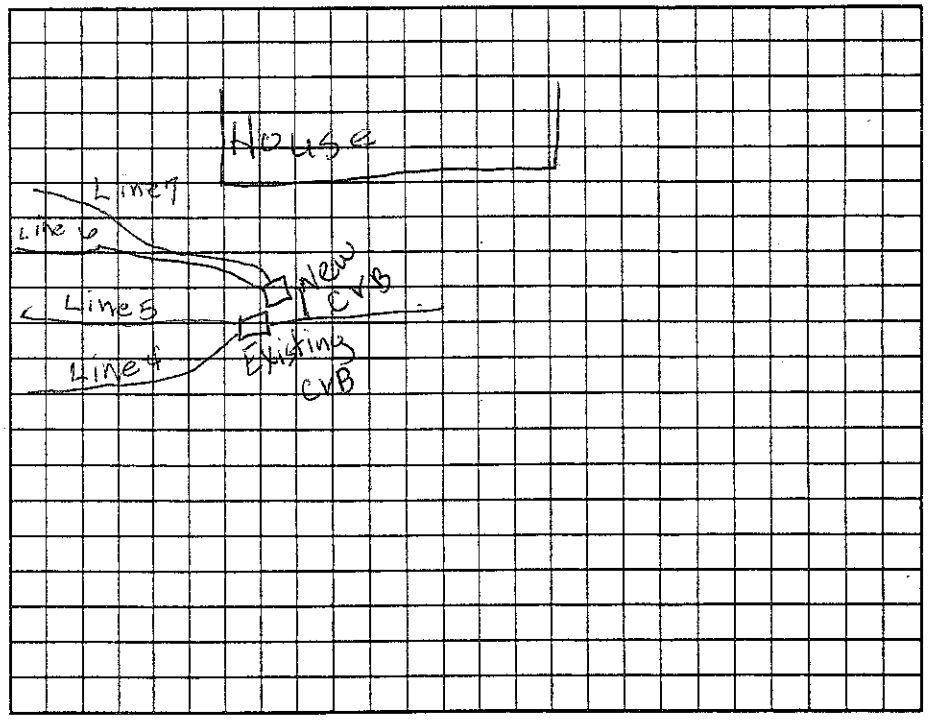

Permit can be suspended or revoked if any false information is supplied toward securing the permit/any unauthorized changes are made to the site/any unauthorized changes are made in the installation of the system. Improvement Permit with plat valid without expiration. Improvement Permit with site plan valid for sixty months ☒ Authorization to Construct is valid for a period equal to that of Improvement Permit – not to exceed sixty months.

Signed: ABJ By [signature] date 2-3-06

Improvement Permit by: Judy Melville date 2-2-06

Authorization to Construct by: Judy Melville date 2-2-06

Installed by: FJ Ervin

Operation Permit by: Judy Melville date 4-24-06

Existing System Inspection by: date

HEALTH DEPT. COPY: WHITE OWNER COPY (FINAL): YELLOW OWNER COPY (INITIAL): PINK