STATESVILLE 704-878-5305 MOORESVILLE 704-664-5281

# IMPROVEMENT PERMIT / AUTHORIZATION TO CONSTRUCT / OPERATION PERMIT / EXISTING SYSTEM INSPECTION

PERMIT# 103744 PIN# 4624-07-0322 DATE

OWNER OR CONTRACTOR ABS Const / James Tally PHONE: Business 704-664-4853 Home

ADDRESS 2829 Pine Ridge Rd Cleveland WI 54409

LOCATION BSR, TR Tuscarora, TR Balmoral, Near end on Rt. 172 Elmore

SUBDIVISION BLOCK / SECTION LOT LOT AREA SITE CLASS PS DESIGN FLOW 360 L.T.A.R. 0.5

Septic Tank: 1000 Gallons: ST8 3/2 Date 9/16/03
Pump Tank: 1000 Gallons: PT 27 Date 9/30/03
Pump Make: Goulds Model WE 07124 Serial No.
Nitrification Field: No Fields 1 Square Feet 600 Linear Feet 200
No Lines 2 Trench Width 24" Max Trench Bottom Depth 36" Gravel Depth

☒ New System ☐ Repair System Type: I, II, III, (IV), V, VI
System Description: CP Panel Block
Repair System Description: Stone
Maintenance Agreement Required: ☒ Yes ☐ No


☒ House/Mod. Home No. Bedrooms 3
☐ Mobile Home No. Bathrooms 3
☐ Business No. Employees
☐ Other
☐ Slab ☐ Crawl Space ☒ Basement w/plumbing ☐ Basement wo/plumbing

Water Supply: ☒ Individual ☐ Public ☐ Community

Comments/Conditions: (*) Power line crosses Lower line - a section of solid ground Left around Power Line and solid pipe to the rest of the Trench.

Comments/Conditions: 45 panels 3/16" holes

INITIAL SITE SKETCH

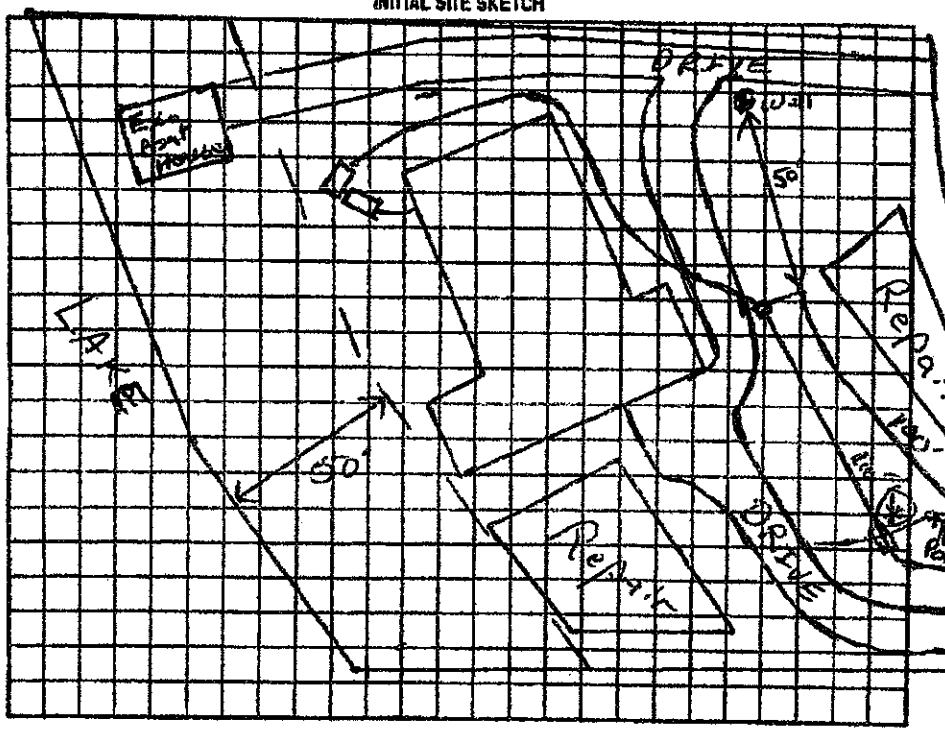


1"=50'

AS BUILT SKETCH

Permit can be suspended or revoked if any false information is supplied toward securing the permit/any unauthorized changes are made to the site/any unauthorized changes are made in the installation of the system. Improvement Permit with plat valid without expiration. Improvement Permit with site plan valid for sixty months. Authorization to Construct is valid for a period equal to that of Improvement Permit – not to exceed sixty months.

Signed: Jerry McNeil date 10/2/03 Installed by: F T Ervin

Improvement Permit by: RS date 10/20/03 Operation Permit by: date

Authorization to Construct by: RS date 10/20/03 Existing System Inspection by: date

HEALTH DEPT COPY: WHITE OWNER COPY (FINAL): YELLOW OWNER COPY (INITIAL): PINK