Meck Neck

IREDELL COUNTY HEALTH DEPARTMENT

STATESVILLE 704-878-5305 MOORESVILLE 704-664-5281

IMPROVEMENT PERMIT / AUTHORIZATION TO CONSTRUCT / OPERATION PERMIT / EXISTING SYSTEM INSPECTION

PERMIT# 125979 PIN# 4624072019 DATE 1-17-08

OWNER OR APPLICANT Richard & Joan McCullock PHONE: Business 704-287-4540 Home 704-362-1169

ADDRESS 415 Jefferson Dr Charlotte NC 28270

LOCATION Brawley School Rd TR Tuscarora Trail TR Balmoral on right

SUBDIVISION CL+T BLOCK / SECTION 6 LOT 221 LOT AREA .79 Ac SITE CLASS. DESIGN FLOW L.T.A.R.

Septic Tank: Existing Gallons: STB Date

Pump Tank: Gallons: PT Date

Pump Make: Model Serial No

Nitrification Field: No Fields Square Feet Linear Feet

No Lines Trench Width Max Trench Bottom Depth Gravel Depth ☒ Gravity ☐ Pressure

☐ New System ☐ Repair ☐ Expansion System Type: I ☒ II III IV V VI

System Description: Existing conventional

Repair System Description: Max feasible Rule .1945

Maintenance Agreement Required: ☐ Yes ☒ No

☒ House/Mod. Home No. Bedrooms 3

☐ Mobile Home No. Persons 6

☐ Business No. Employees

☐ Other

Water Supply: ☒ Individual ☐ Public ☐ Community


☐ Slab ☒ Crawl Space ☐ Basement w/plumbing ☐ Basement wo/plumbing

Comments:/Conditions:

Comments:/Conditions: Plat recorded 1976 CL&T Sec. 6 #221.
Existing system permit - refer to: Meck. Co. 3/18/94
file # 21594 3 bd. system, 4 lines @ 100', 12" stone
1500 ST

INITIAL SITE SKETCH

AS BUILT SKETCH 1"=50' 188.58'

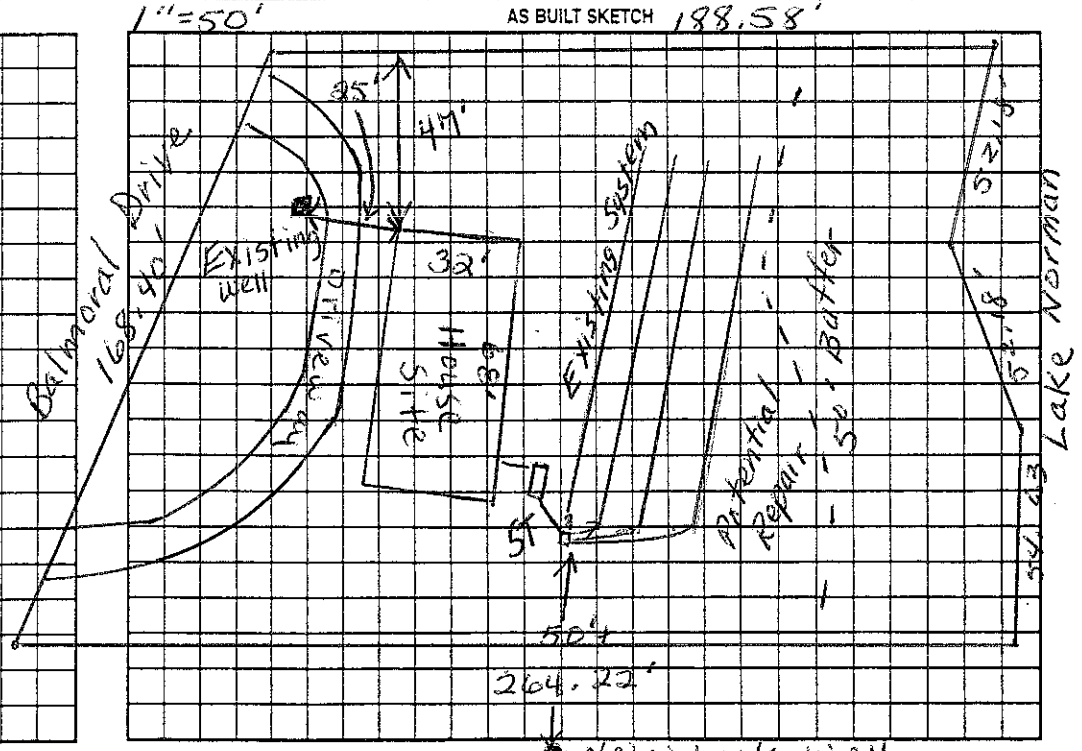

Permit can be suspended or revoked if any false information is supplied toward securing the permit/any unauthorized changes are made to the site/any unauthorized changes are made in the installation of the system. Improvement Permit with plat valid without expiration ☐ Improvement Permit with site plan valid for sixty months ☐ Authorization to Construct is valid for a period equal to that of Improvement Permit – not to exceed sixty months.

Signed: Jane Ogburn date 1-22-08 Installed by:

Improvement Permit by: date Operation Permit by: date

Authorization to Construct by: date Existing System Inspection by: Jerry Melville date 1-17-08

HEALTH DEPT. COPY: WHITE OWNER COPY (FINAL): YELLOW OWNER COPY (INITIAL): PINK