IREDELL COUNTY HEALTH DEPARTMENT

STATESVILLE 704-878-5305 MOORESVILLE 704-664-5281

IMPROVEMENT PERMIT / CERTIFICATE OF COMPLETION / OPERATION PERMIT / EXISTING SYSTEM INSPECTION

PROPERTY DESCRIPTION NO. 17376 DATE Nov. 4, '93 TAX MAP NO. 3D-1-A-166 4624 09 0320 Watershed: ☑ Yes ☐ No

OWNER OR CONTRACTOR Dan & Kathy Mathis / ABJ Const. PHONE: Business ABJ 664-4353 Home L.N.

ADDRESS Rt 9, Box 425, Mooresville

LOCATION 1100 TR. 1236 (Stonemarker) BEAR left at forks, then Rt on Stonemarker West TR Canterbury 1st on left

SUBDIVISION Crescent / Lake Norman BLOCK / SECTION 6 LOT 166 LOT AREA ~ 3/4 Ac. SITE CLASS. B on 1952 DESIGN FLOW 360 gpd L.T.A.R. .03

Septic Tank: 1000 Gallons; STB 794 Bellanger Date 5-5-94

Pump Tank: 1000 Gallons; PT 27 Bellanger Date 6-1-94

Pump Make: Zoeller Model N-161-C Serial No.

Nitrification Field: No Fields 1 Square Feet 1200 Linear Feet 400

No Lines 7 Trench Width 36" Max Trench Bottom Depth 30" Gravel Depth 12"

☑ New System ☐ Repair System Type: I, II, (III) IV, V, VI

System Description: pump to p.m. / Conv. trenches

Repair System Description: LP PRBPS

Maintenance Agreement Required: ☐ Yes ☑ No

☑ House/Mod. Home No. Bedrooms 3

☐ Mobile Home No. Bathrooms 3½

☐ Business No. Employees

☐ Other


☐ Slab ☑ Crawl Space ☐ Basement w/plumbing ☐ Basement wo/plumbing

Water Supply: ☑ Individual ☐ Community ☐ Public


Comments: Trenches on contour, Pump specs: 50 gal/min at 30' Head
SEE Attached manifold diagram.

Comments: 7/21/94 System installed and closed
11/10/94 Alarm & elec hookups checked

INITIAL SITE SKETCH

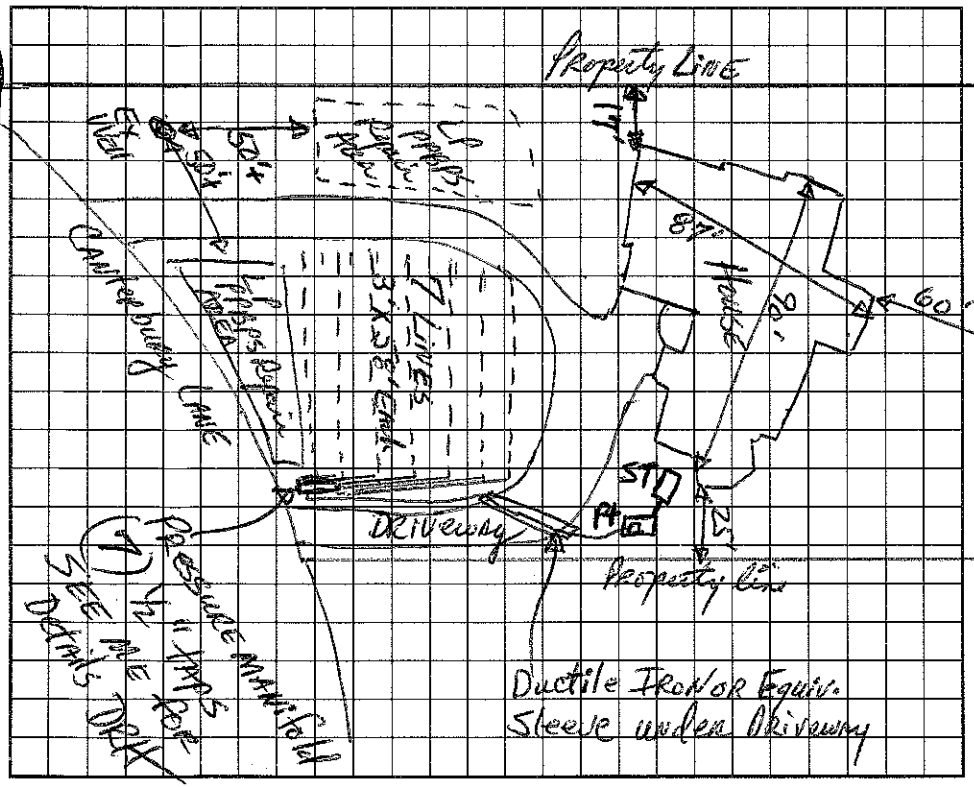

AS BUILT SKETCH

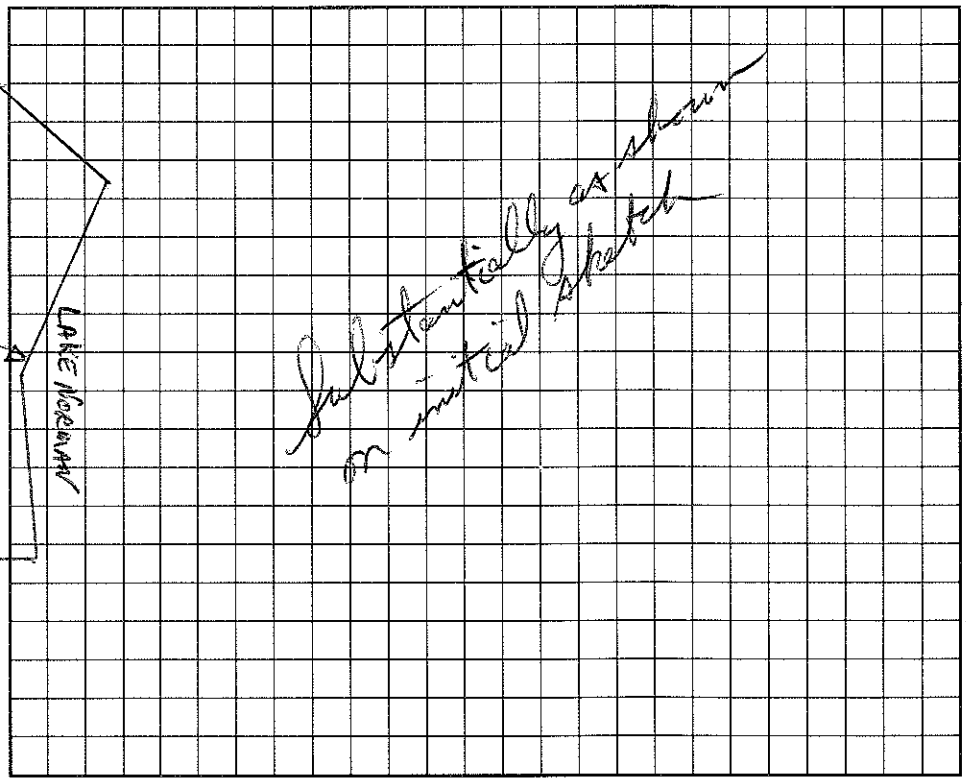

I understand that this permit can be suspended or revoked if any false information is supplied toward securing the permit/any unauthorized changes are made to the site/any unauthorized changes are made in the installation of the system. Improvement Permit is valid for 60 months from date of issuance.

Signed: ABJ

Improvement Permit by: Mark R. Hamm RS date 11/4/93

Existing System Inspection by: date

Installed by: J R Browder

Certificate of Completion by: date

Operation Permit by: date 11/10/94

HEALTH DEPT. COPY: WHITE INSPECTION COPY (FINAL): GREEN OWNER COPY (FINAL): YELLOW INSPECTION COPY (INITIAL): PINK OWNER COPY (INITIAL): GOLD