# IREDELL COUNTY HEALTH DEPARTMENT

...SVILLE 704-878-5305 MOORESVILLE 704-664-5231

## IMPROVEMENT PERMIT / CERTIFICATE OF COMPLETION / OPERATION PERMIT / EXISTING SYSTEM INSPECTION

PROPERTY DESCRIPTION NO. ~~97-1004~~ 068009 DATE 8/15/97 TAX MAP NO. 4624094950 Watershed: ☑ Yes ☐ No

OWNER OR CONTRACTOR RICK SORENSON PHONE: Business Home 896-5952

ADDRESS 3108 EASTOVER RIDGE AP 5/6 CHARLOTTE NC 28211 316 Stone marker

LOCATION BRAWLEY SCHOOL RD - TR STONE MARKER .8 ON RT

SUBDIVISION ~~Meck Neck~~ BLOCK / SECTION ~~60~~ LOT 16 97 LOT AREA - SITE CLASS. A5 DESIGN FLOW 360 GPD L.T.A.R. .36 AP/FT

Septic Tank: 1000 Gallons; STB 825 Date 9/98

Pump Tank: 1000 Gallons; PT 97 Date 8/5/98

Pump Make: ZOELLER Model M137 C Serial No. 8/98

Nitrification Field: No Fields 1 Square Feet 900 Linear Feet 300

No Lines 4 @ 75' Trench Width 36" Max Trench Bottom Depth 36" Gravel Depth N/A

☑ New System ☐ Repair System Type: I, II, (III), IV, V, VI

System Description: PUMP CHAMBERED OR SIMILAR 1405

Repair System Description: PANEL

Maintenance Agreement Required: ☐ Yes ☑ No

☑ House/Mod. Home No. Bedrooms 3

☐ Mobile Home No. Bathrooms 3½

☐ Business No. Employees

☐ Other


☐ Slab ☐ Crawl Space ☑ Basement w/plumbing ☐ Basement wo/plumbing

Water Supply: ☑ Individual ☐ Community ☐ Public

Comments:

Comments:

INITIAL SITE SKETCH 1"=60'

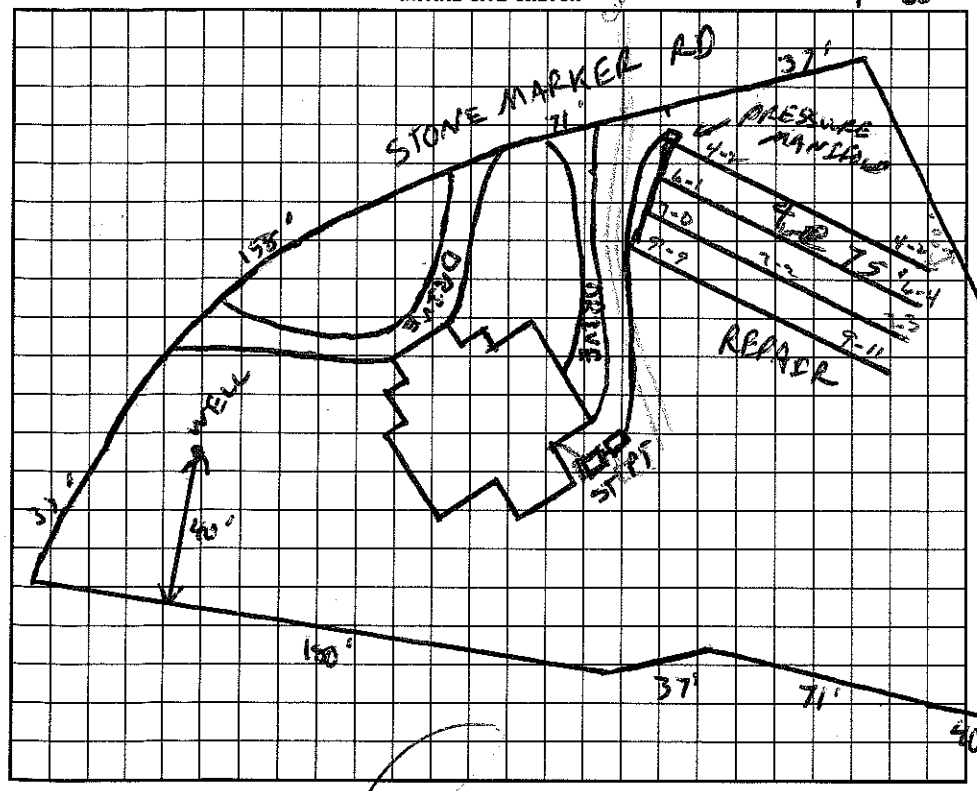


AS BUILT SKETCH

I understand that this permit can be suspended or revoked if any false information is supplied toward securing the permit/any unauthorized changes are made to the site/any unauthorized changes are made in the installation of the system. Improvement Permit is valid for 60 months from date of issuance.

Signed: [signature] MARSHALL BUILDING GROUP LLC Installed by: Rodney Ellis

Improvement Permit by: C. Ray Tolson date 8/15/97 Certificate of Completion by: date

~~Existing System Inspection by:~~ AUTHORIZATION C. Ray Tolson date 8/15/97 Operation Permit by: Wesley Sparks R.S. date 12/23/98

~~CONSTRUCTION~~

HEALTH DEPT. COPY: WHITE INSPECTION COPY (FINAL): GREEN OWNER COPY (FINAL): YELLOW INSPECTION COPY (INITIAL): PINK OWNER COPY (INITIAL): GOLD