IREDELL COUNTY HEALTH DEPARTMENT

Authorization to Construct (3:00) -

STATESVILLE 704-878-5305 MOORESVILLE 704-664-5281

IMPROVEMENT PERMIT / ~~CERTIFICATE OF COMPLETION~~ / OPERATION PERMIT / EXISTING SYSTEM INSPECTION

PROPERTY DESCRIPTION NO. 20502 DATE 10/8/96 TAX MAP NO. 2D 1A 85 4624098765 Watershed: X Yes ☐ No

OWNER OR CONTRACTOR Phillip Turpin PHONE: Business 336-6348 Home 892-7438

ADDRESS 450 Walden Tr. Wedddington, NC. 28173

LOCATION Brawley Sch. TR Stonemarker straight ~ 1 mile on (R) 360

SUBDIVISION ~~Stonemarker~~ BLOCK / SECTION 6 LOT 85 LOT AREA ~1Ac SITE CLASS. PS DESIGN FLOW ~~480~~ L.T.A.R. .3

CL4

Septic Tank: 1000 Gallons; STB 1012 Date 6/11/97
Pump Tank: 1000 Gallons; PT 17 Date 7/7/97
Pump Make: ____ Model 1200 Serial No. ____
Nitrification Field: No Fields 1 Square Feet ~~1600~~ Linear Feet X 400
No Lines X 5 Trench Width 36" Max Trench Bottom Depth 36" Gravel Depth SAND

X New System ☐ Repair System Type: I, II, (III) IV, V, VI
System Description: X PRES MANIFOLD - ~~GRAVITY~~
Repair System Description: SAME
Maintenance Agreement Required: ☐ Yes ☐ No


X House/Mod. Home No. Bedrooms 3 X
☐ Mobile Home No. Bathrooms 3.5
☐ Business No. Employees ____
☐ Other ____
☐ Slab X Crawl Space ☐ Basement w/plumbing ☐ Basement wo/plumbing

Water Supply:
X Individual
☐ Community
☐ Public


Comments: X 25% reduction in Linear footage
Pressure Manifold required

Comments: May change to 400 feet conventional trenches if pressure manifold - does not

INITIAL SITE SKETCH

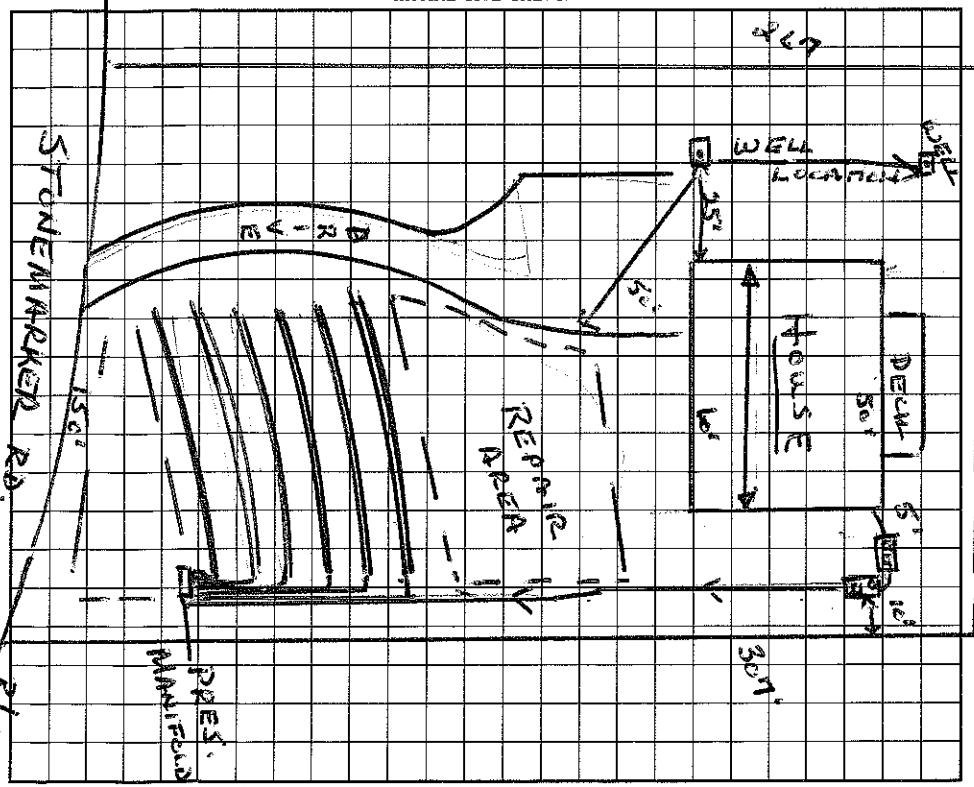

AS BUILT SKETCH

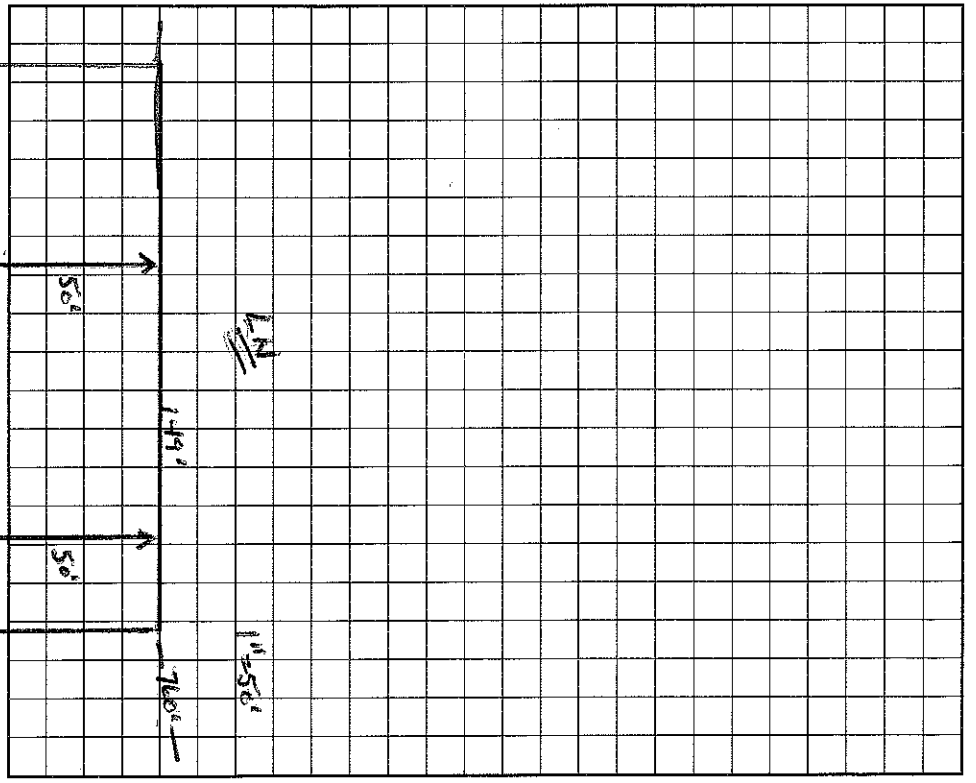

I understand that this permit can be suspended or revoked if any false information is supplied toward securing the permit/any unauthorized changes are made to the site/any unauthorized changes are made in the installation of the system.

Signed: X Philip Turpin

Improvement Permit by: Wesley Sparks RS date 10/8/96

Existing System Inspection by: X Wesley Sparks RS. date 10/8/96

Installed by: Richard Blevins

Certificate of Completion by: Wesley Sparks RS date 9/24/97

Operation Permit by: Wesley Sparks RS date 9/24/97

Duplicate

HEALTH DEPT. COPY: WHITE INSPECTION COPY (FINAL): GREEN OWNER COPY (FINAL): YELLOW INSPECTION COPY (INITIAL): PINK OWNER COPY (INITIAL): GOLD