IREDELL COUNTY HEALTH DEPARTMENT

STATESVILLE 704-878-5305 325.00 Paid MOORESVILLE 704-664-5281

IMPROVEMENT PERMIT / AUTHORIZATION TO CONSTRUCT / OPERATION PERMIT / EXISTING SYSTEM INSPECTION

PERMIT# 92152 PIN# 4624 15 8859 DATE 2/9/01

OWNER OR CONTRACTOR JOHN McCALL PHONE: Business 782-1279 Home

ADDRESS 644 ABENTON DR. CONCORD NC 28025

LOCATION BRAWLEY SCHOOL - TR TUSKORA - TL CHESTNUT TREE - AT END

SUBDIVISION CL&T BLOCK / SECTION 6 LOT 392 LOT AREA .774C SITE CLASS. PS DESIGN FLOW ~~480GPD~~ L.T.A.R. .36GPD/FT

Septic Tank: 1500 Gallons; STB 338 Date 8/21/01

Pump Tank: 1000 Gallons; PT 283 Date 9/5/01

Pump Make: GOULDS Model WE0-512HHL Serial No 5021679563

Nitrification Field: No Fields 1 Square Feet 540 Linear Feet 270

No Lines 6@45' Trench Width 24" Max Trench Bottom Depth 36" Gravel Depth N/A

☑ New System ☐ Repair System Type: I, II, III, IV, V, VI

System Description: LP PANEL

Repair System Description: DEEDED B-4 1983

Maintenance Agreement Required: ☐ Yes ☑ No

☑ House/Mod. Home No. Bedrooms 4

☐ Mobile Home No. Bathrooms 4

☐ Business No. Employees

☐ Other


☐ Slab ☑ Crawl Space ☐ Basement w/plumbing ☐ Basement wo/plumbing

Water Supply: ☑ Individual ☐ Public ☐ Community

Comments/Conditions: 1) EXISTING WELL TO BE ABANDONED PROPERLY BEFORE OPERATIONS PERMIT CAN BE ISSUED. 2) NEW WELL DRILLED 50' FROM SEPTIC SYSTEM. 3) KEEP SUPPLY LINE AT LEAST

Comments/Conditions: 25' FROM 760' CONTOUR ON LAKE NORMAN. 4) KEEP SYSTEM 50' FROM LAKE. 5) ~~LOT~~ LOT IS DEEDED BEFORE 1983. (1975) IN SECTION (6) LOT 392 PLAT BOOK.

INITIAL SITE SKETCH 1" = 50'

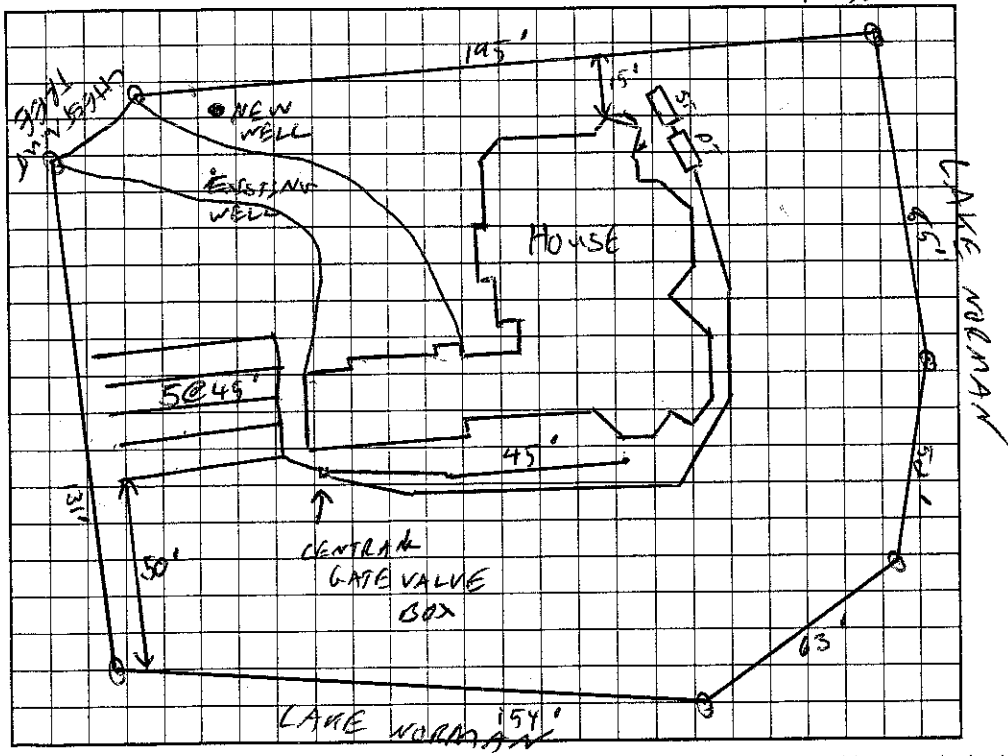

AS BUILT SKETCH

Permit can be suspended or revoked if any false information is supplied toward securing the permit/any unauthorized changes are made to the site/any unauthorized changes are made in the installation of the system. Improvement Permit with plat valid without expiration. Improvement Permit with site plan valid for sixty months. Authorization to Construct is valid for a period equal to that of Improvement Permit – not to exceed sixty months.

Signed: _____ date 2/13/01 Installed by: Stanley Septic Tank

Improvement Permit by: C. Hyde RS date 2/9/01 Operation Permit by: _____ RSI date 11/29/01

Authorization to Construct by: C. Hyde RS date 2/9/01 Existing System Inspection by: _____ date _____

HEALTH DEPT. COPY: WHITE OWNER COPY (FINAL): YELLOW OWNER COPY (INITIAL): PINK