IREDELL COUNTY HEALTH DEPARTMENT

Statesville Office (704) 878-5305 Mooresville Office (704) 660-3625 PERMIT# 2100 202083

IMPROVEMENT PERMIT / AUTHORIZATION TO CONSTRUCT / OPERATION PERMIT / EXISTING SYSTEM

✓ PIN # 4624-16-0192

APPLICANT: KAREN BROWDER APPLICANT ADDRESS: 9304 KESTREL RIDGE DR. CHARLOTTE

✓ SITE ADDRESS: 107 ESTES PARK DR.- Mooresville PHONE: 704-534-9334 ALT. PHONE:

SITE DIRECTIONS: BSR TR TUSKARORA, TL ESTES PARK, ON L

✓ SUBDIVISION: CLET SECTION: 6 LOT # 387 LOT AREA: .18AC DESIGN FLOW: 600 L.T.A.R.: .3

Septic Tank	1500 (gal)	STB	33X	Date	1-21-15	☒ New System	☐ Repair	☐ Expansion	System Type: I II III-B V VI	☒ Residence	No. Bedrooms 5	Water Supply
Pump Tank	1500 (gal)	PT	477	Date	7-2-15	System Description:		PM PANEL BLOCK		☐ Business	No. Persons	☒ Private
Pump Make	Myers	Model	ME 50	Serial #		Repair System Description:		EP PANEL		☐ Other	No. Employees	☐ Public
# Nitrification Fields	1	# Lines	7@50'	Linear Ft:	350'	Maintenance Agreement Required:		☐ YES	☒ NO	☒ Slab	☒ Crawl Space	☐ Community
Trench Width	24"	Max. Trench Bottom Depth	36"	Gravel Depth				☐ GRAVITY	☒ PRESSURE	☐ Basement w/plumbing		☐ Basement w/o plumbing

Comments / Conditions: * EXISTING WELL MUST BE ABANDOND BEFORE ACT *

9/4/15 Checked tanks
9/9/15 Checked lines
9/17/15 Checked 2ft pressure, tanks & lines

INITIAL SITE SKETCH

FOLLOW PLAN BY

JACOBS ON-SITE DEV. INC

APPROVED JAN 20 2015

BA

AS BUILT SKETCH

Permit can be suspended or revoked if any false information is supplied toward securing the permit / any unauthorized changes are made to the site / any unauthorized changes are made in the installation of the system. **CONTACT A LOCATOR SERVICE PRIOR TO ANY EXCAVATION**

☐ **IMPROVEMENT PERMIT** *with plat valid without expiration.* ☒ **IMPROVEMENT PERMIT** *with site plan valid for 60 mos.* ☐ **AUTHORIZATION TO CONSTRUCT** *valid for period equal to IMPROVEMENT PERMIT--not to exceed 60 mo.*

Owner / Applicant Signature: [signature] Date: 1-27-15 Installed by: R&H

IMPROVEMENT PERMIT by: [signature] Date: APPROVED JAN 20 2015 OPERATION PERMIT by: [signature] RS Date: 10/17/15

AUTHORIZATION TO CONSTRUCT by: [signature] Date: APPROVED FEB 06 2015 Existing System Inspected by: Date:

Health Dept. Copy - WHITE Applicant (Final Approval) - YELLOW Applicant (Conditional Approval) - PINK


16.3A

Site plan

107 Estes Park Dr

28117

1" = 40'

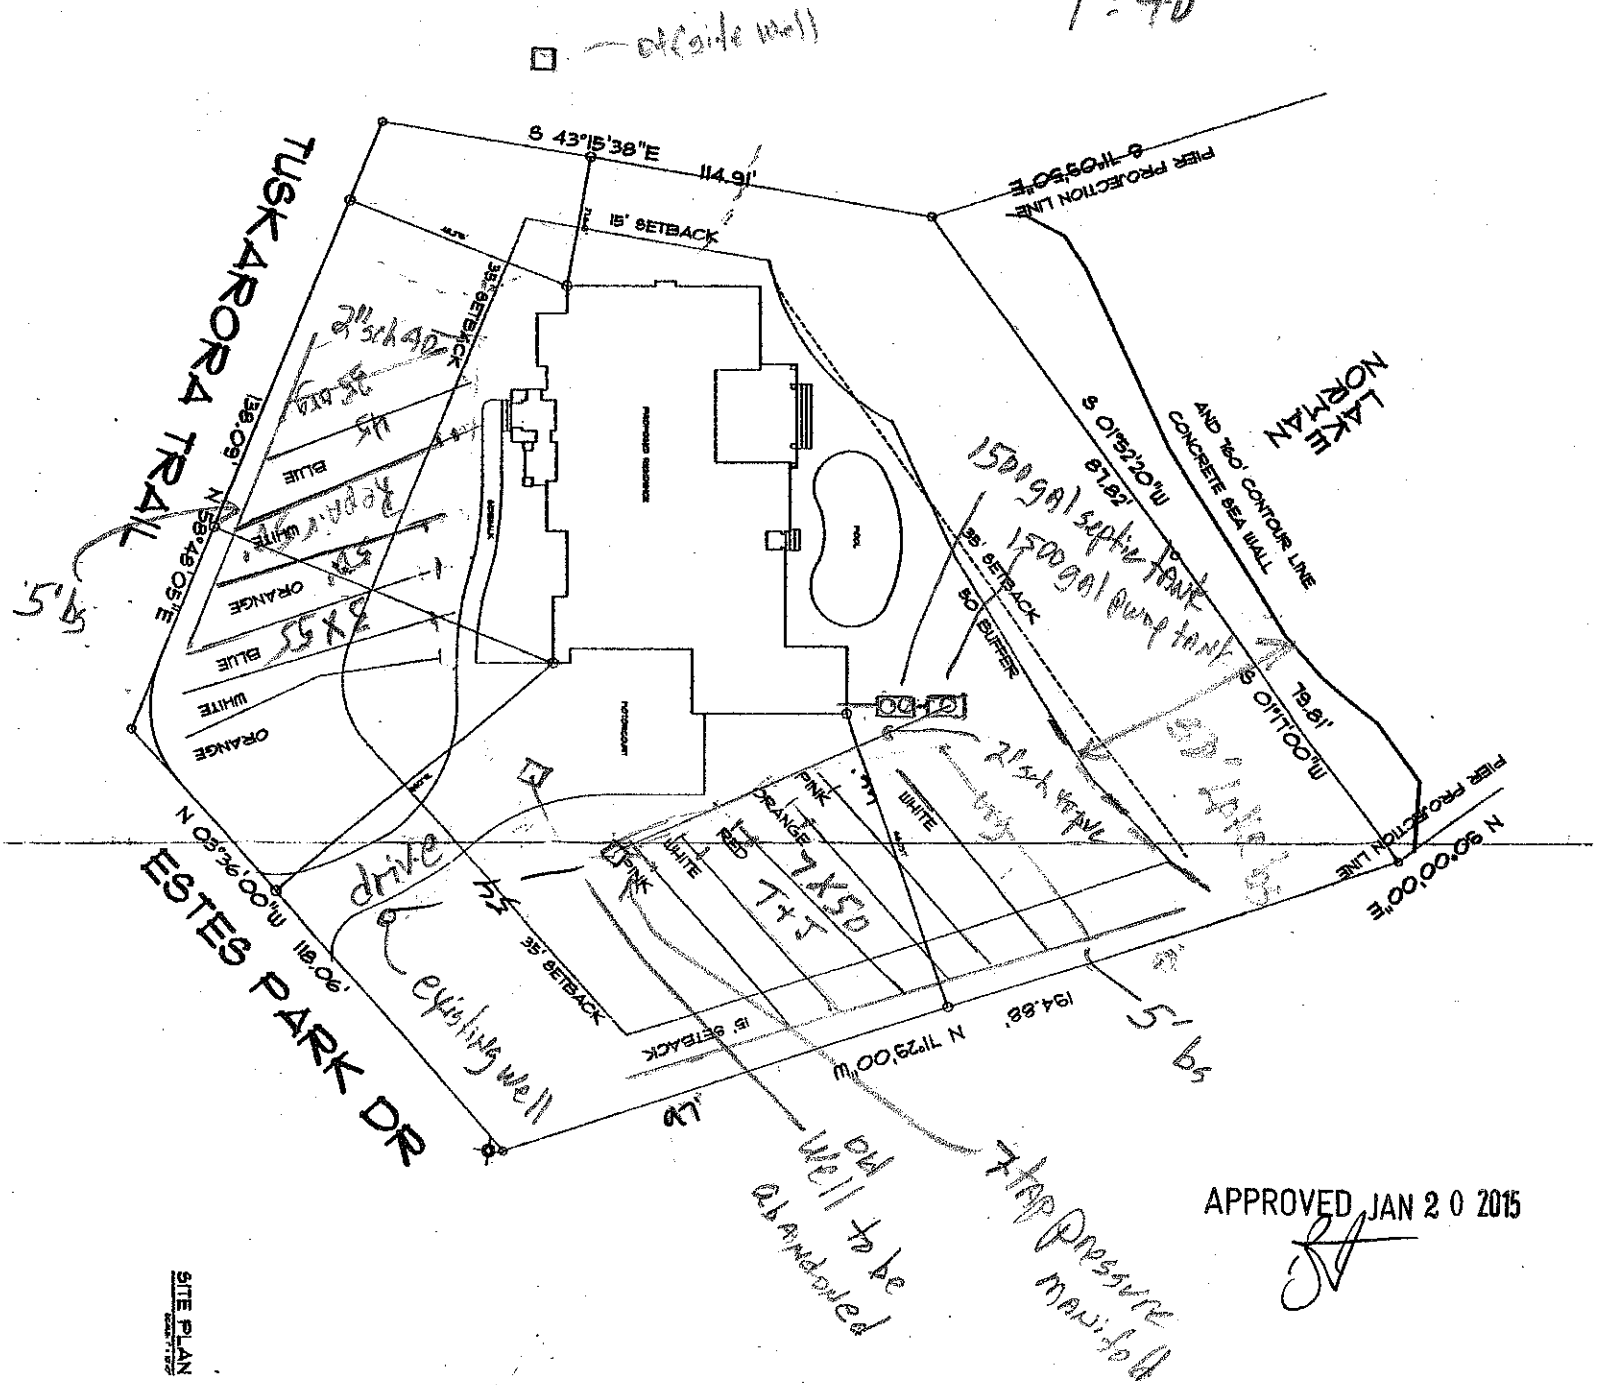

APPROVED JAN 2 0 2015

DRAWN BY:	J.LEARAVA/J.STEFANIK
DATE:	12/12/2014
REVISED:	
SHEET	1
OF	15

THE BROWDER RESIDENCE

LOT 387, ESTES PARK DR

PROJECT:

P.O. Box 691235
Mint Hill, NC 28227
tel: 704-545-2828
fax: 704-545-0800

ENGINEERED BY:
INTELLIGENT DESIGN
ENGINEERING P.C.
2200 THE PLAZA, SUITE B
CHARLOTTE, NC 28205
NO. C-3118

© COPYRIGHT 2014