357

IREDELL COUNTY HEALTH DEPARTMENT

STATESVILLE 704-878-5305 MOORESVILLE 704-664-5281

IMPROVEMENT PERMIT / AUTHORIZATION TO CONSTRUCT / OPERATION PERMIT / EXISTING SYSTEM INSPECTION

PERMIT# Repair PIN# 4624160759 DATE 4/8/06

OWNER OR APPLICANT David Brown PHONE: Business 704 577-9464 Home

ADDRESS 129 Cottage Grove Rd, Mooresville NC 28117

LOCATION BSR TR Tuskaroca, TR Cottage Grove, at End #129

SUBDIVISION CL+T BLOCK / SECTION 6 LOT 211 LOT AREA 0.75Ac SITE CLASS. PS DESIGN FLOW 360 L.T.A.R. —

Septic Tank: Existing Gallons: STB Date

Septic Tank: Existing Gallons: PT Date

Pump Make: Model Serial No.

Nitrification Field: No Fields Square Feet 630(N)/300 Linear Feet 70'/60'

No Lines Trench Width 9'/6' Max Trench Bottom Depth 36" Gravel Depth —

☐ New System ☒ Repair ☐ Expansion System Type: I (II) III IV V VI

System Description: 25% Reduction

Repair System Description:

Maintenance Agreement Required: ☐ Yes ☒ No

☒ House/Mod. Home ☐ Mobile Home ☐ Business ☐ Other

No. Bedrooms 3 No. Persons No. Employees


Water Supply: ☒ Individual ☐ Public ☐ Community

☐ Gravity ☐ Pressure ☐ Slab ☐ Crawl Space ☒ Basement w/plumbing ☐ Basement wo/plumbing

Comments:/Conditions:


Not to scale

INITIAL SITE SKETCH

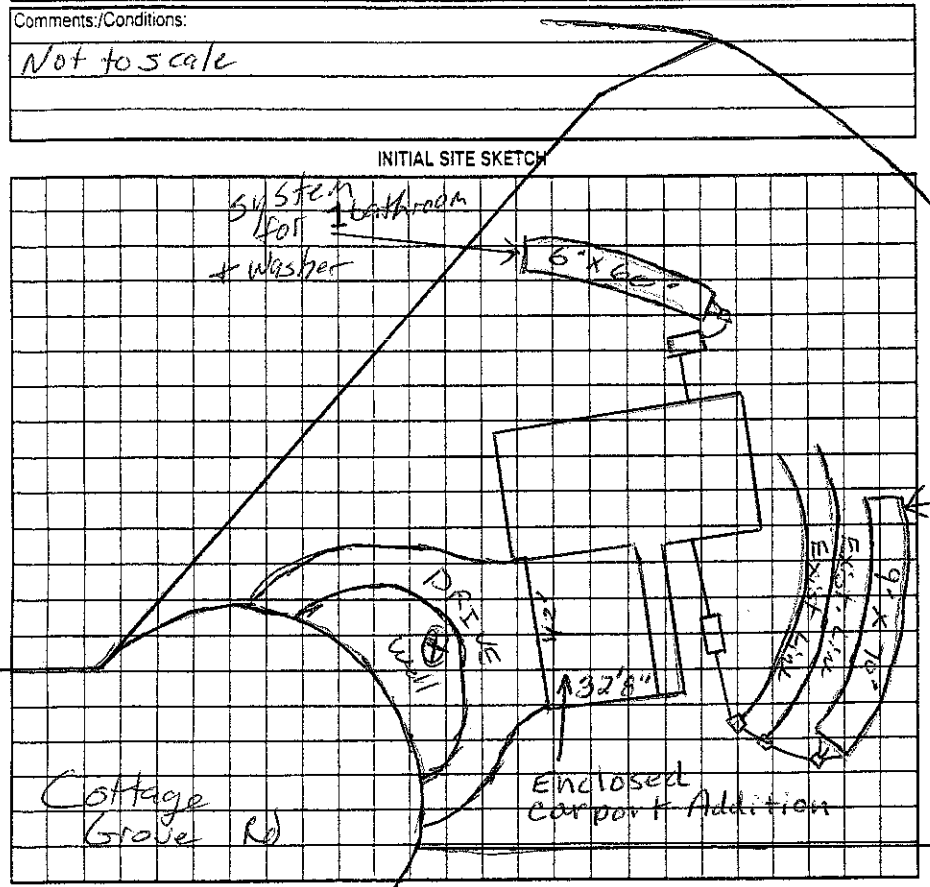

Comments:/Conditions:

AS BUILT SKETCH

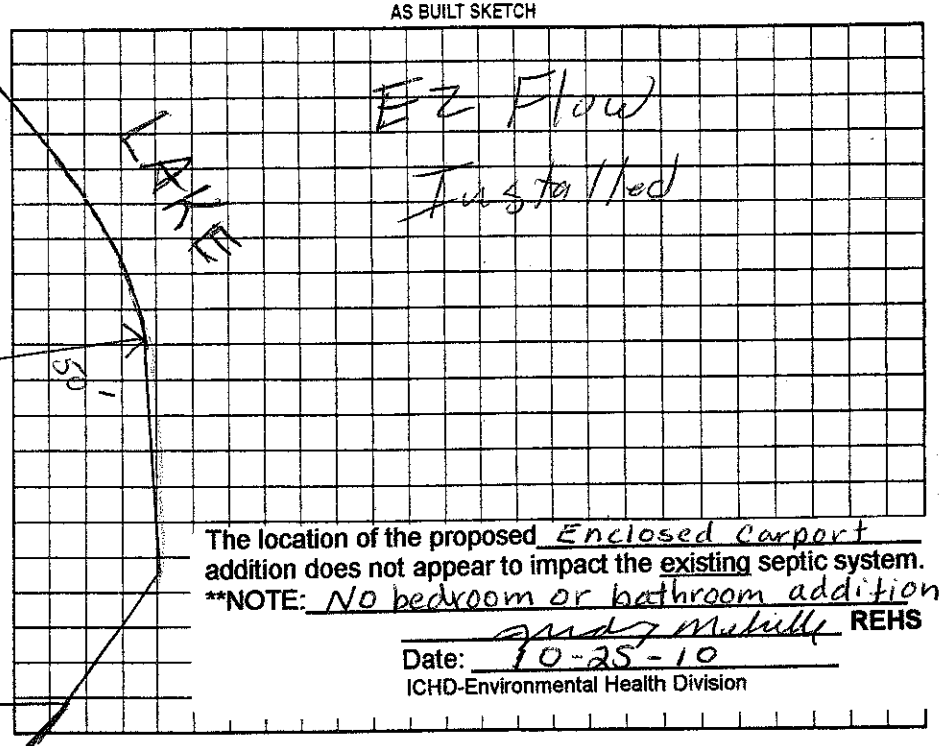

The location of the proposed Enclosed Carport addition does not appear to impact the existing septic system.

**NOTE: No bedroom or bathroom addition

Andy Mutchler REHS

Date: 10-25-10

ICHD-Environmental Health Division

Permit can be suspended or revoked if any false information is supplied toward securing the permit/any unauthorized changes are made to the site/any unauthorized changes are made in the installation of the system. Improvement Permit with plat valid without expiration ☐ Improvement Permit with site plan valid for sixty months ☒ Authorization to Construct is valid for a period equal to that of Improvement Permit – not to exceed sixty months.

Signed: date 4-10-06 Installed by: Autry Const

Improvement Permit by: RS date 4/7/06 Operation Permit by: RS date 4/12/06

Authorization to Construct by: date 4/7/06 Existing System Inspection by: date

HEALTH DEPT. COPY: WHITE OWNER COPY (FINAL): YELLOW OWNER COPY (INITIAL): PINK