IREDELL COUNTY HEALTH DEPARTMENT

STATESVILLE 704-878-5305 MOORESVILLE 704-664-5281

350.00 Paid

IMPROVEMENT PERMIT / AUTHORIZATION TO CONSTRUCT / OPERATION PERMIT / EXISTING SYSTEM INSPECTION

PERMIT# N/A PIN# [redacted] DATE 2/15/06

OWNER OR APPLICANT DAVIA LOWERY PHONE: Business 704-581-3090 Home

ADDRESS 125 COTTAGE GROVE LN. MOORESVILLE, NC. 28117

LOCATION 1100 TR TUSCARORA TR COTTAGE GROVE LN, house on L off cul-de-sac

SUBDIVISION CL+T BLOCK / SECTION 6 LOT 212 LOT AREA SITE CLASS. PS DESIGN FLOW 360 L.T.A.R. .3

Septic Tank: 1000 Gallons: STB 794 Date 8/2/05

Pump Tank: Gallons: PT Date

Pump Make: Model Serial No.

Nitrification Field: No Fields 1 Square Feet 900 Linear Feet 300

No Lines 4 Trench Width 3' Max Trench Bottom Depth 3'

☐ New System ☒ Repair ☐ Expansion System Type: ~~I~~ II III IV V VI

System Description:

Repair System Description GRAVITY - 25% REDUCTION

Maintenance Agreement Required: ☐ Yes ☐ No

Gravel Depth NA ☒ Gravity ☐ Pressure

☒ House/Mod. Home ☐ Mobile Home ☐ Business ☐ Other

No. Bedrooms 3 No. Persons 3 No. Employees


Water Supply: ☒ Individual ☐ Public ☐ Community

☐ Slab ☐ Crawl Space ☒ Basement w/plumbing ☐ Basement wo/plumbing


Comments:/Conditions:

Comments:/Conditions:

INITIAL SITE SKETCH

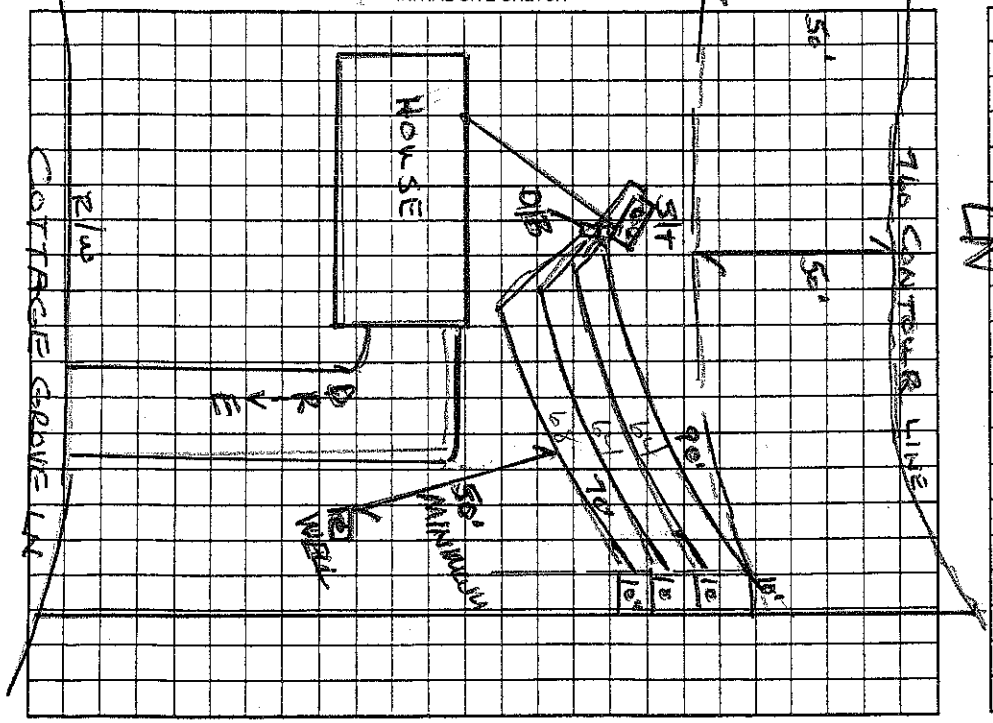

AS BUILT SKETCH

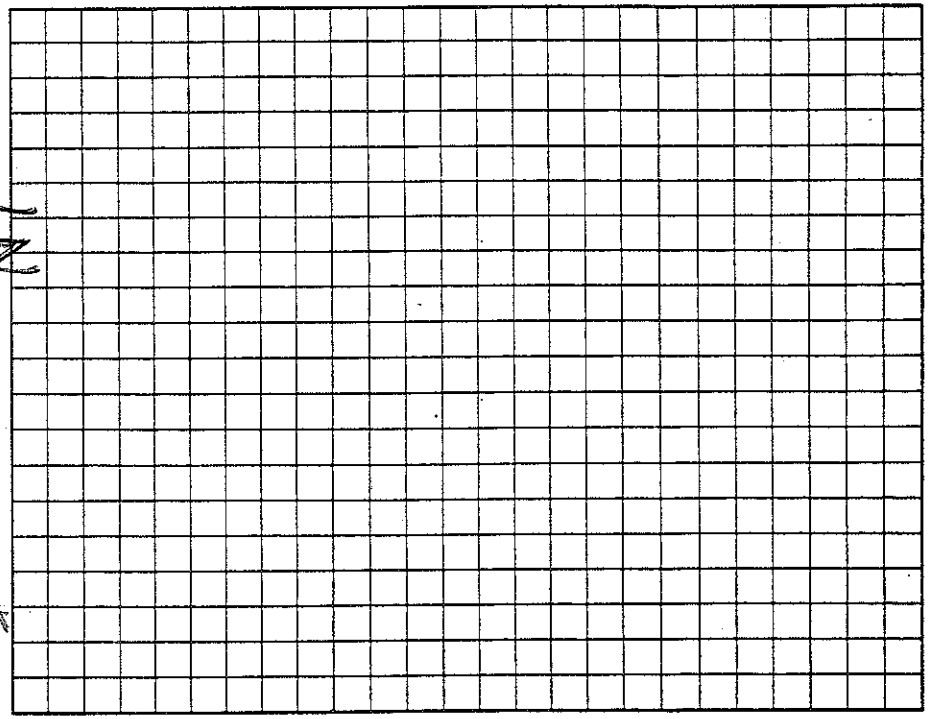

Permit can be suspended or revoked if any false information is supplied toward securing the permit/any unauthorized changes are made to the site/any unauthorized changes are made in the installation of the system. Improvement Permit with plat valid without expiration ☐ Improvement Permit with site plan valid for sixty months ☐ Authorization to Construct is valid for a period equal to that of Improvement Permit – not to exceed sixty months.

Signed: X Sue Tarantino date 2/15/06

Improvement Permit by: Wesley Sparks R.S. date 2/15/06

Authorization to Construct by: Wesley Sparks R.S. date 2/15/06

Installed by: Curt Dawson

Operation Permit by: Wesley Sparks R.S. date 3/6/06

Existing System Inspection by: date

HEALTH DEPT. COPY: WHITE OWNER COPY (FINAL): YELLOW OWNER COPY (INITIAL): PINK