IREDELL COUNTY HEALTH DEPARTMENT

STATESVILLE 704-878-5305 130.00 Paid MOORESVILLE 704-664-5281

IMPROVEMENT PERMIT / AUTHORIZATION TO CONSTRUCT / OPERATION PERMIT / EXISTING SYSTEM INSPECTION

PERMIT# 113618 PIN# 4624 - 16 - 8411 DATE 7/22/03

OWNER OR CONTRACTOR Crescent Resources PHONE: Business 704 665-6905 Home

ADDRESS PO Box 1003 Charlotte NC 28201

LOCATION BSR, TR Tuskarora, Lt Past Chestnut Tree

SUBDIVISION CLFT BLOCK / SECTION LOT 1731 LOT AREA 1.19Ac SITE CLASS PS DESIGN FLOW 480 L.T.A.R. 0.35

Septic Tank: 1000 Gallons; STB 1007 Date 10/25/05
Pump Tank: 1000 Gallons; PT 274 Date 10/25/05
Pump Make: Myers Model ME50S-11 Serial No.
Nitrification Field: No Fields 1 Square Feet 1440 Linear Feet 480
No Lines 6@80' Trench Width 36" Max Trench Bottom Depth 36" Gravel Depth —

☒ New System ☐ Repair System Type: I, II, (III), IV, V, VI
System Description: Press. Manif. 25% Red.
Repair System Description: LP Panel Block
Maintenance Agreement Required: ☐ Yes ☒ No

☒ House/Mod. Home No. Bedrooms 4
☐ Mobile Home No. Bathrooms 4
☐ Business No. Employees
☐ Other

☐ Slab ☐ Crawl Space ☒ Basement w/plumbing ☐ Basement wo/plumbing


Water Supply: ☒ Individual ☐ Public ☐ Community

Comments:/Conditions:


1" = 100'

Comments:/Conditions:

INITIAL SITE SKETCH

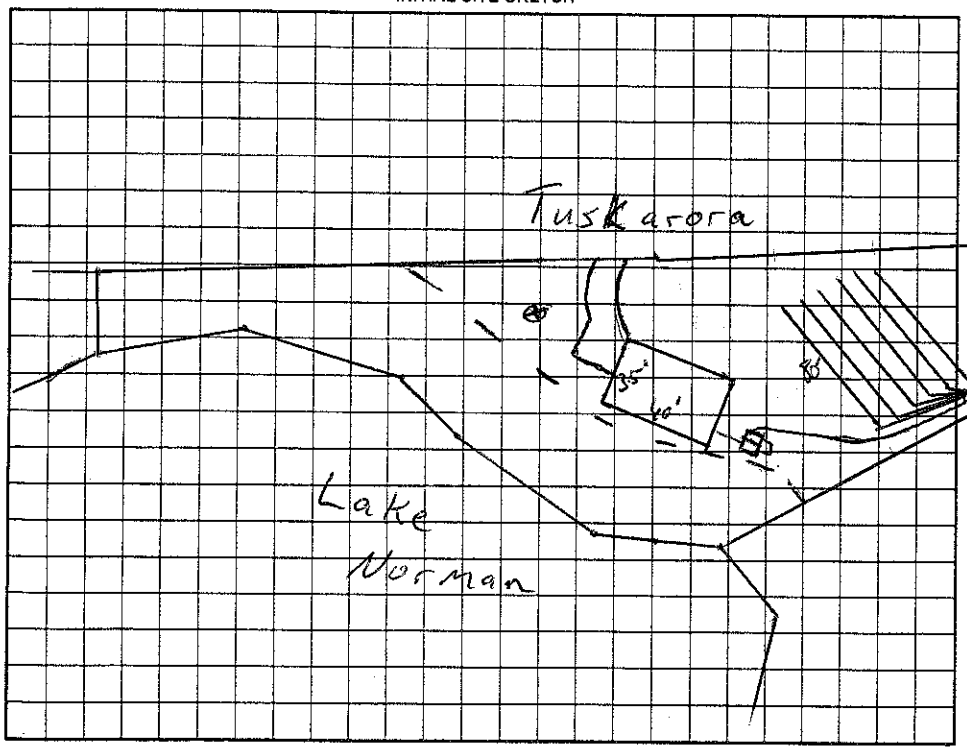

AS BUILT SKETCH

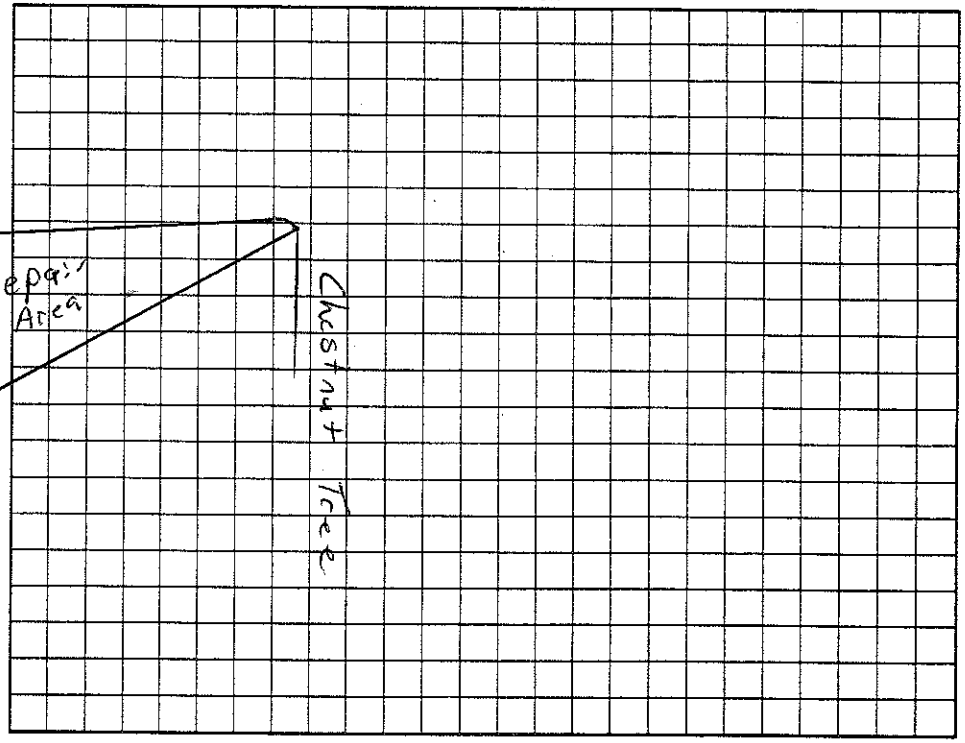

Permit can be ~~suspended~~ or revoked if any false information is supplied toward securing the permit/any unauthorized changes are made to the site/any unauthorized changes are made in the installation of the system. Improvement Permit with plat valid without expiration. Improvement Permit with site plan valid for sixty months. Authorization to Construct is valid for a period equal to that of Improvement Permit – not to exceed sixty months.

Signed: [signature] date 7-22-03 Installed by: Abernethy

Improvement Permit by: [signature] RS date 7/22/03 Operation Permit by: [signature] RS date 1/31/06

Authorization to Construct by: [signature] RS date 9/25/05 Existing System Inspection by: date

HEALTH DEPT. COPY: WHITE OWNER COPY (FINAL): YELLOW OWNER COPY (INITIAL): PINK