Now: 184 Tuskarora Trail - Mrsul

# IREDELL COUNTY HEALTH DEPARTMENT

Statesville Office (704) 878-5305 Mooresville Office (704) 660-3625

201473 ~~2014173~~ (Apt. garage) PERMIT # ~~2014107 House~~ H3632

## IMPROVEMENT PERMIT / AUTHORIZATION TO CONSTRUCT / OPERATION PERMIT / EXISTING SYSTEM

PIN # 4624-16-8612

APPLICANT: JEFF MARKEE APPLICANT ADDRESS:

SITE ADDRESS: 104 COTTAGE GROVE LN PHONE: 980-428-0579 ALT. PHONE:

SITE DIRECTIONS: BSR TR TUSK TRAIL, TR COTTAGE GROVE

SUBDIVISION: CLT/Cowans Ford SECTION: 6 LOT # 1713 LOT AREA: .82 AC DESIGN FLOW: 480 L.T.A.R.: .3

| | | | | | | | | | | | |
|---|---|---|---|---|---|---|---|---|---|---|---|
| Septic Tank | 1000 (gal) | STB | 794 | Date | 4-8-14 | ☒ New System | ☐ Repair | ☐ Expansion | System Type: I II III (IV) V VI | ☒ Residence | No. Bedrooms 4 | Water Supply |
| Pump Tank | 1000 (gal) | PT | 283 | Date | 3-3-14 | System Description: | LP PANEL BLOCK | | | ☐ Business | No. Persons | ☒ Private |
| ~~Pump Make~~ ZANK | 1000 | Model | 794 | Serial # | 4-8-14 | Repair System Description: | SAME | | | ☐ Other | No. Employees | ☐ Public |
| # Nitrification Fields | 1 | # Lines | 4 | Linear Ft: | 270' | Maintenance Agreement Required: | ☒ YES | ☐ NO | | ☒ Slab | ☒ Crawl Space | ☐ Community |
| Trench Width | 24" | Max. Trench Bottom Depth | 36" | Gravel Depth | | | ☐ GRAVITY | ☒ PRESSURE | | ☐ Basement w/plumbing | ☐ Basement w/o plumbing | |

Comments / Conditions: (former Mecke Neck)

MYERS MEUS PUMP

INITIAL SITE SKETCH

SEE APPROVED PLAN
FROM MICHAEL
ATHANAS & ASSOCIATES
BA

AS BUILT SKETCH

SEE REVISED PLAN BY MIKE ATHANAS & ASSOCIATES

APPROVED MAR 17 2014
BA

CHECKED LINES, 2' PM, TANKS
5-20-14
BA

*Permit can be suspended or revoked if any false information is supplied toward securing the permit / any unauthorized changes are made to the site / any unauthorized changes are made in the installation of the system.* **CONTACT A LOCATOR SERVICE PRIOR TO ANY EXCAVATION**

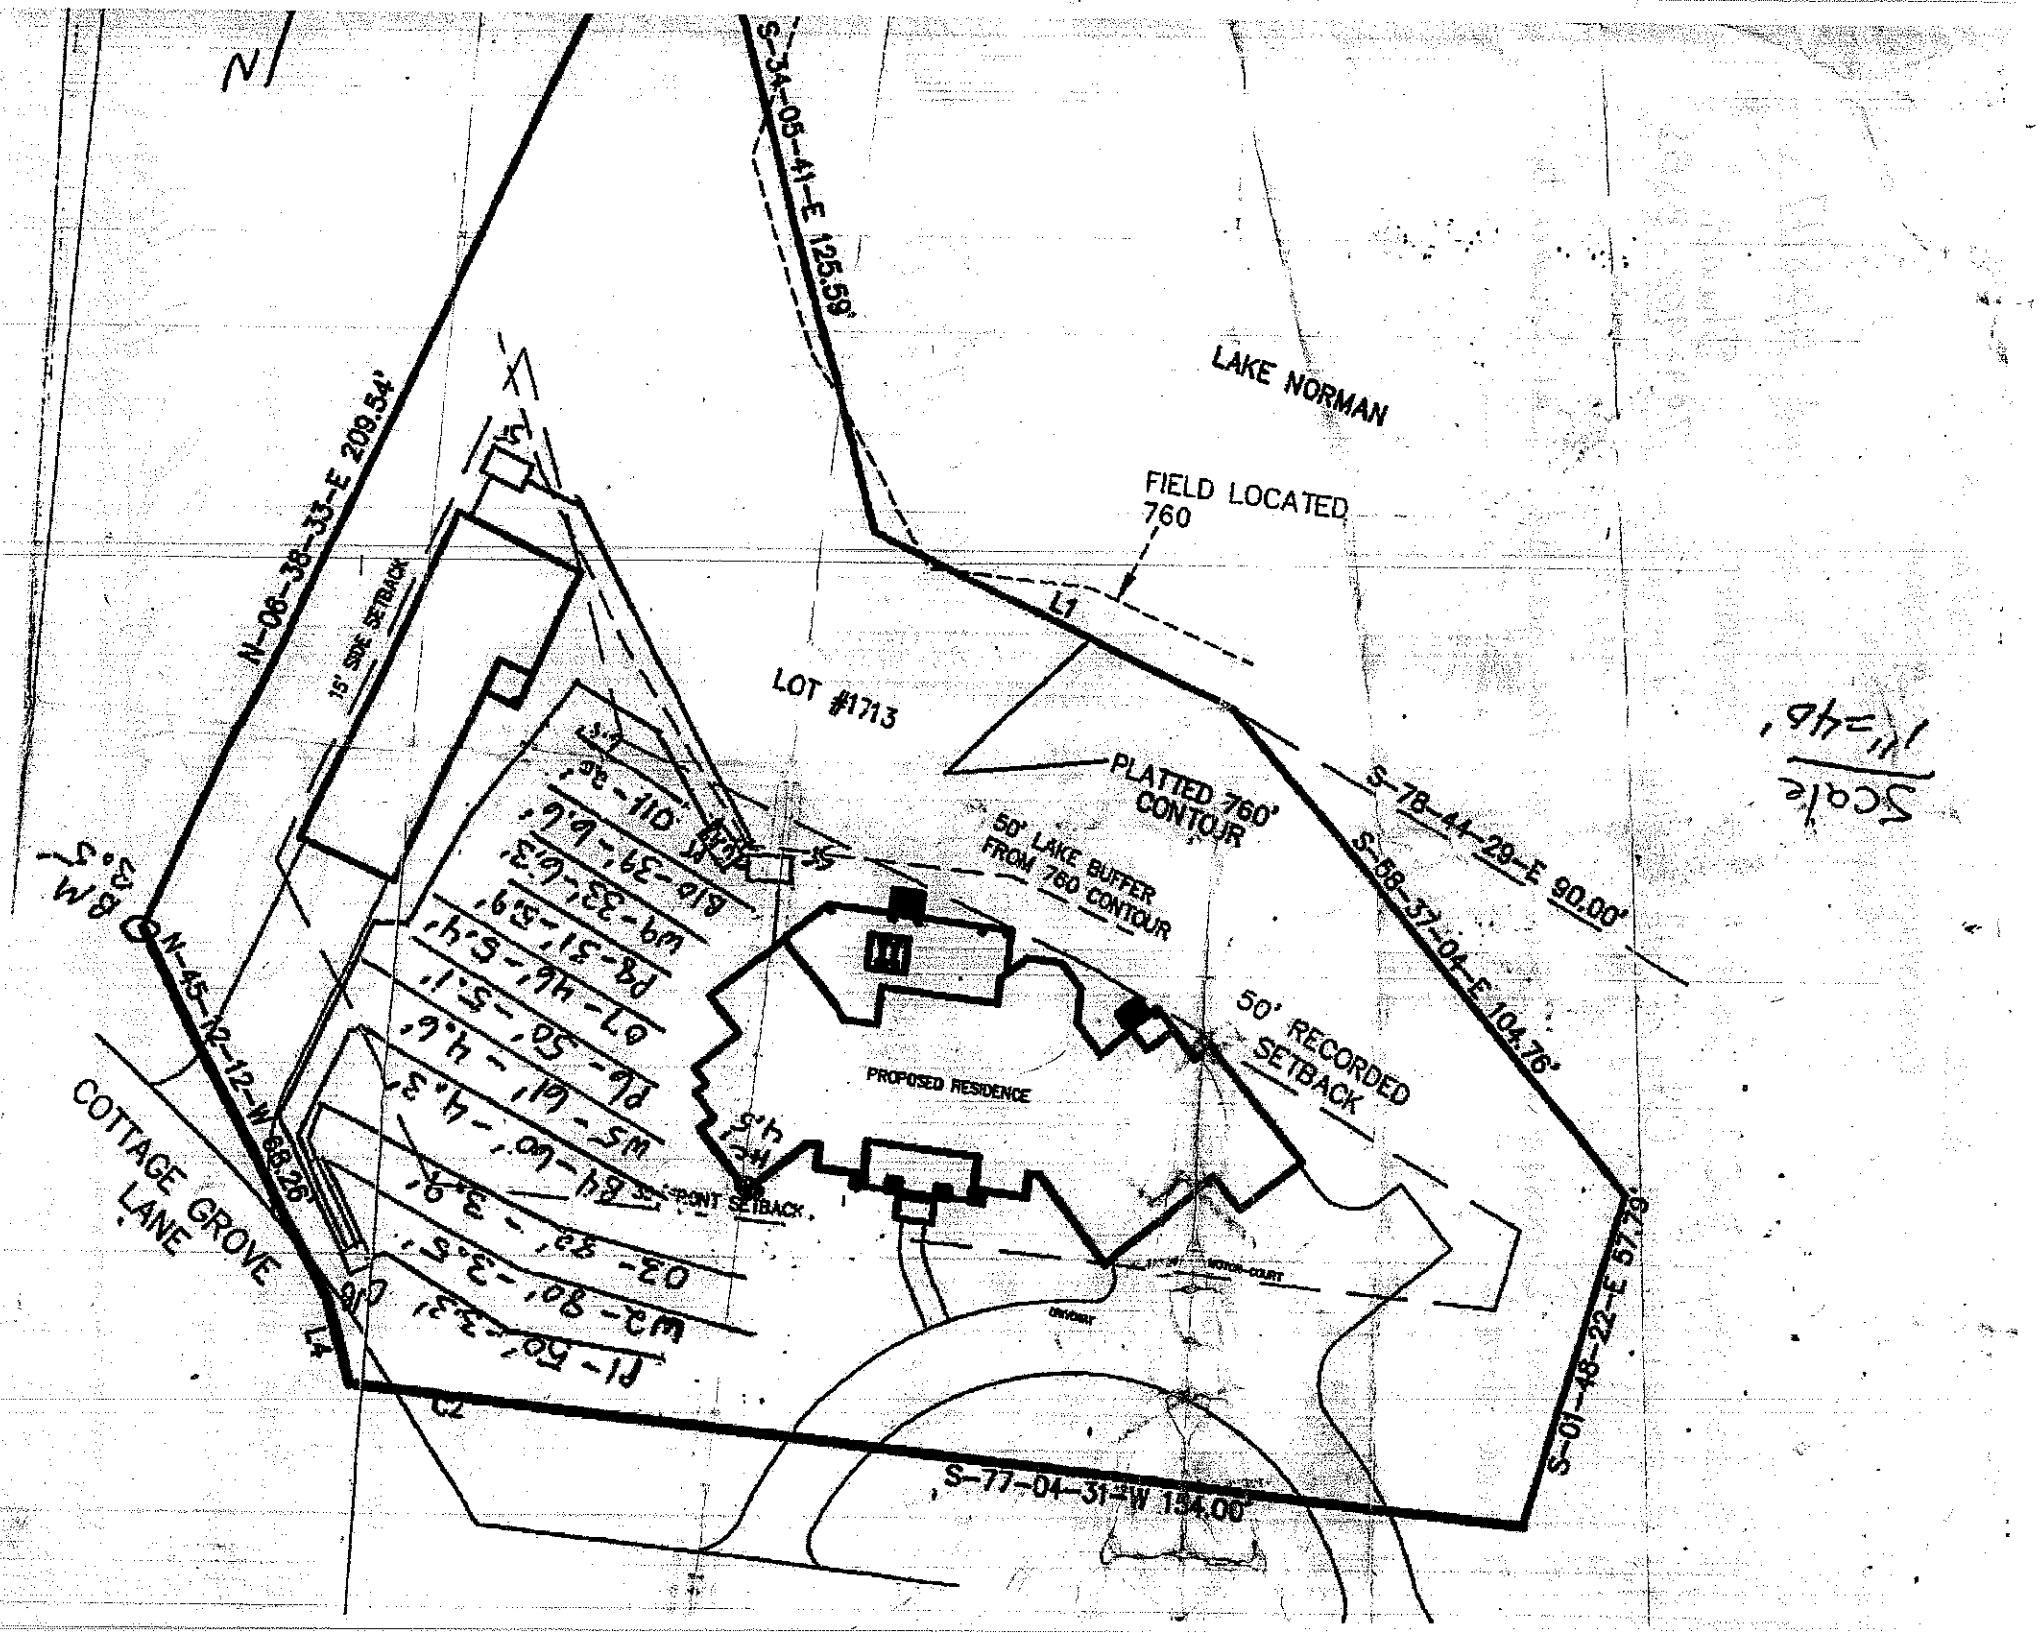
☐ **IMPROVEMENT PERMIT** *with plat valid without expiration* ☒ **IMPROVEMENT PERMIT** *with site plan valid for 60 mos.* ☒ **AUTHORIZATION TO CONSTRUCT** *valid for period equal to IMPROVEMENT PERMIT--not to exceed 60 mo.*

Owner / Applicant Signature: [signature] Date: 1-28-14 Installed by: Willie Christenbury

IMPROVEMENT PERMIT by: BA Date: 1-27-14 OPERATION PERMIT by: [signature] RS Date: 7/7/14

AUTHORIZATION TO CONSTRUCT by: BA Date: 1-27-14 Existing System Inspected by: Date:

Health Dept. Copy - WHITE Applicant (Final Approval) - YELLOW Applicant (Conditional Approval) - PINK


N
S-34-05-41-E 125.59'
LAKE NORMAN
FIELD LOCATED
760
L1
N-06-38-33-E 209.54'
15' SIDE SETBACK
LOT #1713
PLATTED 760' CONTOUR
50' LAKE BUFFER FROM 760 CONTOUR
S-78-44-29-E 90.00'
S-68-37-04-E 104.76'
50' RECORDED SETBACK
PROPOSED RESIDENCE
N-45-12-12-W 68.26'
COTTAGE GROVE LANE
FRONT SETBACK
L4
L2
S-77-04-31-W 134.00'
S-01-48-22-E 57.79'
Scale 1"=40'