Old #113632 / 201407

IREDELL COUNTY HEALTH DEPARTMENT

Statesville Office (704) 878-5305 Mooresville Office (704) 660-3625 PERMIT # 201407

IMPROVEMENT PERMIT / AUTHORIZATION TO CONSTRUCT / OPERATION PERMIT / EXISTING SYSTEM

PIN # 4624-16-8612

APPLICANT: ~~Mike Shatvoy~~ Jeff Markee APPLICANT ADDRESS: 104 Bridge Port Dr Mooresville

SITE ADDRESS: 184 Tuskarora Trl - Mooresville PHONE: ALT. PHONE:

SITE DIRECTIONS: Brawley Sch Rd, TR on Tuskarora Trl, ~~L~~ Lot on R @ corner of Cottage Grove Ln + Tuskarora Trl


SUBDIVISION: CLAT (Cowan's Ford) SECTION: 6 LOT # 1713 LOT AREA: 0.82 DESIGN FLOW: 240 gpd L.T.A.R.: 0.3

Septic Tank	1500	(gal)	STB	444	Date	8-13-15	☐ New System	☐ Repair	☐ Expansion	System Type: I II III IV V VI	☑ Residence	No. Bedrooms	2	Water Supply	
Pump Tank	1500	(gal)	PT	477	Date	11-3-15	System Description:	EXISTING LP PPBPS			☐ Business	No. Persons	4	☑ Private	
Pump Make	Meer	Model	ME45	Serial #			Repair System Description:	LP PPBPS			☐ Other	No. Employees		☐ Public	
# Nitrification Fields	EXISTING	Lines	EXISTING	Linear Ft:			Maintenance Agreement Required:	☑ YES	☐ NO		☐ Slab	☑ Crawl Space		☐ Community	
Trench Width		Max. Trench Bottom Depth		Gravel Depth				☐ GRAVITY	☑ PRESSURE		☐ Basement w/plumbing		☐ Basement w/o plumbing		

Comments / Conditions: * This permit is for the construction of the House. SEE permit # 201473 for details on drainfield, Drainfield installed as a 4 BRM.
* CALL WITH QUESTIONS OR SITE VISIT BEFORE INSTALL IF NEEDED. *

10/16/15 Set 2ft pressure
Checked elect & alarm

INITIAL SITE SKETCH

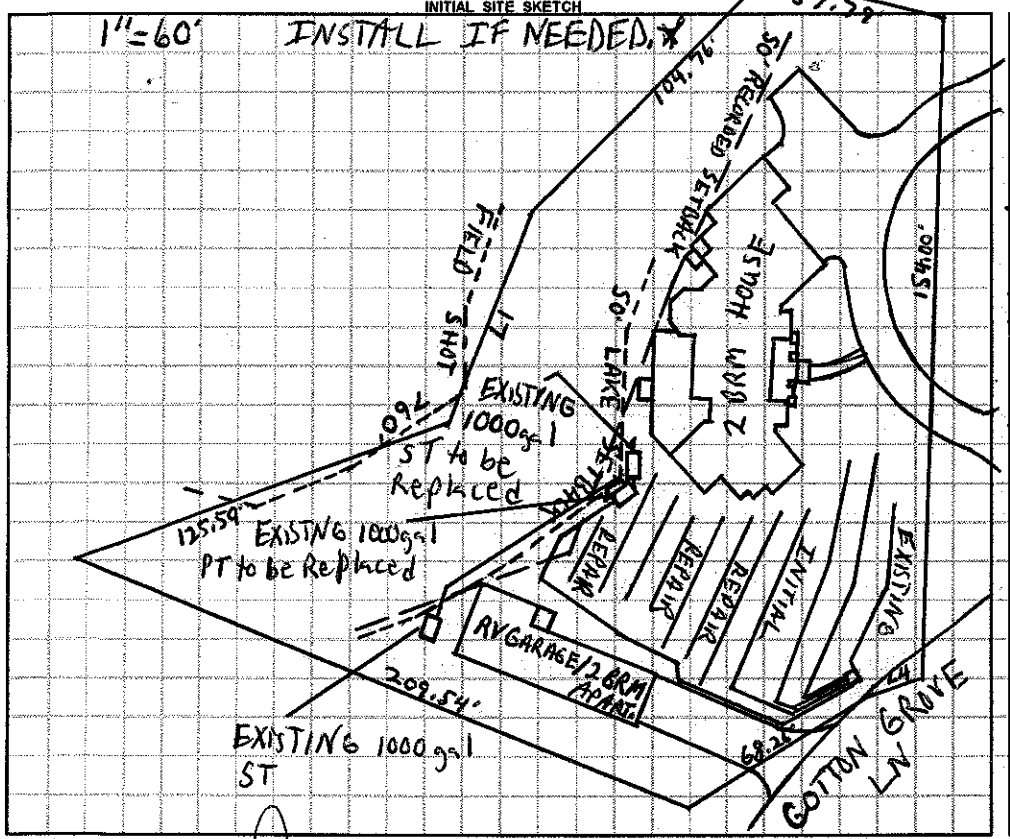

AS BUILT SKETCH

Permit can be suspended or revoked if any false information is supplied toward securing the permit / any unauthorized changes are made to the site / any unauthorized changes are made in the installation of the system. **CONTACT A LOCATOR SERVICE PRIOR TO ANY EXCAVATION**


☐ **IMPROVEMENT PERMIT** *with plat valid without expiration.* ☑ **IMPROVEMENT PERMIT** *with site plan valid for 60 mos.* ☑ **AUTHORIZATION TO CONSTRUCT** *valid for period equal to IMPROVEMENT PERMIT--not to exceed 60 mo.*

Owner / Applicant Signature: (Grainger Builders, Inc.) Date: 8/24/15 Installed by: R & R

OVEMENT PERMIT by: Date: 9-8-14 OPERATION PERMIT by: Date: 10/16/15

N TO CONSTRUCT by: Date: 8-21-15 Existing System Inspected by: Date:

Health Dept. Copy - WHITE Applicant (Final Approval) - YELLOW Applicant (Conditional Approval) - PINK

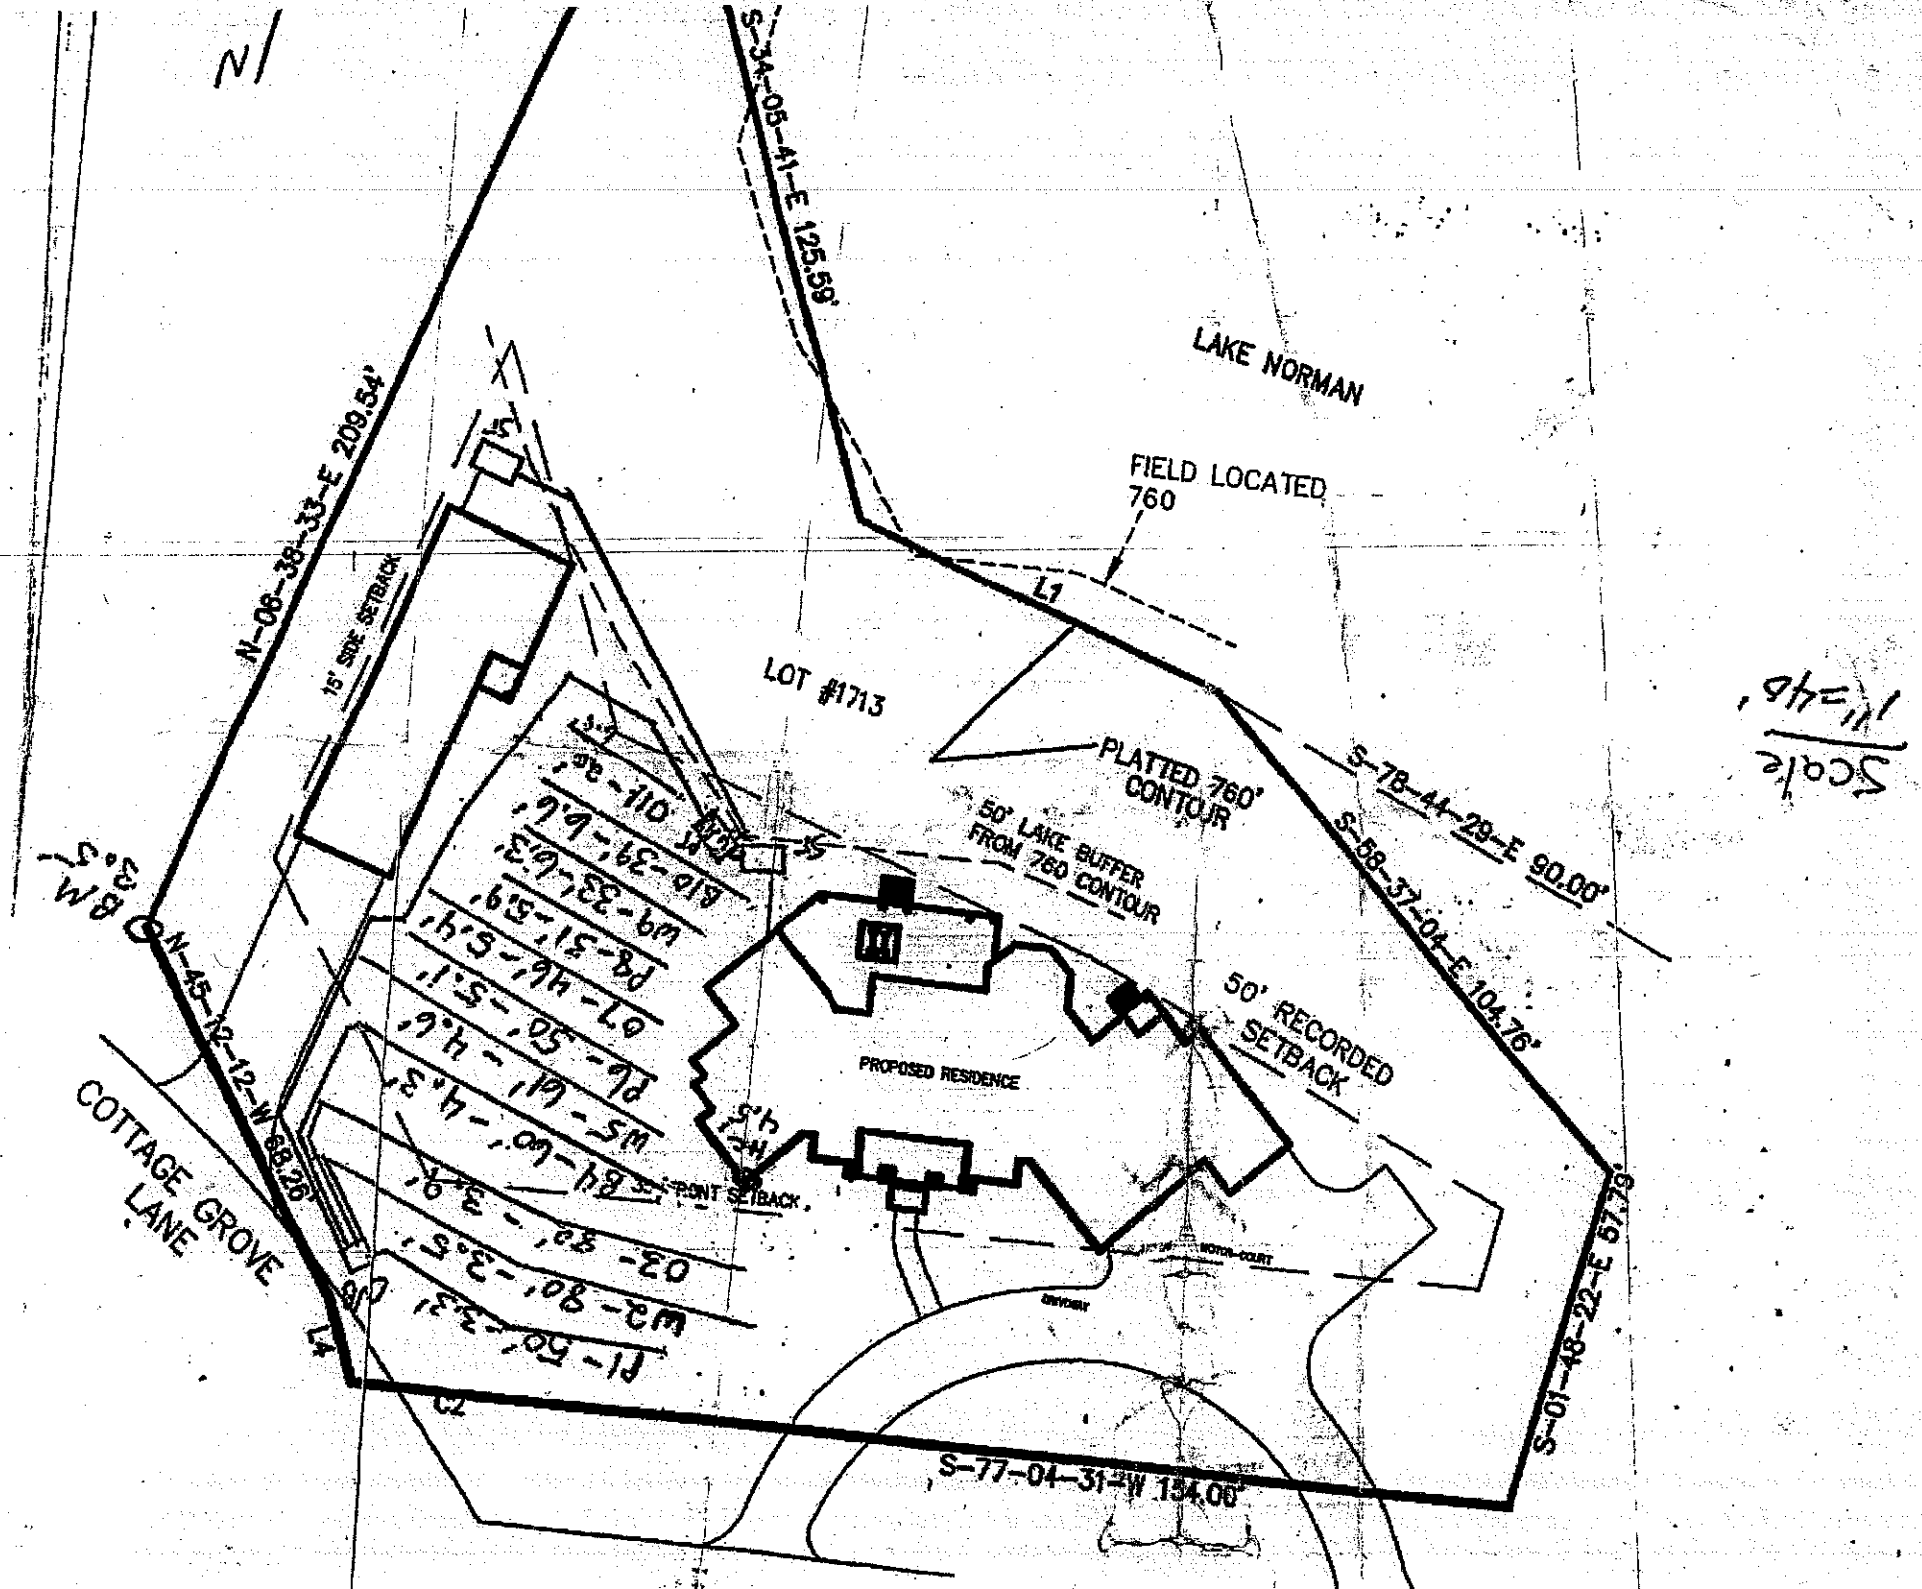
N
S-34-05-41-E 125.59'
LAKE NORMAN
FIELD LOCATED
760
N-08-38-33-E 209.54'
15' SIDE SETBACK
L1
LOT #1713
PLATTED 760'
CONTOUR
50' LAKE BUFFER
FROM 760 CONTOUR
S-78-44-29-E 90.00'
S-58-37-04-E 104.76'
50' RECORDED
SETBACK
PROPOSED RESIDENCE
N-45-12-12-W 68.26'
COTTAGE GROVE
LANE
L4
L2
S-77-04-31-W 134.00'
S-01-48-22-E 67.79'