Date Issued 13 Sept 76 Serial No. 0209 ICAR (S) Permit No. 11297

T. C. No. [redacted]


Map Date 6-4-76

MECKLENBURG COUNTY 001-382-13
DEPARTMENT OF ENVIRONMENTAL HEALTH

INSTALLATION, CONSTUCTION, ALTERATION, AND/OR REPAIR PERMIT

(Individual Septic Tank System with Subsurface, Soil Absorption, Effluent Discharge)

Permission is hereby given to X Install or Construct, __ Alter or Repair the individual septic tank wastewater treatment system with subsurface, soil absorption, effluent discharge as specified herein at the described location. This permit is granted based upon the information supplied in application 11297 dated 7-22-76 and this permit shall be void and of no effect if the information provided in the application is not true or is erroneous. All work shall be completed on or before 13 Oct 76, after which date this permit shall be null and void.

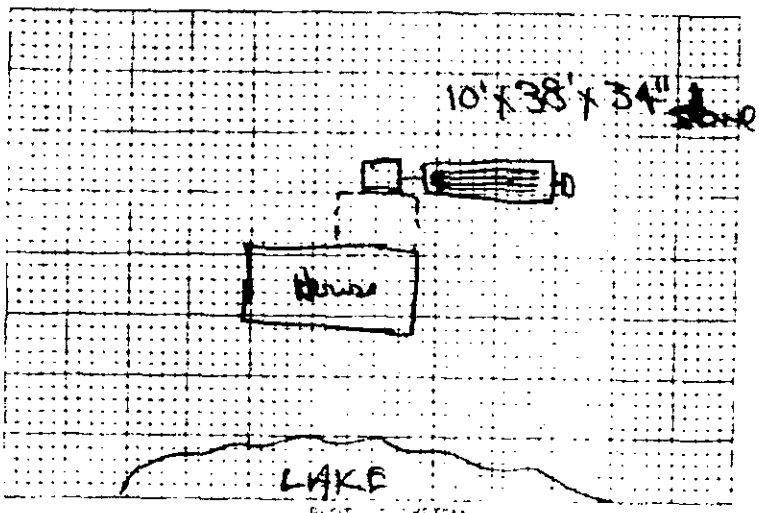

PLOT PLAN OF SYSTEM

Permeability Rate 60

Liquid Capacity of Tank 1000 gal

Tank Constructed of Precast Concrete

Absorption or Distribution Lines

Total Line Length 300 Ft.

Number of Lines 4

Distance from House 10'

Distance from Property Line 10'

Distance from Well 100'

NAME OF OWNER GREEN, Harrold C.

LOCATION OF PROPERTY Tuscarora Trail (Misty Cove Rd)

The system shall meet all of the requirements as set forth in the Regulations of the Mecklenburg County Health Commission which are in effect at the time of the granting of this permit. A certificate of approval must be issued by the Environmental Health Director before any system can be covered up or otherwise rendered uninspectable or can be used.

Comments aeration pit

Division or Section Head

R. M. Reynolds
Environmentalist

* If this permit is for the installation or construction of a new system, it must be signed by the division or a section head of the Department of Environmental Health in order to be valid. Only the signature of the Environmentalist is required where an existing system is being altered or repaired.

EHD-S-76

Environmental Health Department's Copy