# IREDELL COUNTY HEALTH DEPARTMENT

Statesville Office (704) 878-5305 Mooresville Office (704) 660-3625 PERMIT # 221366

## IMPROVEMENT PERMIT / AUTHORIZATION TO CONSTRUCT / OPERATION PERMIT / EXISTING SYSTEM

PIN # 4624-17-7711

APPLICANT: DENISE O'CONNER APPLICANT ADDRESS: 180 BLARNEY RD - MOORESVILLE

SITE ADDRESS: SAME PHONE: 336-577-5776 ALT. PHONE:

SITE DIRECTIONS: BSR, TR TUSKARORA, TR BLARNEY, ON L

SUBDIVISION: EDWARD & ROSE MILLER SECTION: LOT # 1 LOT AREA: .691 AC DESIGN FLOW: 360 L.T.A.R.: .3

Septic Tank Ex. 1000 (gal) STB Date
Pump Tank (gal) PT Date
Pump Make Model Serial #
# Nitrification Fields # Lines EXISTING Linear Ft:
Trench Width Max. Trench Bottom Depth Gravel Depth

☐ New System ☑ Repair ☐ Expansion System Type: I II (III) IV V VI
System Description: 25% REDUCTION
Repair System Description: SAME
Maintenance Agreement Required: ☐ YES ☑ NO
☑ GRAVITY ☐ PRESSURE


☑ Residence No. Bedrooms 3
☐ Business No. Persons 6
☐ Other No. Employees
☐ Slab ☑ Crawl Space
☐ Basement w/plumbing ☐ Basement w/o plumbing

Water Supply: ☑ Private ☐ Public ☐ Community


Comments / Conditions: REMOVE DAMAGED CHAMBERS & REPLACE AS NEEDED

REPLACED 8 CHAMBERS

INITIAL SITE SKETCH

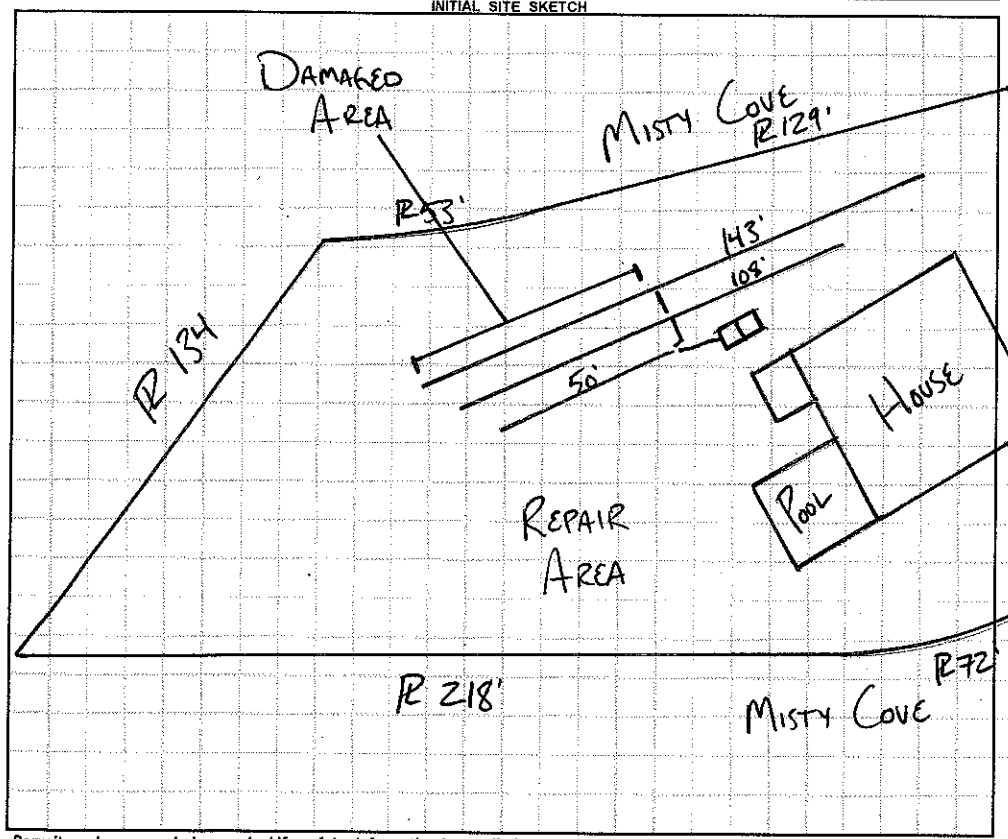


AS BUILT SKETCH

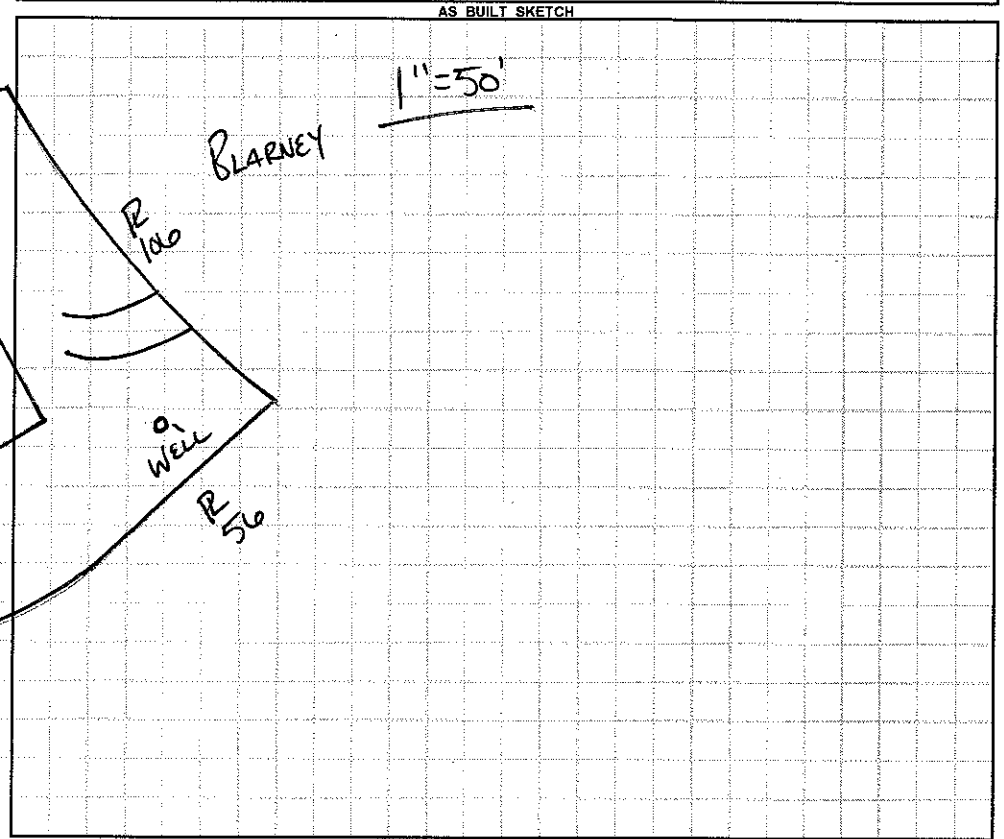


*Permit can be suspended or revoked if any false information is supplied toward securing the permit / any unauthorized changes are made to the site / any unauthorized changes are made in the installation of the system.* **CONTACT A LOCATOR SERVICE PRIOR TO ANY EXCAVATION**


☐ **IMPROVEMENT PERMIT** *with plat valid without expiration.* ☑ **IMPROVEMENT PERMIT** *with site plan valid for 60 mos.* ☑ **AUTHORIZATION TO CONSTRUCT** *valid for period equal to IMPROVEMENT PERMIT--not to exceed 60 mo.*

Owner / Applicant Signature: Denise O'Conner Date: 8/8/2016 Installed by: BASS GRADING

IMPROVEMENT PERMIT by: APPROVED Date: SEP 02 2016 OPERATION PERMIT by: Date: 9-29-16

AUTHORIZATION TO CONSTRUCT by: APPROVED Date: SEP 02 2016 Existing System Inspected by: Date:

Health Dept. Copy - WHITE Applicant (Final Approval) - YELLOW Applicant (Conditional Approval) - PINK

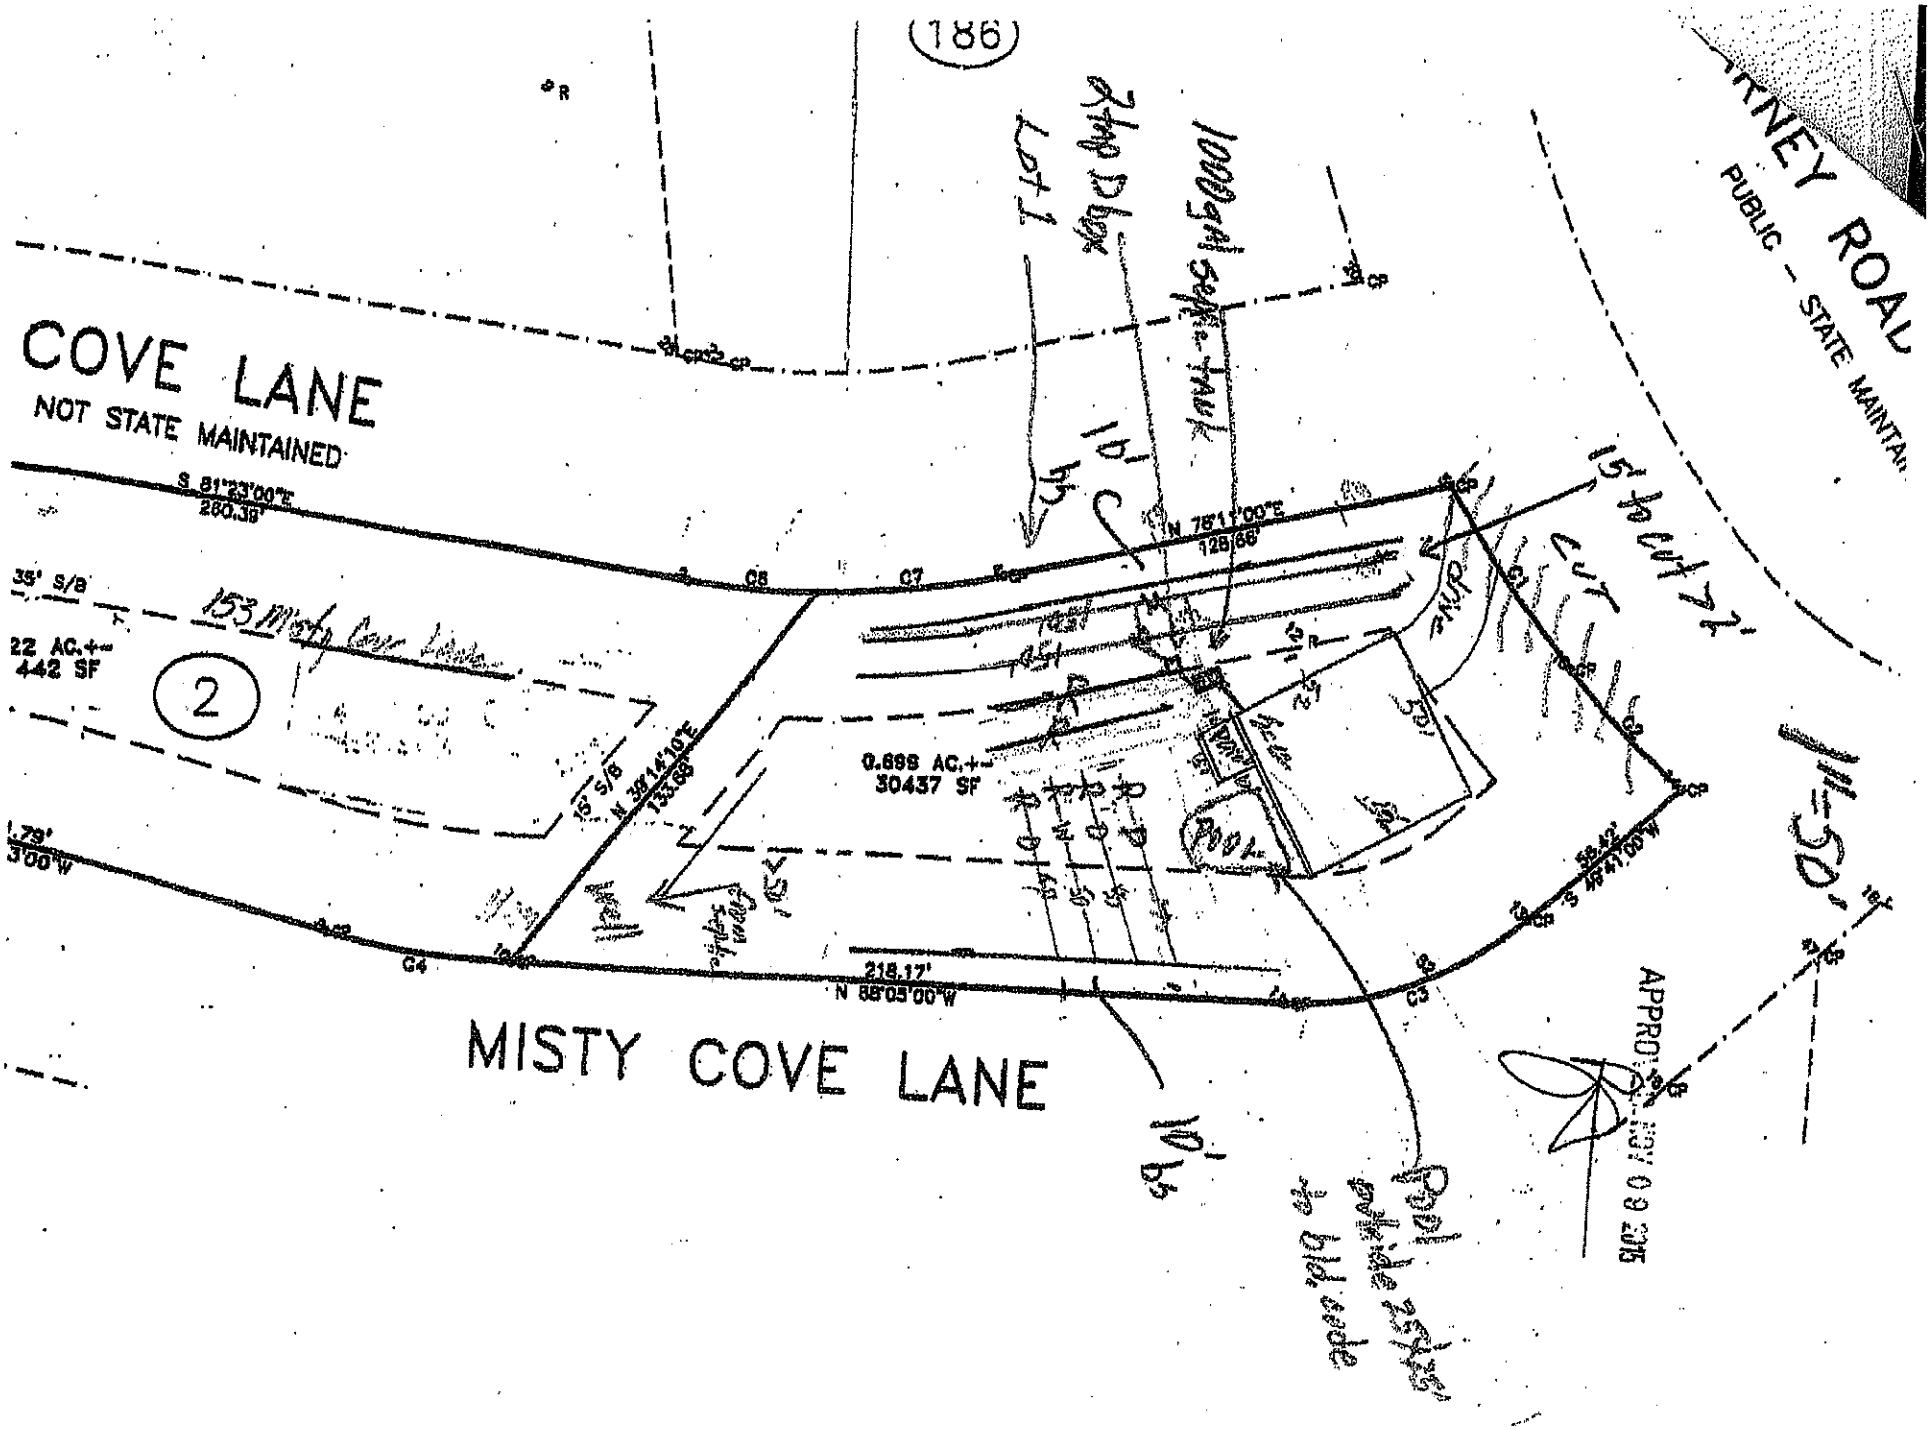
(186)
COVE LANE
NOT STATE MAINTAINED
S 81°23'00"E
260.38'
35' S/B
153 Misty Cove Lane
22 AC.+-
442 SF
2
15' S/B
N 33°14'10"E
133.68'
0.699 AC.+-
30437 SF
N 78°17'00"E
128.68'
C5
C6
C7
C4
C3
218.17'
N 88°03'00"W
MISTY COVE LANE
PUBLIC - STATE MAINTAI
1"=50'
APPROX
NOV 0 8 2005