IREDELL COUNTY HEALTH DEPARTMENT

STATESVILLE 704-878-5305 MOORESVILLE 704-664-5281

IMPROVEMENT PERMIT / AUTHORIZATION TO CONSTRUCT / OPERATION PERMIT / EXISTING SYSTEM INSPECTION

PERMIT# ~~105462~~ - 105469 PIN# 4624 27 5905. 968 4624 18 9680 DATE 5/13/02

OWNER OR CONTRACTOR POINT ON NORMAN / SIMONINI PHONE: Business 660-1185 Home

ADDRESS 224 BRAWLEY SCHOOL RD MOORESVILLE NC 28117

LOCATION BRAWLEY SCHOOL - TR 2nd MANSFIELD - TL BROCKTON - TR 2nd OLDHAM - 8+/- ON LT

SUBDIVISION POINT BLOCK / SECTION 9 LOT 968 LOT AREA 1.0 AC SITE CLASS PS DESIGN FLOW 450 GPD L.T.A.R. .25 gpd/sq ft

Septic Tank: 1000+ Gallons; STB 338 Date 3-27-04

Pump Tank: Gallons; PT Date

Pump Make: Model Serial No.

Nitrification Field: No Fields 1 Square Feet 1440 Linear Feet 480

No Lines 4@120' Trench Width 36" Max Trench Bottom Depth 36" Gravel Depth N/A

☑ New System ☐ Repair System Type: I, II, III, IV, V, VI

System Description: GRAVITY 25% REDUCTION

Repair System Description: LP PANEL

Maintenance Agreement Required: ☐ Yes ☑ No

☐ Slab ☐ Crawl Space ☑ Basement w/plumbing ☐ Basement wo/plumbing

☐ House/Mod. Home No. Bedrooms 4

☐ Mobile Home No. Bathrooms 4

☐ Business No. Employees


☐ Other

Water Supply: ☐ Individual ☐ Public ☑ Community


Comments:/Conditions:

Comments:/Conditions:

1"=50' INITIAL SITE SKETCH

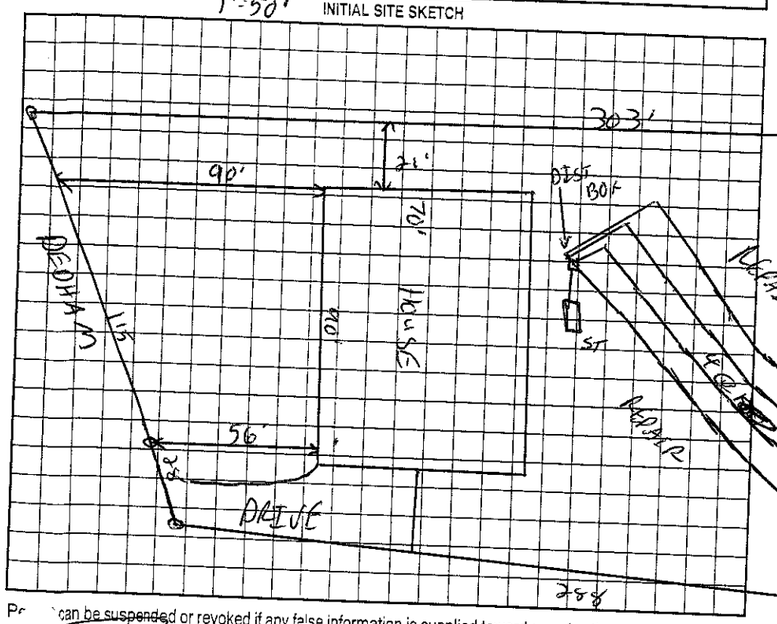

AS BUILT SKETCH

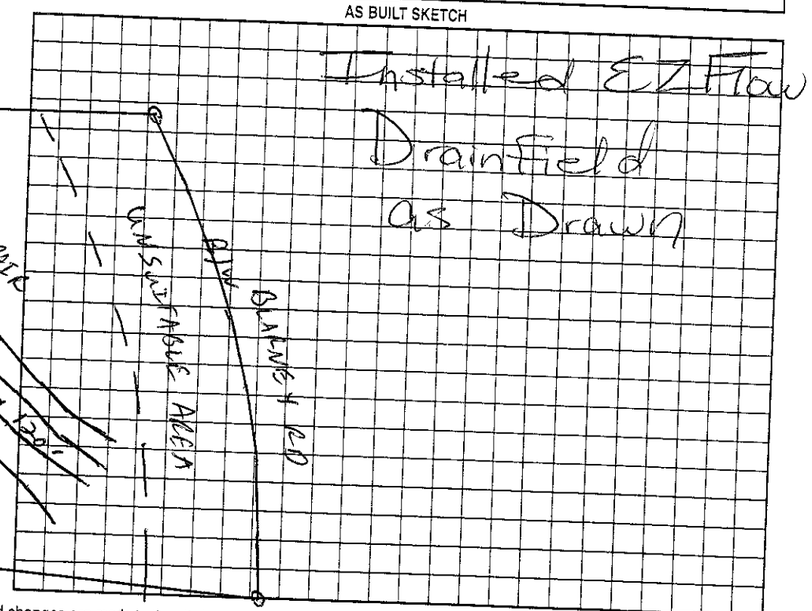

Permit can be suspended or revoked if any false information is supplied toward securing the permit/any unauthorized changes are made to the site/any unauthorized changes are made in the installation of the system. Improvement Permit with plat valid without expiration. Improvement Permit with site plan valid for sixty months. Authorization to Construct is valid for a period equal to that of Improvement Permit – not to exceed sixty months.

Evaluated by: [signature] RS date 5-23-02 Installed by: R&H

Permit by: C. [signature] RS date 5/13/02 Operation Permit by: [signature] RS date 5/11/04

Inspected by: Wesley Sparks R.S. date 12/12/03 Existing System Inspection by: date

HEALTH DEPT. COPY: WHITE OWNER COPY (FINAL): YELLOW OWNER COPY (INITIAL): PINK