IREDELL COUNTY HEALTH DEPARTMENT

STATESVILLE 5305 MOORESVILLE 704-664-5281

245.00 Paid 7-30-04 DT 1130

IMPROVEMENT PERMIT / AUTHORIZATION TO CONSTRUCT / OPERATION PERMIT / EXISTING SYSTEM INSPECTION

PERMIT# 105457 PIN# ~~4627-27-4705~~ 4624-18-9735 DATE 7/22/04

OWNER OR CONTRACTOR Simonini Builders PHONE: Business 704-358-9940 Home

ADDRESS 817 E. Morehead St. Charlotte NC 28202

LOCATION BSR, TR 2nd Mansfield, TR Brockton, TR 2nd Redbank, 9th on Lt.

SUBDIVISION Point BLOCK / SECTION 4 LOT 967 LOT AREA 1.02AC SITE CLASS PS DESIGN FLOW 600 L.T.A.R. 0.25

Septic Tank: 1500 Gallons; STB 338 Date 8-7-04

Pump Tank: 1500 Gallons; PT 477 Date 8-3-04

Pump Make: ~~Myers~~ Goulds Model ~~MF605~~ WE0312M0 Serial No.

Nitrification Field: (No) Fields 1 Square Feet 1200 Linear Feet 400

No Lines 5 Trench Width 24"or36" Max Trench Bottom Depth 36" Gravel Depth —

☒ New System ☐ Repair System Type: I, II, III, (IV) V, VI

System Description: LP Panel Block

Repair System Description: Same

Maintenance Agreement Required: ☒ Yes ☐ No

☒ House/Mod. Home ☐ Mobile Home ☐ Business ☐ Other

No. Bedrooms 5 No. Bathrooms 5 No. Employees

☐ Slab ☒ Crawl Space ☐ Basement w/plumbing ☐ Basement wo/plumbing

Water Supply: ☐ Individual ☐ Public ☒ ~~Community~~


Comments:/Conditions:

Location OK
Rick Jarvis
Simonini Builders


Comments:/Conditions:

Installed 4-100' lines
Checked tanks & lines 9/15/04
Pressure, elect & alarm 2/8/05 MD

INITIAL SITE SKETCH

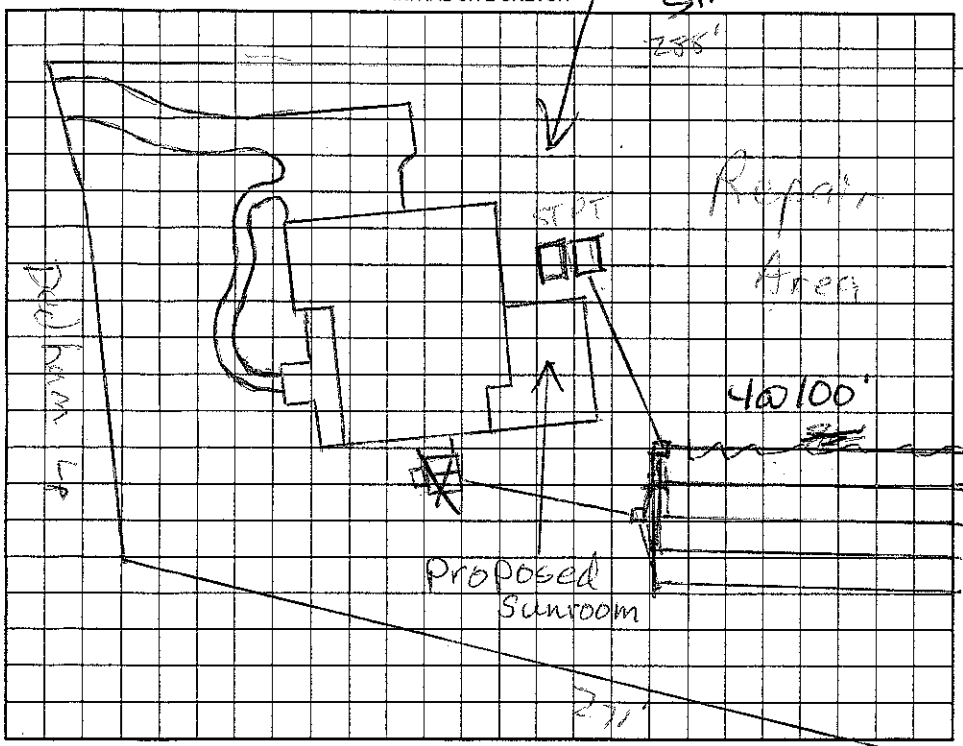

AS BUILT SKETCH

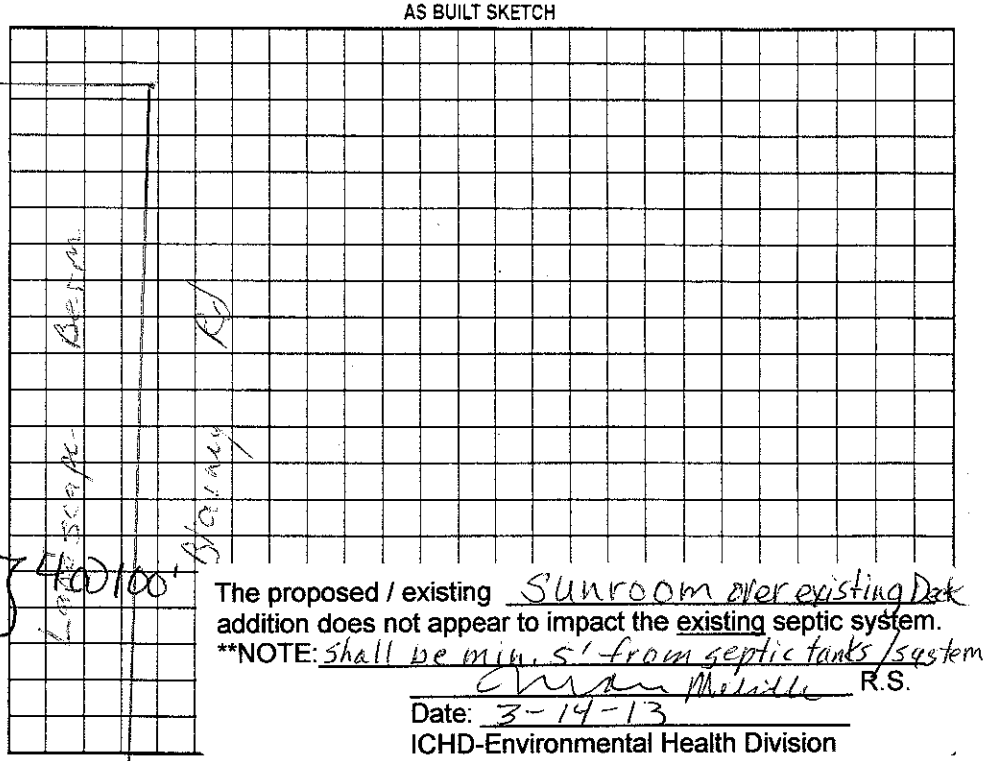

The proposed / existing Sunroom over existing Deck addition does not appear to impact the existing septic system.

**NOTE: shall be min. 5' from septic tanks / system

Susan Melville R.S.

Date: 3-14-13

ICHD-Environmental Health Division

Permit can be suspended or revoked if any false information is supplied toward securing the permit/any unauthorized changes are made to the site/any unauthorized changes are made in the installation of the system. Improvement Permit with plat valid without expiration. Improvement Permit with site plan valid for sixty months. Authorization to Construct is valid for a period equal to that of Improvement Permit – not to exceed sixty months.

Signed: _____ date 8-10-04 Installed by: _____

Improvement Permit by: _____ RS date 7/22/04 Operation Permit by: Maura H. Dobson RS date 2/8/05

Authorization to Construct by: _____ RS date 7/22/04 Existing System Inspection by: _____ date _____

HEALTH DEPT. COPY: WHITE OWNER COPY (FINAL): YELLOW OWNER COPY (INITIAL): PINK