IREDELL COUNTY HEALTH DEPARTMENT

STATESVILLE 704-878-5305 MOORESVILLE 704-664-5281

IMPROVEMENT PERMIT / AUTHORIZATION TO CONSTRUCT / OPERATION PERMIT / EXISTING SYSTEM INSPE[illegible]

PERMIT# 105456 PIN# 4624 27 5905, 966 4624 18 9934

OWNER OR CONTRACTOR POINT ON NORMAN/SIMONINI BUILDERS PHONE: Business 660-1185 DATE 5/13/03

ADDRESS 2214 BRAWLEY SCHOOL RD - MOORESVILLE 28117 Home

LOCATION BRAWLEY SCHOOL: TR 2nd MANSFIELD - TL BROCKTON - TR 2nd DEDHAM - 10th ON LT #168

SUBDIVISION POINT BLOCK / SECTION 9 LOT 966 LOT AREA 1.23AC SITE CLASS. PS DESIGN FLOW 480GPD L.T.A.R. .36PD/LT

Septic Tank: 1000+ Gallons: STB 338 Date

Pump Tank: Gallons: PT Date

Pump Make: Model Serial No.

Nitrification Field: No Fields 1 Square Feet 1200 Linear Feet 400

No Lines 4@100 Trench Width 36" Max Trench Bottom Depth 36" Gravel Depth N/A

☑ New System ☐ Repair System Type: I, II, (III), IV, V, VI

System Description: GRAVITY 25% REDUCTION

Repair System Description: LP PANEL

Maintenance Agreement Required: ☐ Yes ☑ No

☐ Slab ☑ Crawl Space ☑ Basement w/plumbing ☐ Basement wo/plumbing

☑ House/Mod. Home No. Bedrooms 4

☐ Mobile Home No. Bathrooms 4

☐ Business No. Employees


☐ Other

Water Supply: ☐ Individual ☐ Public ☑ Community


Comments:/Conditions:

Comments:/Conditions: 5@80'
Tanks & lines Checked 7/10/03 MD
Blue filter installed
Checked D-box 7/11/03

1"=50' INITIAL SITE SKETCH

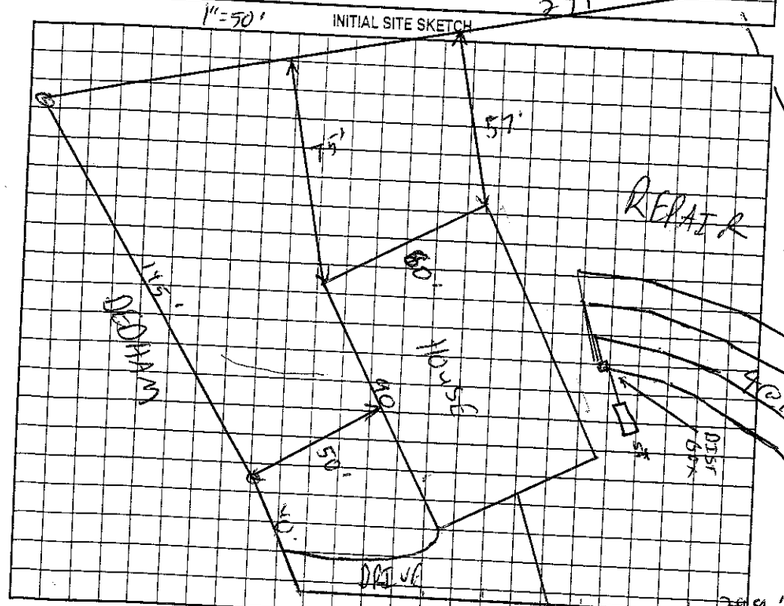

AS BUILT SKETCH

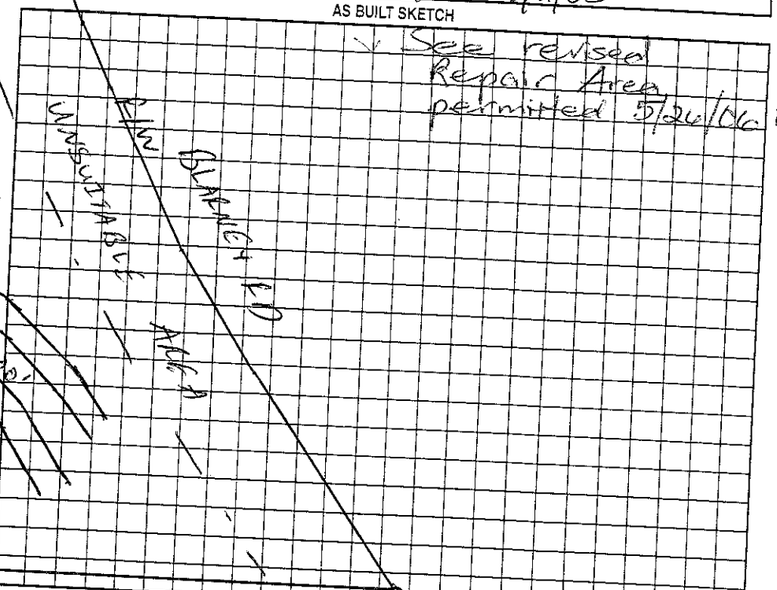

Permit can be suspended or revoked if any false information is supplied toward securing the permit/any unauthorized changes are made to the site/any unauthorized changes are made in the installation of the system. Improvement Permit with plat valid without expiration. Improvement Permit with site plan valid for sixty months. Authorization to Construct is valid for a period equal to that of Improvement Permit – not to exceed sixty months.

Signed: date 5-23-03

Improvement Permit by: C. [illegible] RS date 5/13/03

Authorization to Construct by: [illegible] RS date 7/6/03

Installed by: R & H, INC RS

Operation Permit by: Mark Hall Johnson RS date 7/11/03

Existing System Inspection by: date

HEALTH DEPT. COPY: WHITE OWNER COPY (FINAL): YELLOW OWNER COPY (INITIAL): PINK