IREDELL COUNTY HEALTH DEPARTMENT

STATESVILLE 704-878-5305 MOORESVILLE 704-664-5281

IMPROVEMENT PERMIT / AUTHORIZATION TO CONSTRUCT / OPERATION PERMIT / EXISTING SYSTEM INSPECTION

PERMIT# 134547 PIN# 4624899434 DATE 5/26/06

OWNER OR APPLICANT John Sicotte / EFC EFC

ADDRESS 168 Dedham Ln Mooresville, NC 28117 PHONE: Business 664-8047 Home

LOCATION Brawley School Rd TR 2nd Mansfield TL Brockton TR 2nd Dedham 10th on left

SUBDIVISION Points BLOCK / SECTION 9 LOT 96 LOT AREA 1.23 Acre SITE CLASS PS DESIGN FLOW 480 L.T.A.R. .3

Septic Tank: 1500 Gallons; STB Date

Pump Tank: Gallons; PT Date

Pump Make: Model Serial No.

Nitrification Field: No. Fields 1 Square Feet 1200' Linear Feet 400'

No. Lines 5@80' Trench Width 36" Max Trench Bottom Depth 36 Gravel Depth N/A

☐ New System ☐ Repair ☐ Expansion System Type: ☒ I ☐ II ☐ III ☐ IV ☐ V ☐ VI

Existing

System Description: Gravity - 25% Reduction

Repair System Description: Pump-LP-Panel Blk

Maintenance Agreement Required: ☐ Yes ☒ No

☒ Gravity ☐ Pressure

☒ House/Mod. Home ☐ Mobile Home ☐ Business ☐ Other

No. Bedrooms 4 No. Persons No. Employees

Water Supply: ☐ Individual ☒ Public ☒ Community


☐ Slab ☒ Crawl Space ☐ Basement w/plumbing ☐ Basement wo/plumbing

Existing

Comments/Conditions:

Scale 1:50


INITIAL SITE SKETCH

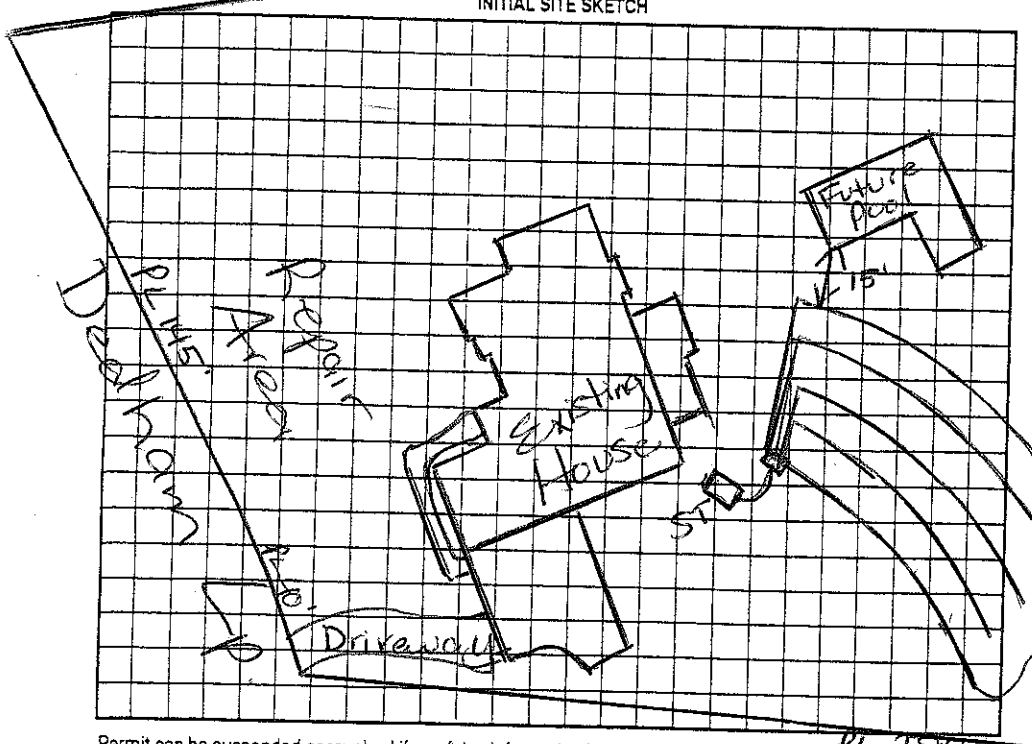

Comments/Conditions: Existing System appears to be functioning okay at time of inspection. Okay to install pool in backyard at least 15ft from existing system.

AS BUILT SKETCH

Repair Area now in front yard to accomodate pool.

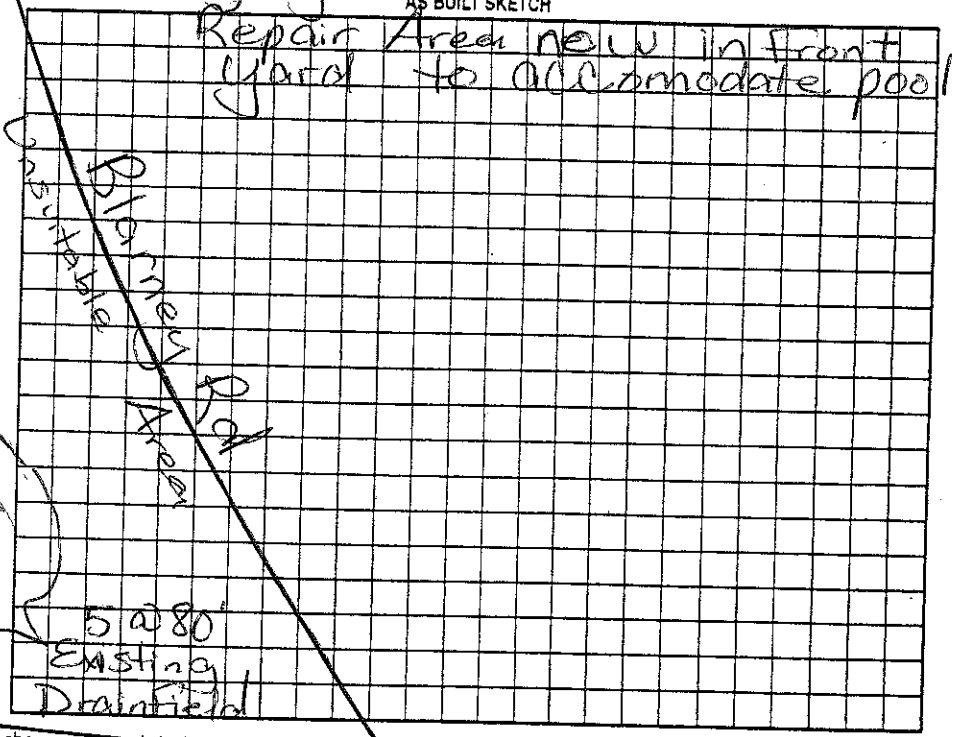

Permit can be suspended or revoked if any false information is supplied toward securing the permit, any unauthorized changes are made to the site, any unauthorized changes are made in the installation of the system. Improvement Permit with plat valid without expiration. ☐ Improvement Permit with site plan valid for sixty months ☐ Authorization to Construct is valid for a period equal to that of Improvement Permit – not to exceed sixty months.

Signed: Deborah M. Brawley date 5/31/06 Installed by:

Improvement Permit by: Marian H. Dotson RS date 5/26/06 Operation Permit by: date

Authorization to Construct by: Marian H. Dotson RS date 5/26/06 Existing System Inspection by: Marian H. Dotson RS date 5/26/06

HEALTH DEPT. COPY: WHITE OWNER COPY (FINAL): YELLOW OWNER COPY (INITIAL): PINK

IREDELL COUNTY HEALTH DEPARTMENT

STATESVILLE 704-878-5305 MOORESVILLE 704-664-5281

IMPROVEMENT PERMIT / AUTHORIZATION TO CONSTRUCT / OPERATION PERMIT / EXISTING SYSTEM INSPECTION

PERMIT# 105456 PIN# 4624 27 5905. 966 DATE 5/13/02

OWNER OR CONTRACTOR POINT ON NORMAN/SIMONINI BUILDERS PHONE: Business 660-1155 Home

ADDRESS 2214 BRAWLEY SCHOOL RD - MOORESVILLE 28117

LOCATION BRAWLEY SCHOOL - TR 2nd MANSFIELD - TL BROOKTON - TR 2nd DEEHAM - 10th ON LT

SUBDIVISION POINT BLOCK / SECTION 9 LOT 966 LOT AREA 1.23AC SITE CLASS. PS DESIGN FLOW 480GPD L.T.A.R. .36GPD/LF±

Septic Tank: 1000± Gallons; STB 338 Date

Pump Tank: Gallons; PT Date

Pump Make: Model Serial No.

Nitrification Field: No. Fields 1 Square Feet 1800 Linear Feet 400

No. Lines 4@100 Trench Width 36" Max Trench Bottom Depth 36" Gravel Depth N/A

☑ New System ☐ Repair System Type: I, II, (III), IV, V, VI

System Description: GRAVITY 25% REDUCTION

Repair System Description: LP PANEL

Maintenance Agreement Required: ☐ Yes ☑ No

☑ House/Mod. Home No. Bedrooms 4

☐ Mobile Home No. Bathrooms 4

☐ Business No. Employees

☐ Other


☐ Slab ☑ Crawl Space ☑ Basement w/plumbing ☐ Basement wo/plumbing

Water Supply: ☐ Individual ☐ Public ☑ Community


Comments:/Conditions:

Comments:/Conditions: 5@80'
Tanks & lines Checked 7/10/03 MS
Blue filter installed
Checked D-box 7/11/03

1"=50' INITIAL SITE SKETCH

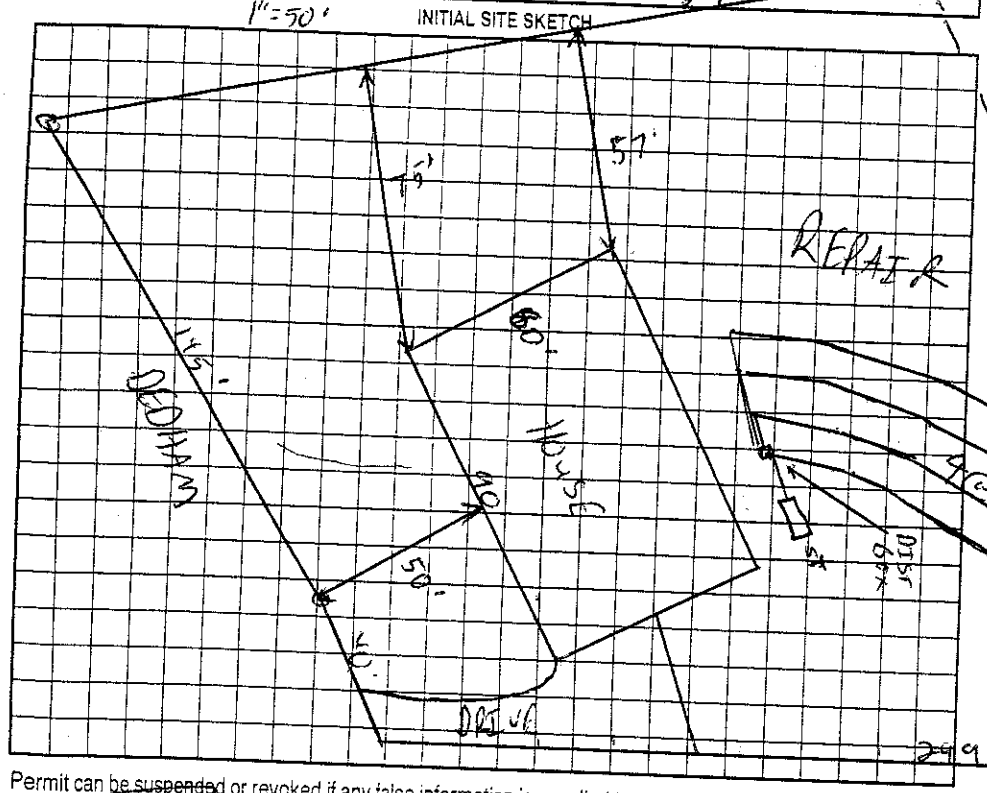

AS BUILT SKETCH

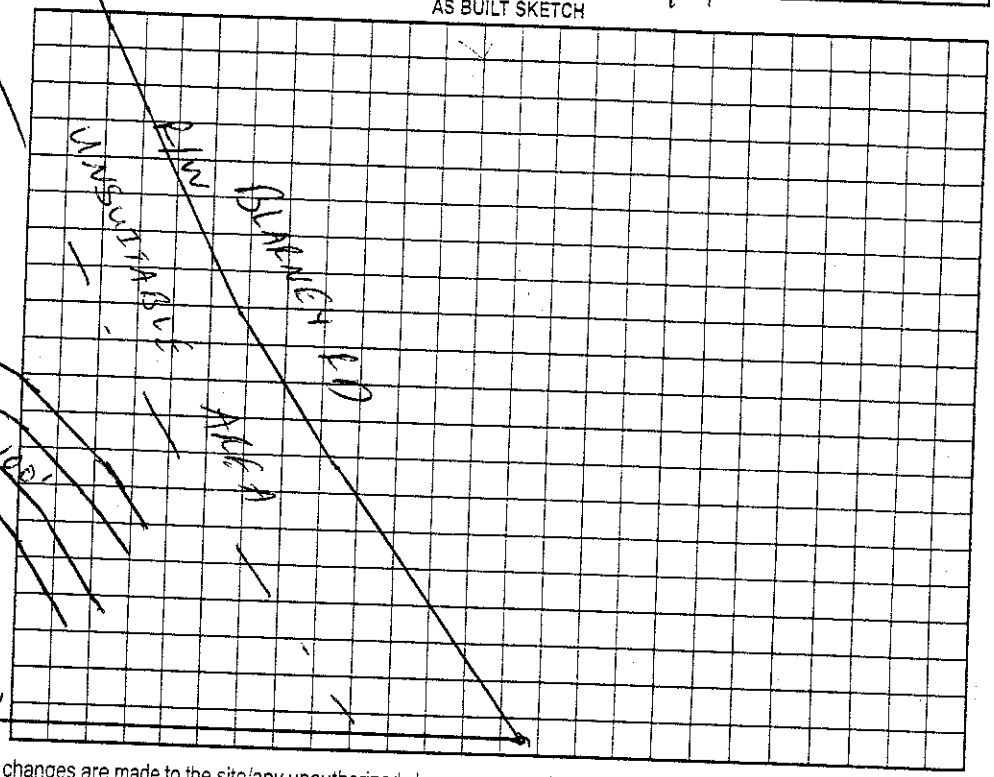

Permit can be suspended or revoked if any false information is supplied toward securing the permit/any unauthorized changes are made to the site/any unauthorized changes are made in the installation of the system. Improvement Permit with plat valid without expiration. Improvement Permit with site plan valid for sixty months. Authorization to Construct is valid for a period equal to that of Improvement Permit – not to exceed sixty months.

Signed: date 5-13-02 Installed by: R & T INC RS

Improvement Permit by: C. RS date 5/13/02 Operation Permit by: Mark Wilson RS date 7/11/03

Authorization to Construct by: RS date 5/16/03 Existing System Inspection by: date

HEALTH DEPT. COPY: WHITE OWNER COPY (FINAL): YELLOW OWNER COPY (INITIAL): PINK