IREDELL COUNTY HEALTH DEPARTMENT

Statesville Phone TR 3-7271 Mooresville Phone NO 3-1271

PERMIT TO INSTALL SEPTIC TANK

Permit No. _____ Permit Date April - 2 1965

Owner Jake Carpenter Address CHARLOTTE N.C.

Installed By DENVER PLUMBING CO Address DENVER ROUTE #1

Location of Property Section - 6 - Lot 80 on Lake Norman


is MAYHEW TOWN SECTION

Tank		Capacity		Length of Lines		Fixtures	
Block	( )	1000	(✓)	225'	(✓)	No. of Baths	(1)
Precast	(✓)	1250	( )	250'	( )	Dishwasher	( )
		1500	( )	Other _____		Garbage Grdr.	( )
		Other _____				Other _____	

NOTIFY HEALTH DEPARTMENT AT LEAST EIGHT HOURS BEFORE TANK IS TO BE INSPECTED.

Final Inspection April 2 1965 Approved (✓) Disapproved ( )

Remarks _____

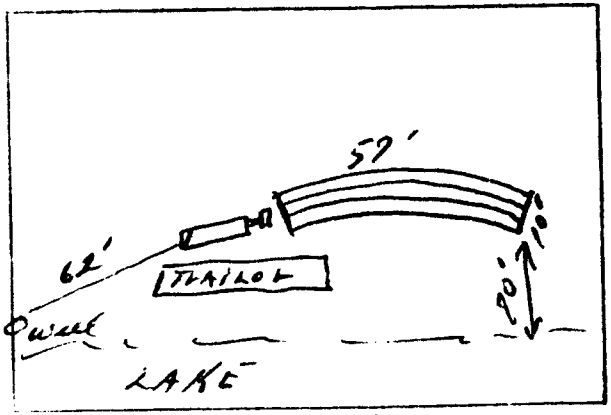

Sketch of Installation

_____

Sanitarian