IREDELL COUNTY HEALTH DEPARTMENT

Statesville Office (704) 878-5305 RA Mooresville Office (704) 660-3625 PERMIT # 209085

IMPROVEMENT PERMIT / AUTHORIZATION TO CONSTRUCT / OPERATION PERMIT / EXISTING SYSTEM

PIN # 4624-19-7457

APPLICANT: Ray Reachion / Bill Henley APPLICANT ADDRESS: 402 Beech Tree Rd Mooresville NC 28117

SITE ADDRESS: 234 Stonemarker Rd PHONE: 704-617-2254 ALT. PHONE: 704-677-3040

SITE DIRECTIONS: Brawley Sch Rd, TR on Stonemarker Rd, Lot on R across from Blarney Rd

SUBDIVISION: CL&T SECTION: 6 LOT # 78 LOT AREA: 1.240 ac DESIGN FLOW: 360 gpd L.T.A.R.:

Septic Tank (2) EXISTING (gal) STB Date
Pump Tank (gal) PT Date
Pump Make Model Serial #
Nitrification Fields 2 # Lines EXISTING Linear Ft:
Trench Width Max. Trench Bottom Depth Gravel Depth

☐ New System ☐ Repair ☐ Expansion System Type: I (II) III IV V VI
System Description: EXISTING BED + Conventional
Repair System Description:
Maintenance Agreement Required: ☐ YES ☑ NO
☑ GRAVITY ☐ PRESSURE

☑ Residence No. Bedrooms 3
☐ Business No. Persons
☑ Other No. Employees
☐ Slab ☐ Crawl Space
☐ Basement w/plumbing ☐ Basement w/o plumbing


Water Supply: ☑ Private ☐ Public ☐ Community

Comments / Conditions:


ADDITION OF 540 Sq Ft DECK

*System Appeared to be Functioning at Time of Inspection

INITIAL SITE SKETCH

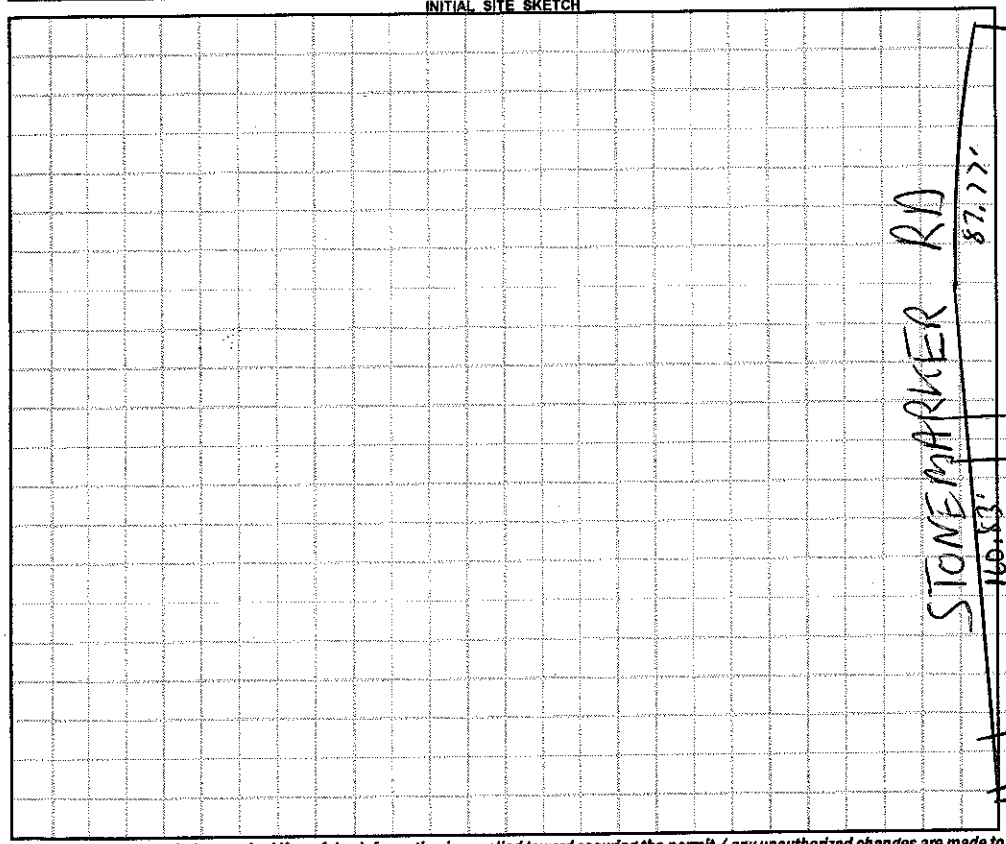

AS BUILT SKETCH

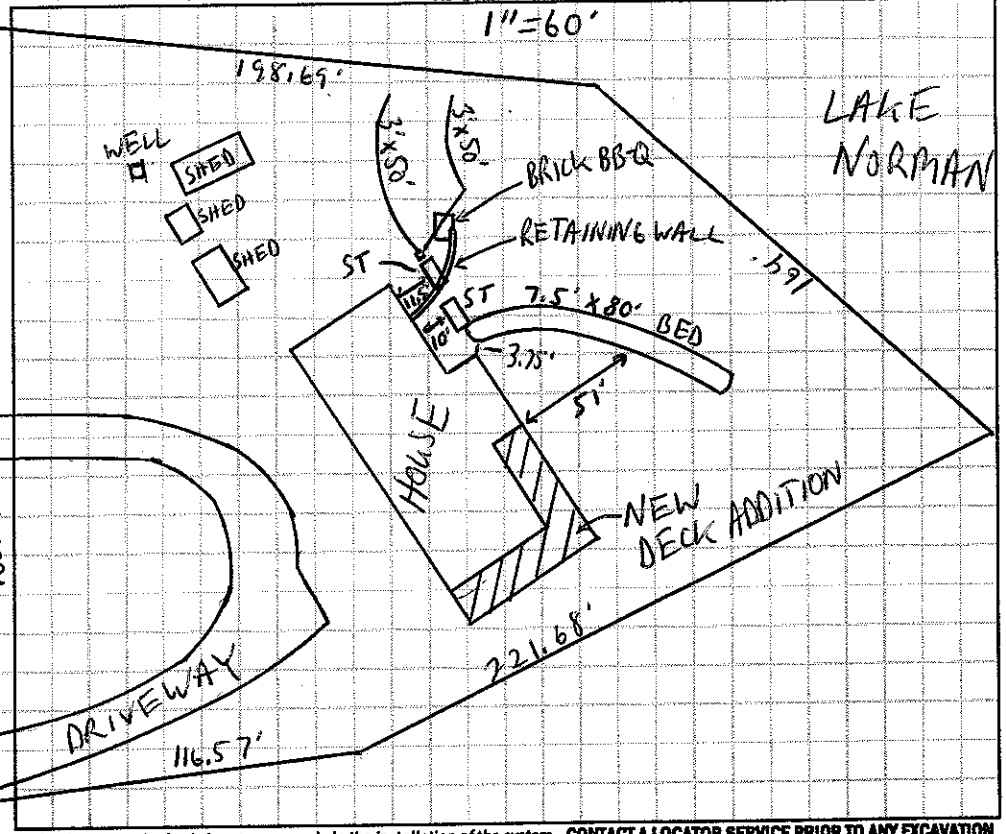

Permit can be suspended or revoked if any false information is supplied toward securing the permit / any unauthorized changes are made to the site / any unauthorized changes are made in the installation of the system. **CONTACT A LOCATOR SERVICE PRIOR TO ANY EXCAVATION**

☐ **IMPROVEMENT PERMIT** *with plat valid without expiration.* ☐ **IMPROVEMENT PERMIT** *with site plan valid for 60 mos.* ☐ **AUTHORIZATION TO CONSTRUCT** *valid for period equal to IMPROVEMENT PERMIT--not to exceed 60 mo.*

Owner / Applicant Signature: Date: 17APR15 Installed by:

IMPROVEMENT PERMIT by: Date: OPERATION PERMIT by: Date:

AUTHORIZATION TO CONSTRUCT by: Date: Existing System Inspected by: Date: 4-16-15

Health Dept. Copy - WHITE Applicant (Final Approval) - YELLOW Applicant (Conditional Approval) - PINK