Rock Neck Sa L-731-430

550.00 Paid

IREDELL COUNTY HEALTH DEPARTMENT

STATESVILLE 704-878-5305 MOORESVILLE 704-664-5281

IMPROVEMENT PERMIT / AUTHORIZATION TO CONSTRUCT / OPERATION PERMIT / EXISTING SYSTEM INSPECTION

PERMIT# 132094 PIN# 4624 23 3282 DATE 1/3/06

OWNER OR APPLICANT Craig & Karen Mathiason PHONE: Business 336 202 4771 Home

ADDRESS 308 Winrow Dr Jamestown, NC 27282

LOCATION Brawley School Rd @ Lot near end of Road 2596 Brawley School Rd

SUBDIVISION NA CL+T BLOCK / SECTION 6 LOT 1 LOT AREA .98 acres SITE CLASS. PS DESIGN FLOW 480 gpd L.T.A.R. .3

Septic Tank: 1000 Gallons: STB 794 Date 12-15-06

Pump Tank: 1000 Gallons: PT 27 Date 11-2-06

Pump Make: Myers Model ME 50 Serial No.

Nitrification Field: No. Fields 1 Square Feet eq 1600 Linear Feet 270

No Lines 5 Trench Width 24" Max Trench Bottom Depth 36" Gravel Depth NA ☐ Gravity ☒ Pressure

☒ New System ☐ Repair ☐ Expansion System Type: I II III ⓘ V VI

System Description: LPP ABAS

Repair System Description: same

Maintenance Agreement Required: ☒ Yes ☐ No

☒ House/Mod. Home No. Bedrooms 4

☐ Mobile Home No. Persons

☐ Business No. Employees

☐ Other


Water Supply: ☒ Individual ☐ Public ☐ Community

☐ Slab ☒ Crawl Space ☐ Basement w/plumbing ☐ Basement wo/plumbing

Comments:/Conditions: INSTALL ON CONTOUR. MAINTAIN SETBACKS. USE 5/32 HOLES. SIZE PUMP TO DELIVER 28 GPM VS. 48' TDH


SCALE: 1" = 60'

INITIAL SITE SKETCH

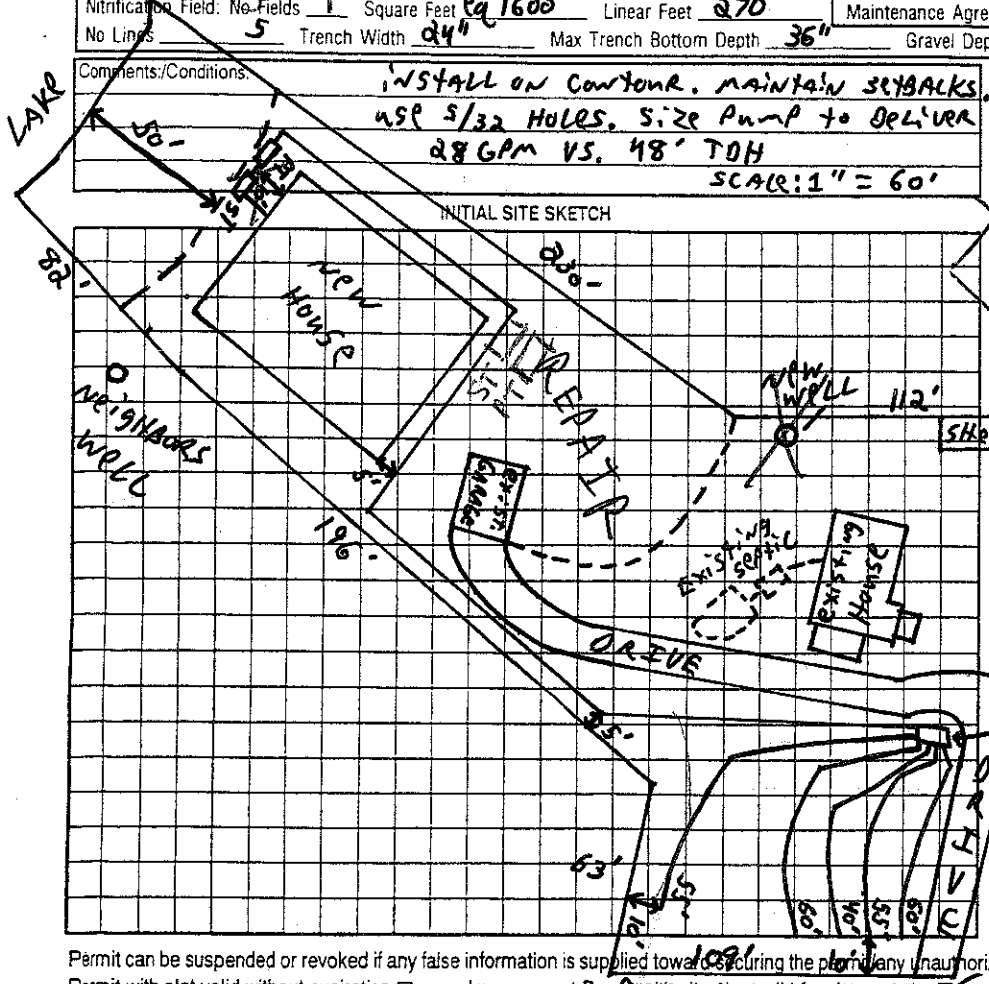

Comments:/Conditions: Checked tanks 2/7/07

AS BUILT SKETCH

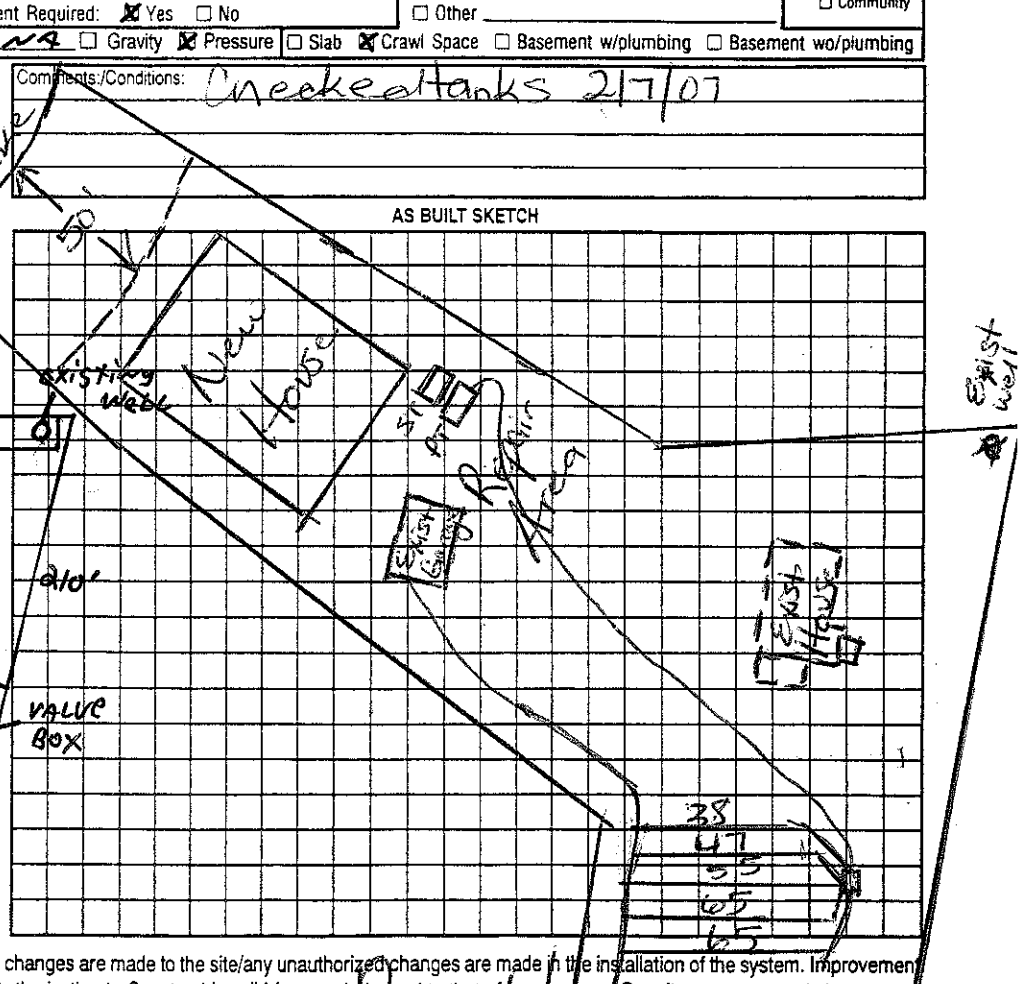

Permit can be suspended or revoked if any false information is supplied toward securing the permit, any unauthorized changes are made to the site/any unauthorized changes are made in the installation of the system. Improvement Permit with plat valid without expiration ☐ Improvement Permit with site plan valid for six months ☒ Authorization to Construct is valid for a period equal to that of Improvement Permit – not to exceed sixty months.

Signed: [signature] date 1/19/06

Improvement Permit by: [signature] date 1/3/06

Authorization to Construct by: [signature] date 2/23/06

Installed by: [signature] Brawley School Rd

Operation Permit by: [signature] date 3/14/07

Existing System Inspection by: date

HEALTH DEPT. COPY: WHITE OWNER COPY (FINAL): YELLOW OWNER COPY (INITIAL): PINK