IREDELL COUNTY HEALTH DEPARTMENT

STAT[illegible] 1-878-5305 D MOORESVILLE 704-664-5281

IMPROVEMENT PERMIT / AUTHORIZATION TO CONSTRUCT / OPERATION PERMIT / EXISTING SYSTEM INSPECTION

PERMIT# 13167 PIN# 4624-23-7111 4624-23-4163 DATE

OWNER OR CONTRACTOR Greg Thompson PHONE: Business 704 987 5126 Home

ADDRESS 19501 Mary Ann Grey Cr. Cornelius NC

LOCATION BSR Near End on Rt #2664 Brawley Sch. Rd

SUBDIVISION CL&T BLOCK / SECTION 6 LOT 7 LOT AREA 0.72 Ac SITE CLASS. PS DESIGN FLOW 480 L.T.A.R. 0.3

Septic Tank: 1000 Gallons; STB 312 Date 1-3-06
Pump Tank: 1000 Gallons; PT 283 Date 2-10-06
Pump Make: Myers Model ME50 Serial No.
Nitrification Field: No Fields 1 Square Feet 540 Linear Feet 270
No Lines 3@90' Trench Width 24" Max Trench Bottom Depth 36" Gravel Depth —

☒ New System ☐ Repair System Type: I, II, III, ☒ IV, V, VI
System Description: LP Panel Block
Repair System Description: Same
Maintenance Agreement Required: ☒ Yes ☐ No

☒ House/Mod. Home No. Bedrooms 4
☐ Mobile Home No. Bathrooms
☐ Business No. Employees
☐ Other


☐ Slab ☒ Crawl Space ☐ Basement w/plumbing ☐ Basement wo/plumbing

Water Supply: ☒ Individual ☐ Public ☐ Community


Comments:/Conditions: New Drive To Follow old Gravel DRIVE

Comments: Conditions: 2/10/07 Installed drainlines as shown 350' from tanks to well Checked tanks 2/7/07

INITIAL SITE SKETCH

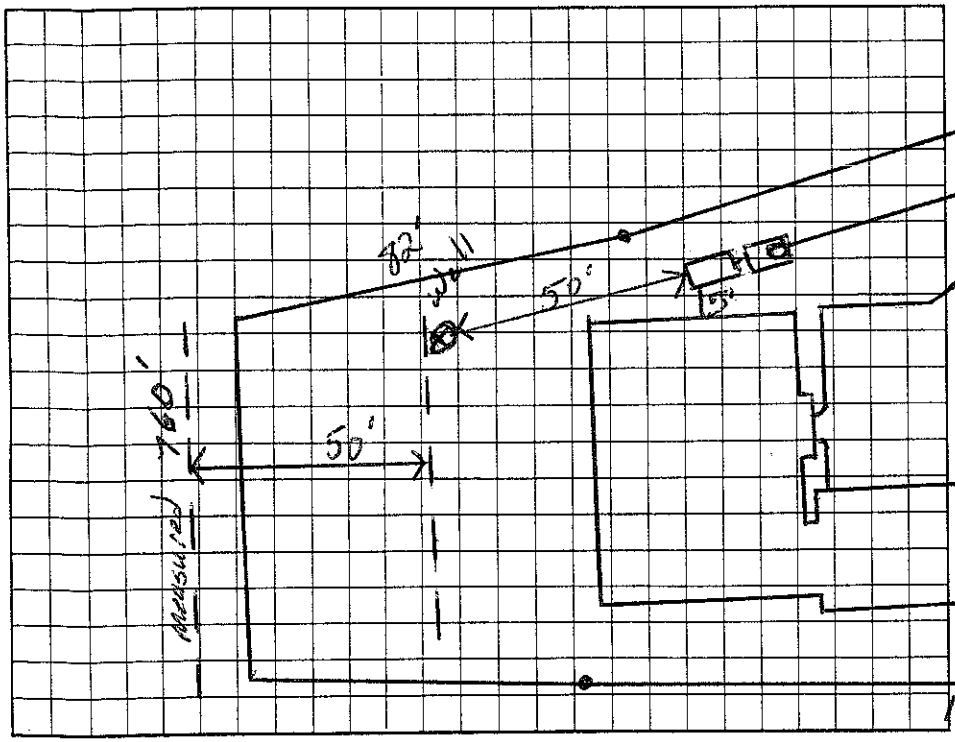

AS BUILT SKETCH

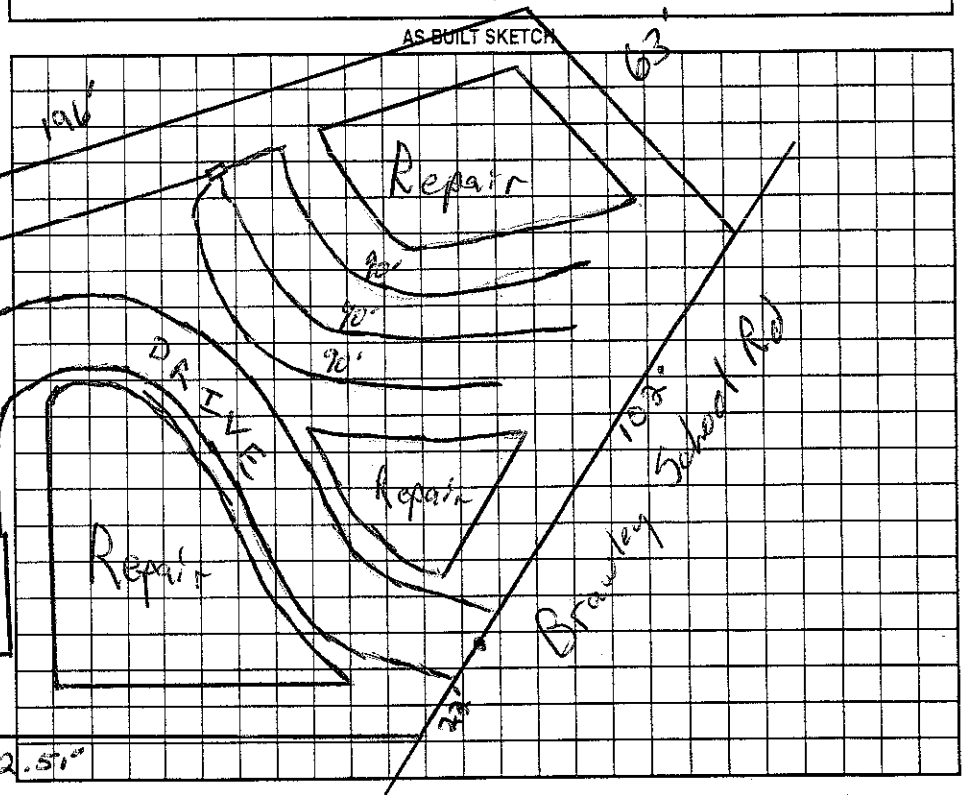

Permit can be suspended or revoked if any false information is supplied toward securing the permit/any unauthorized changes are made to the site/any unauthorized changes are made in the installation of the system. Improvement Permit with plat valid without expiration. Improvement Permit with site plan valid for sixty months. Authorization to Construct is valid for a period equal to that of Improvement Permit – not to exceed sixty months.

Signed: [signature] date 12-13-05

Improvement Permit by: [signature] RS date 12/9/05

Authorization to Construct by: [signature] RS date 12/9/05

Installed by: R & H KS

Operation Permit by: [signature] date 5/18/07

Existing System Inspection by: date

HEALTH DEPT. COPY: WHITE OWNER COPY (FINAL): YELLOW OWNER COPY (INITIAL): PINK