IREDELL COUNTY HEALTH DEPARTMENT

STATESVILLE 704-878-5305 MOORESVILLE 704-664-5281

IMPROVEMENT PERMIT / AUTHORIZATION TO CONSTRUCT / OPERATION PERMIT / EXISTING SYSTEM INSPECTION

PERMIT# 107852 PIN# 4624-23-6479 DATE 8/14/02

OWNER OR CONTRACTOR Crescent Resources & Williams Const. PHONE: Business 704 663 6805 Home

ADDRESS PO Box 1003 400 S. Tryon Charlotte NC 28201

LOCATION Brawley School, on Corner of Ripple Water

SUBDIVISION CL&T MECKENEC BLOCK / SECTION 6 LOT 465 LOT AREA 0.89A SITE CLASS. PS DESIGN FLOW 360 L.T.A.R. 0.3

Septic Tank: 1000 Gallons; STB 825 Date 7/28/05

Pump Tank: 1000 Gallons; PT 302 Date 4/27/05

Pump Make: Zoeller Model N 152 Serial No.

Nitrification Field: No Fields 1 Square Feet 630 Linear Feet 210

No Lines 3 @ 70' Trench Width 24" - 36" Max Trench Bottom Depth 36" Gravel Depth —

☒ New System ☐ Repair System Type: I. II. III. (IV) V. VI

System Description: LP Panel Block

Repair System Description: Bed Prior to 1985

Maintenance Agreement Required: ☒ Yes ☐ No

☒ House/Mod. Home ☐ Mobile Home ☐ Business ☐ Other

No. Bedrooms 3 No. Bathrooms 3 No. Employees

Water Supply: ☒ Individual ☐ Public ☐ Community

☐ Slab ☐ Crawl Space ☒ Basement w/plumbing ☐ Basement wo/plumbing


Comments:/Conditions:

* Solid Pipe Through Road bed
- Well may need to go into the center of the lot
To be away From Septic on Lot 466 Sect 6


Comments:/Conditions: Partial

GM 3/16/04 48 Panel
3/16" holes

INITIAL SITE SKETCH

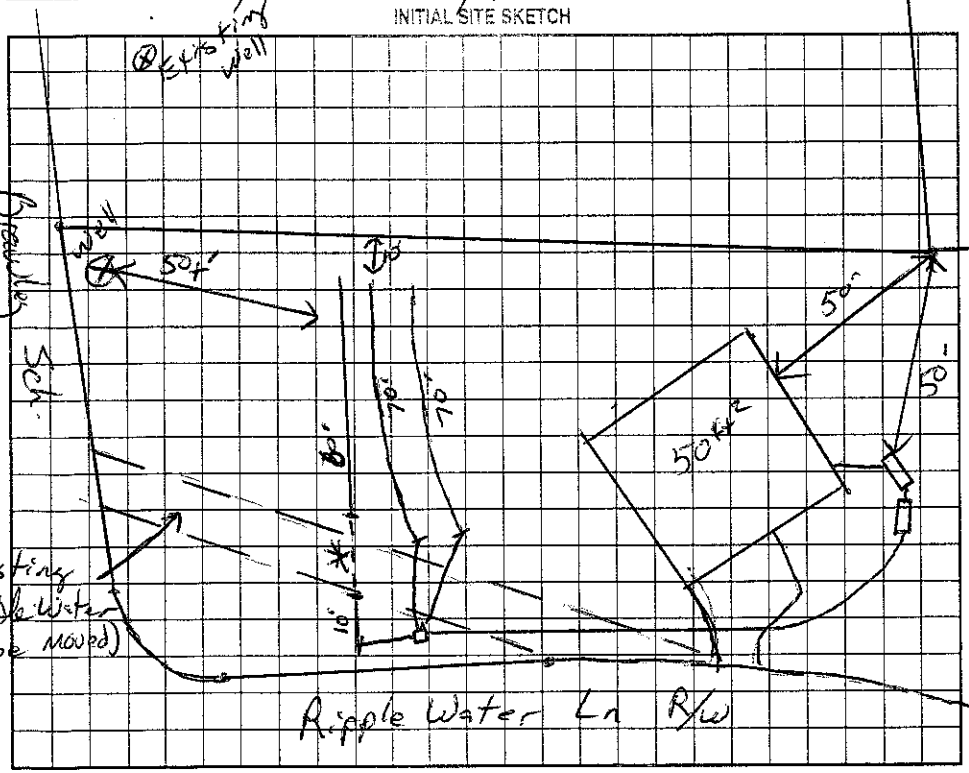

AS BUILT SKETCH

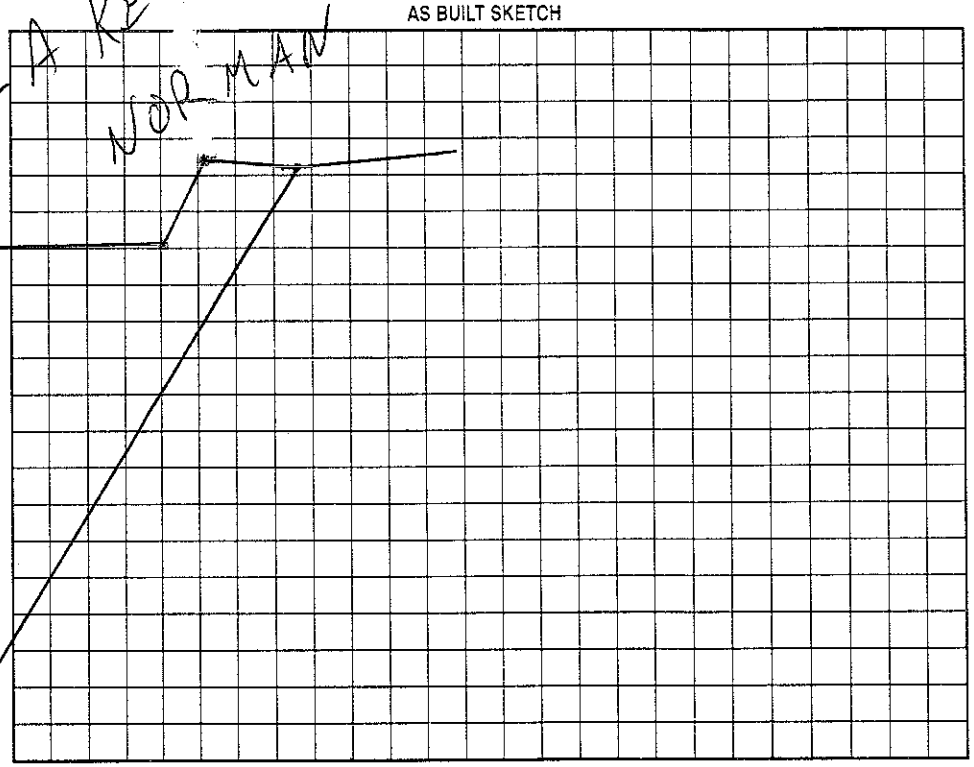

Permit can be suspended or revoked if any false information is supplied toward securing the permit/any unauthorized changes are made to the site/any unauthorized changes are made in the installation of the system. Improvement Permit with plat valid without expiration. Improvement Permit with site plan valid for sixty months. Authorization to Construct is valid for a period equal to that of Improvement Permit – not to exceed sixty months.

Signed: date 8-19-02 Installed by: Barger Septic

Improvement Permit by: LS date 8/14/02 Operation Permit by: RS date 11/28/05

Authorization to Construct by: RS date 5/20/05 Existing System Inspection by: date

HEALTH DEPT. COPY: WHITE OWNER COPY (FINAL): YELLOW OWNER COPY (INITIAL): PINK