IREDELL COUNTY HEALTH DEPARTMENT

STATESVILLE 704-878-5305 50.00 Paid MOORESVILLE 704-664-5281

IMPROVEMENT PERMIT / AUTHORIZATION TO CONSTRUCT / OPERATION PERMIT / EXISTING SYSTEM INSPECTION

PERMIT# 10962 PIN# 4624 23 6634 DATE 3/30/04

OWNER OR CONTRACTOR Carl Peggs PHONE: Business Home 704-907-8130

ADDRESS 106 Victoria Ln. Mooresville, NC. 28117

LOCATION 2585 Brawley School on (L) just before Ripple Water Ln.

SUBDIVISION C L + T BLOCK / SECTION lo LOT 466 LOT AREA .87 SITE CLASS. PS DESIGN FLOW 480 L.T.A.R. .3

Septic Tank: 1000 Gallons; STB 794 Date 7/25/05

Pump Tank: 1000 Gallons; PT 27 Date 6/7/05

Pump Make: GOULDS Model Serial No.

Nitrification Field: No Fields 1 Square Feet 1200 Linear Feet 400

No Lines 3@133' Trench Width 3' Max Trench Bottom Depth 3'

☒ New System ☐ Repair System Type: I, II, (III) IV, V, VI

System Description: PM to Type 3

Repair System Description: < 1983 Recording

Maintenance Agreement Required: ☐ Yes ☒ No

Gravel Depth No

☒ House/Mod. Home No. Bedrooms 4

☐ Mobile Home No. Bathrooms 3

☐ Business No. Employees

☐ Other


☐ Slab ☐ Crawl Space ☒ Basement w/plumbing ☐ Basement wo/plumbing

Water Supply: ☒ Individual ☐ Public ☐ Community

Comments:/Conditions: Tight, no changes are to be made without ICHD authorization.

Comments:/Conditions:

INITIAL SITE SKETCH

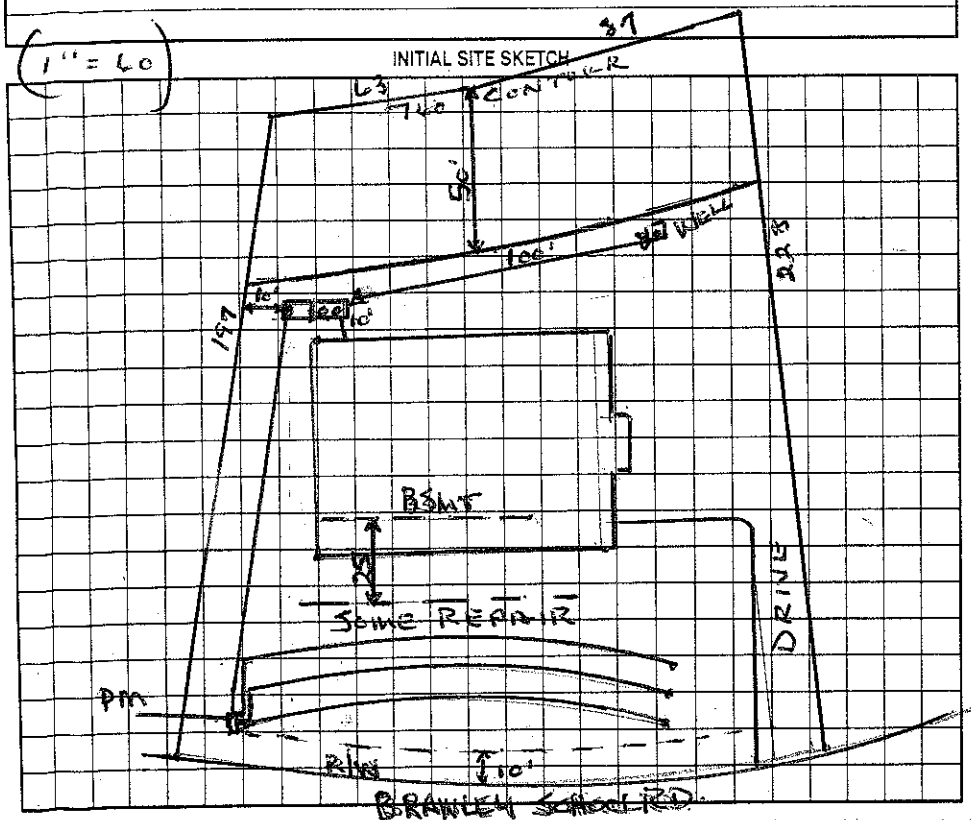

AS BUILT SKETCH

Installed 4 @ 120'

Quick 4 Infiltrator

Permit can be suspended or revoked if any false information is supplied toward securing the permit/any unauthorized changes are made to the site/any unauthorized changes are made in the installation of the system. Improvement Permit with plat valid without expiration. Improvement Permit with site plan valid for sixty months. Authorization to Construct is valid for a period equal to that of Improvement Permit – not to exceed sixty months.

Signed: X date 3/31/04 Installed by: Penwarden

Improvement Permit by: Wesley Sparks RS date 3/30/04 Operation Permit by: Wesley Sparks RS date 7/15/06

Authorization to Construct by: Wesley Sparks RS. date 3/30/04 Existing System Inspection by: date

HEALTH DEPT. COPY: WHITE OWNER COPY (FINAL): YELLOW OWNER COPY (INITIAL): PINK